


NOTE: OFFSET DISTANCES ARE MEASURED FROM THE GRADE LINE.

# NORTHBOUND CROSS SECTIONS

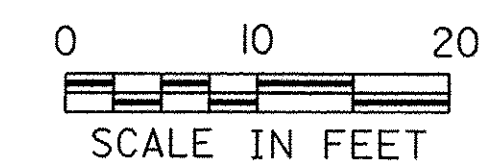

PROJECT: FAIRFAX - FAIRFIELD - ST. ALBANS	PROJECT NO.: IM 089-3(27)
DESIGN FILE NAME: /87A007B/DESIGN/DA007XSLDGN	PLOT DATE: 08-MAR-2002
IPARM FILE NAME: DA007X20	SURVEY DATE: 6/98
SURVEYED BY: ORVIS	DRAWN BY: SQUAD B
SQUAD LEADER: DELLA SANTA	SHEET: 359 OF 370