


DRILLING & BLASTING OF SOLID
ROCK SUBGRADE, ITEM 115
NB 3273+00-3277+00
SB 3272+00-3284+00
NB 3279+00-3284+00
SB 3274+01-3282+50 Rest Area
NB 3280+15-3283+00

PROPERTY LINE FENCE W/ STEEL POSTS, MOD
Item 583-II
SB 3268+00-3284+00 LT
NB 3268+00-3284+00 RT

* JUTE MATTING-ITEM 623
SB 3268+00-3270+50 RT
SB 3283+00-3284+00 LT

INDIVIDUAL WATER SOURCES
DUG SPRING S.B.L. 3274+ - 700' ± LT
WATER POOL S.B.L. 3279+ - 700' ± LT
NOTE: * DENOTES ITEMS TO BE INCLUDED IN STAGE II CONSTRUCTION

REV S.B.
A 3°19'00" LT
D 0°15'00" V
R 22918.82
T 668.52
L 1326.67
E 9.51
Bank 1/4" per ft.

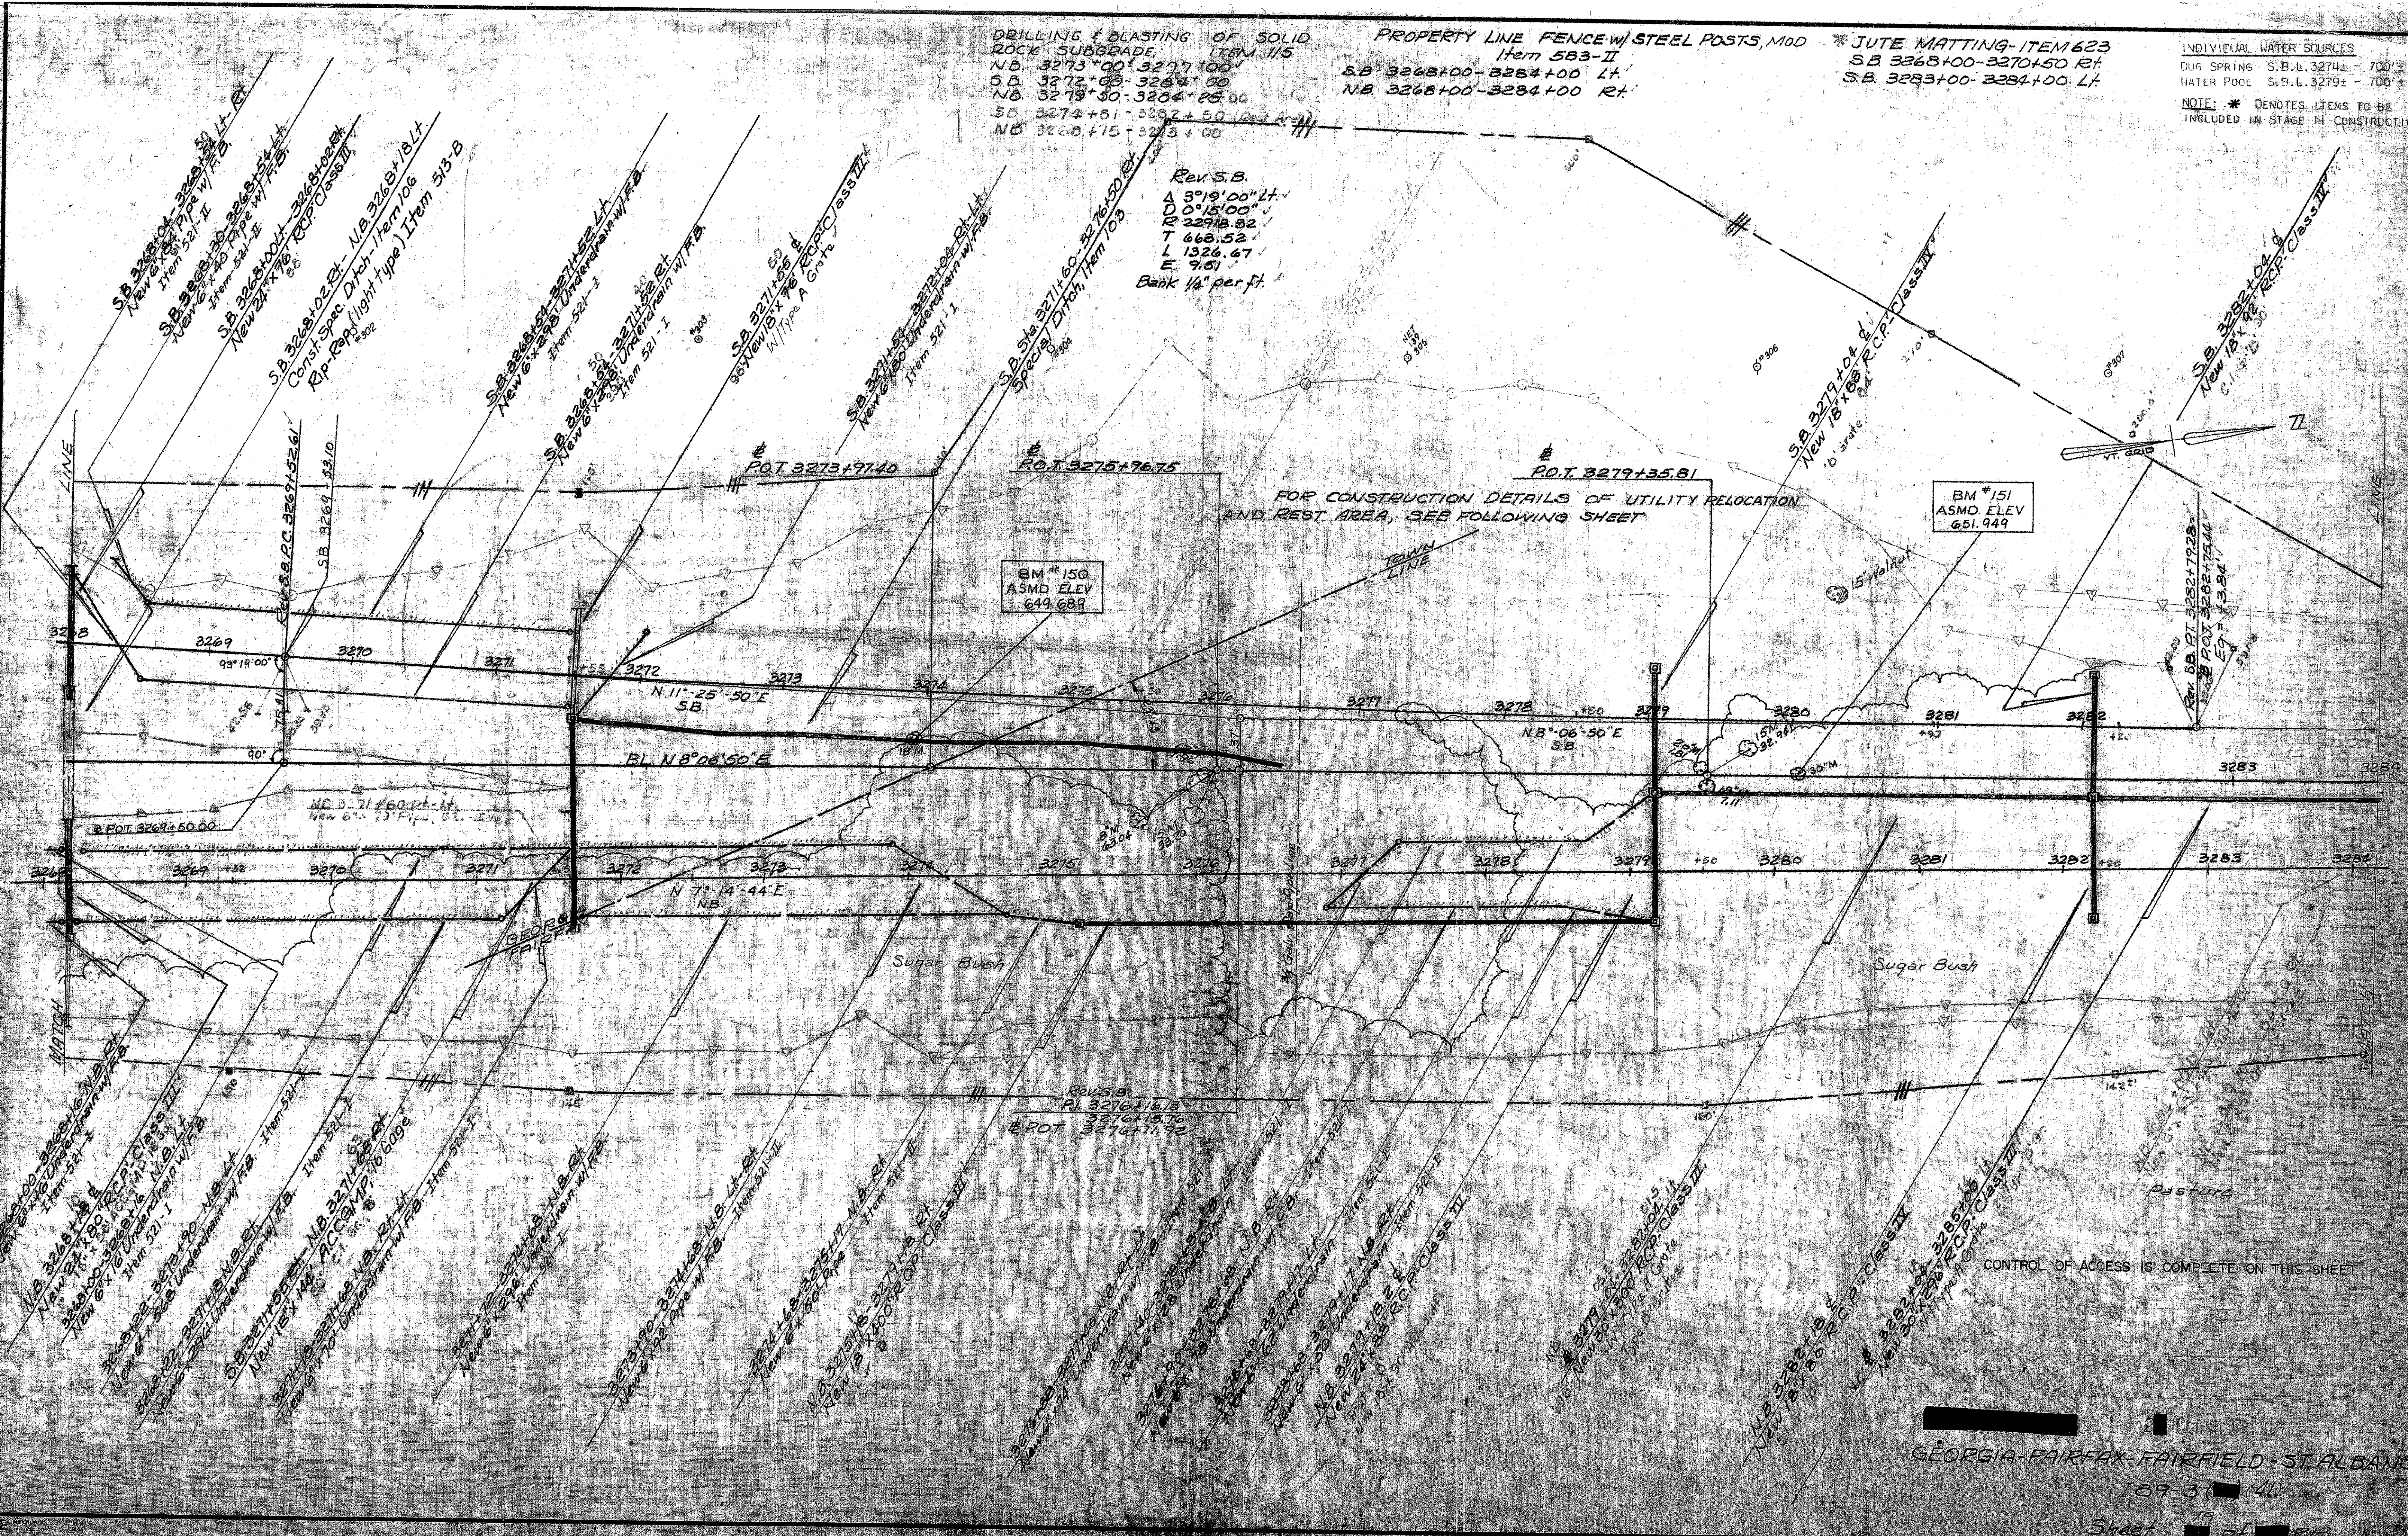

REV S.B.
Rt 3276+14.13
3276+15.76
POT 3276+11.92

BM #151
ASMD ELEV
651.949

BM #150
ASMD ELEV
649.689

CONTROL OF ACCESS IS COMPLETE ON THIS SHEET

GEORGIA FAIRFAX FAIRFIELD ST ALBANS

189-3(14)

Sheet 15 of 213

STA. 3268 = MM 110.78

PLAN SURVEYED BY
PLANNED BY
NOTED BY
DRAWN BY
CHECKED BY
DATE