

PLAN	SURVEYED	BY	DATE
note book	PLOTTED	Spaulding	1962
	ALIGNMENT CHECKED	Cooley	
NO	ROW CHECKED		
	TRACED	EWELL	2/63

N.B. 3299+34 - 3300+00 Rf

JUTE MATTING-ITEM 623
S.B 3284+00-3287+00 LT
N.B 3285+00-3288+00 RT
N.B 3285+00-3288+00 LT
N.B 3299+00-3300+00 LT

ST. ALBANS CITY WATER
BL 3297+60 ASK - BL AS
561-8286 - 550 ± LT.
Rev N.O.
Δ 4° 36' 42" LT
D 0° 14' 08"
R 24 323 2311
T 979.42
L 1757.79
E 19.71
Bank 1/4 Per ft. R.C.

NOTE: * DENOTES ITEMS TO BE INCLUDED IN STAGE II CONSTRUCTION

Curve Data

A 5°29'00" L/R

D 0°13'00"

R 22918.32

T 1097.46


L 2193.33

E 26.13

■ STD. STEEL BEAM GUARD
 RAIL W/STEEL POSTS ITEM 545-A (63' c/c)
 11" x 104 29/32" - 30" 15 L } Stage I Constr
 11" x 104 29/32" - 30" 15 R }
 * S.B. 3296 + 31 L - N.B. 3296 + 17 L } Stage II
 * S.B. 3298 + 17 R - N.B. 3298 + 30 L } (63' c/c)

* Construct U Turn
3288+50

CONTROL OF ACCESS IS COMPLETE ON THIS SHEET

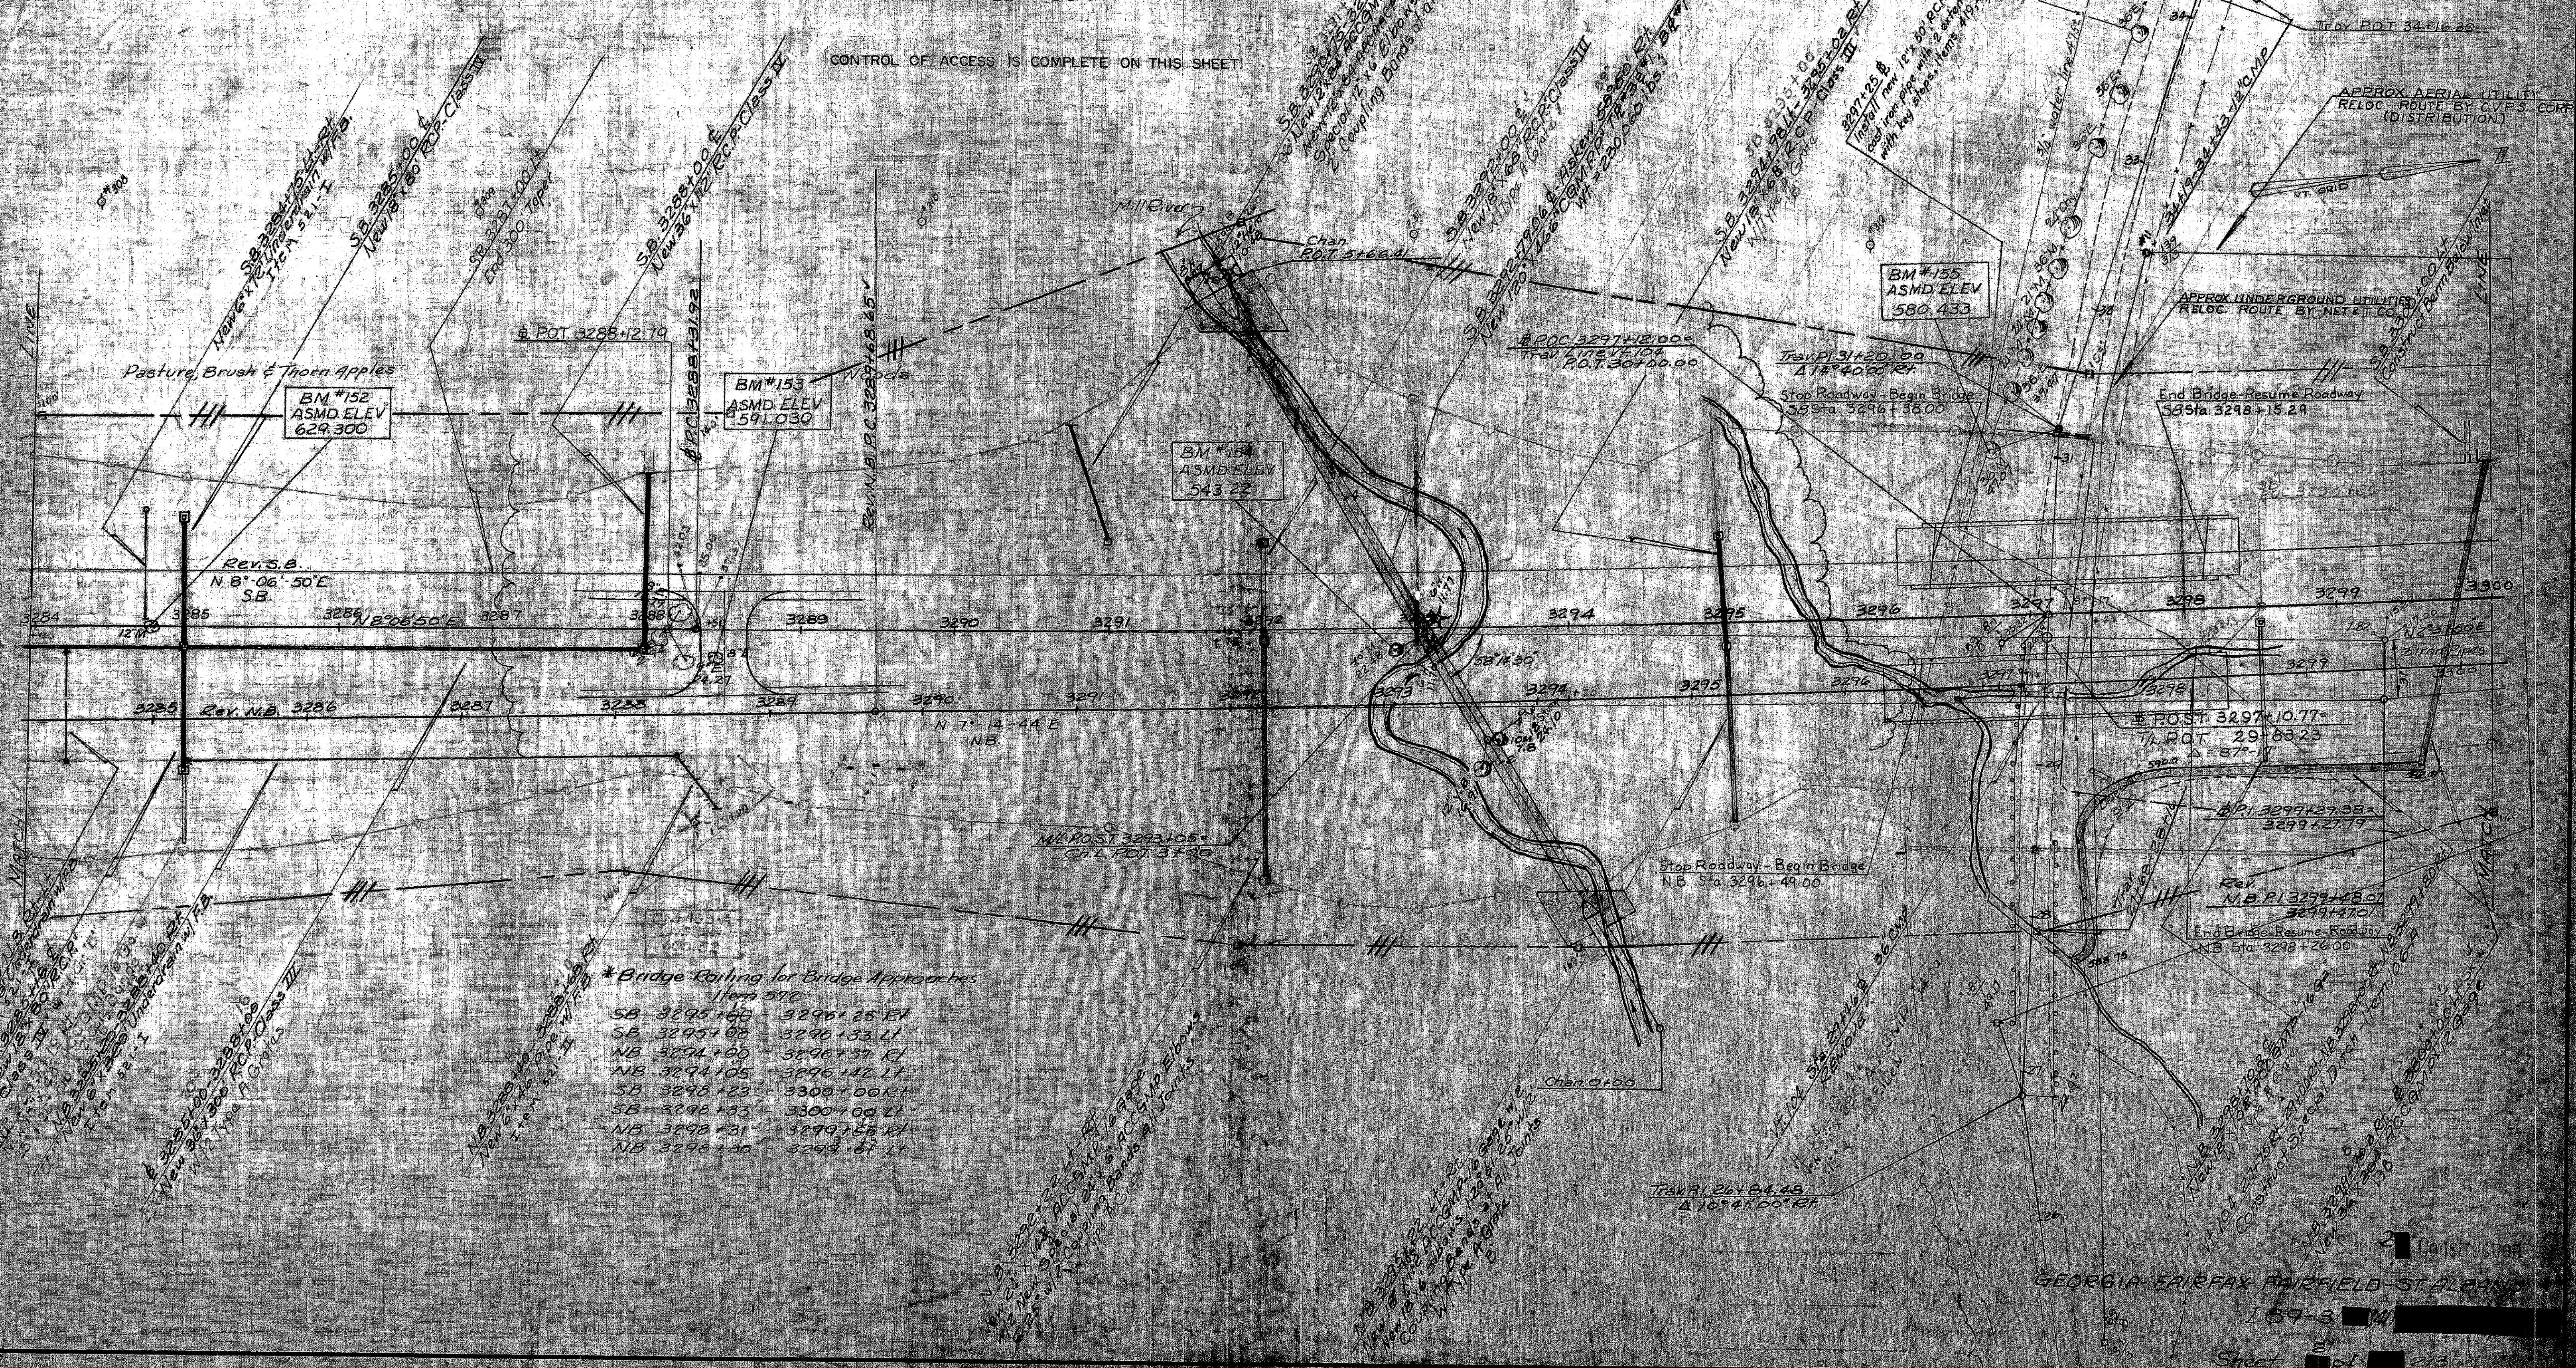

GEORGIA FAIRFAX FAIRFIELD-STALBAN

189-3 [redacted] [redacted]

Sheet 3 of 21

STA 3284 = MM 111.08