

DIPRAP (light type) Item 513-B
S.B. 3329+51 - 3329+59 Rt.



*THREE CABLE GUARD RAIL
W/STEEL POSTS, ITEM 542
N.B. 3321+02 - 3332+00 Lt.
S.D. 3325+05 - 3332+00 Lt.

PROPERTY LINE FENCE W/STEEL POSTS,
MOD. Item 583 II
S.B. 3316+00 - 3332+00 Lt.
N.B. 3316+00 - 3332+00 Rt.

INDIVIDUAL WATER SOURCES
POND S.B.L. 3317± - 1100± Lt.

NOTE: * DENOTES ITEMS TO BE INCLUDED
IN STAGE II CONSTRUCTION.

CONTROL OF ACCESS IS COMPLETE ON THIS SHEET.

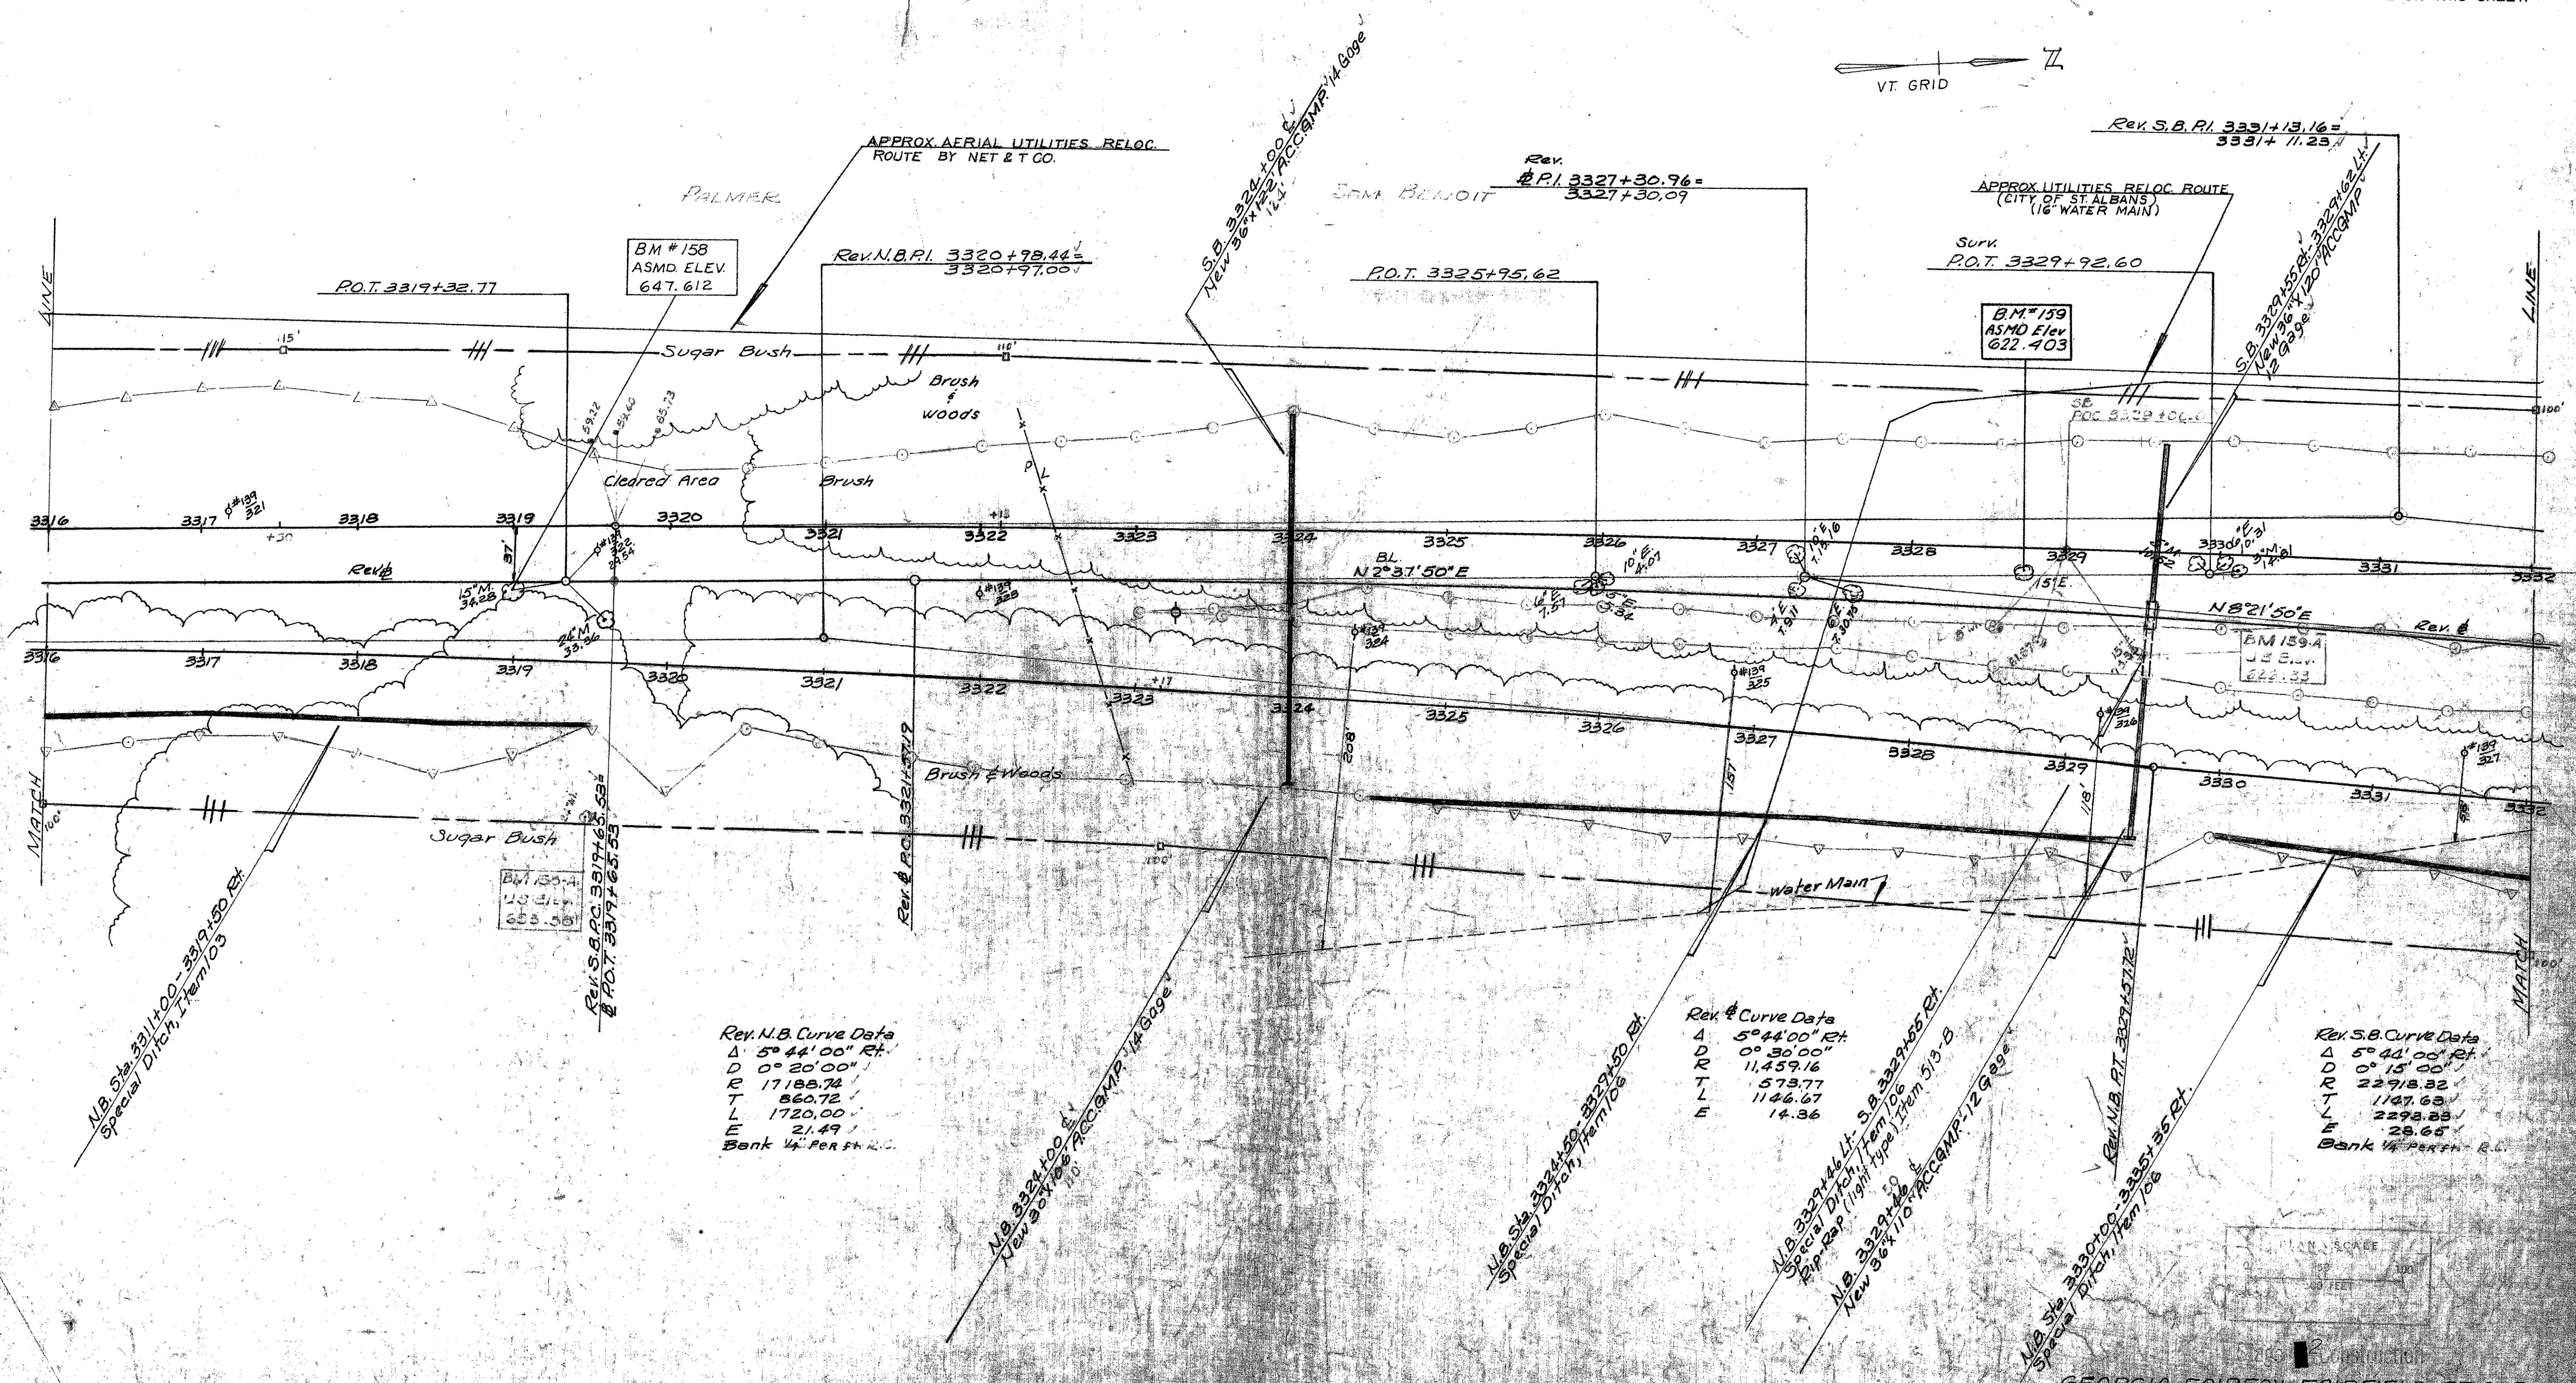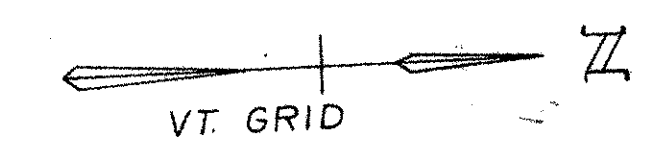

Rev. N.B. Curve Data
Δ 5° 44' 00" Rt.
D 0° 20' 00" Lt.
R 17188.74
T 860.72
L 1720.00
E 21.49
Bank 1/4" Per Ft. R.C.

Rev. S.B. Curve Data
Δ 5° 44' 00" Rt.
D 0° 15' 00" Lt.
R 22918.82
T 1147.63
L 2298.83
E 28.65
Bank 1/4" Per Ft. R.C.

Rev. S.B. Curve Data
Δ 5° 44' 00" Rt.
D 0° 15' 00" Lt.
R 22918.82
T 1147.63
L 2298.83
E 28.65
Bank 1/4" Per Ft. R.C.

GEORGIA-FAIRFAX-FAIRFIELD-ST ALBANS

189-3 (41)

Sheet 86 of 213

STA. 3316 = MM 11.69