


6+83
Butt

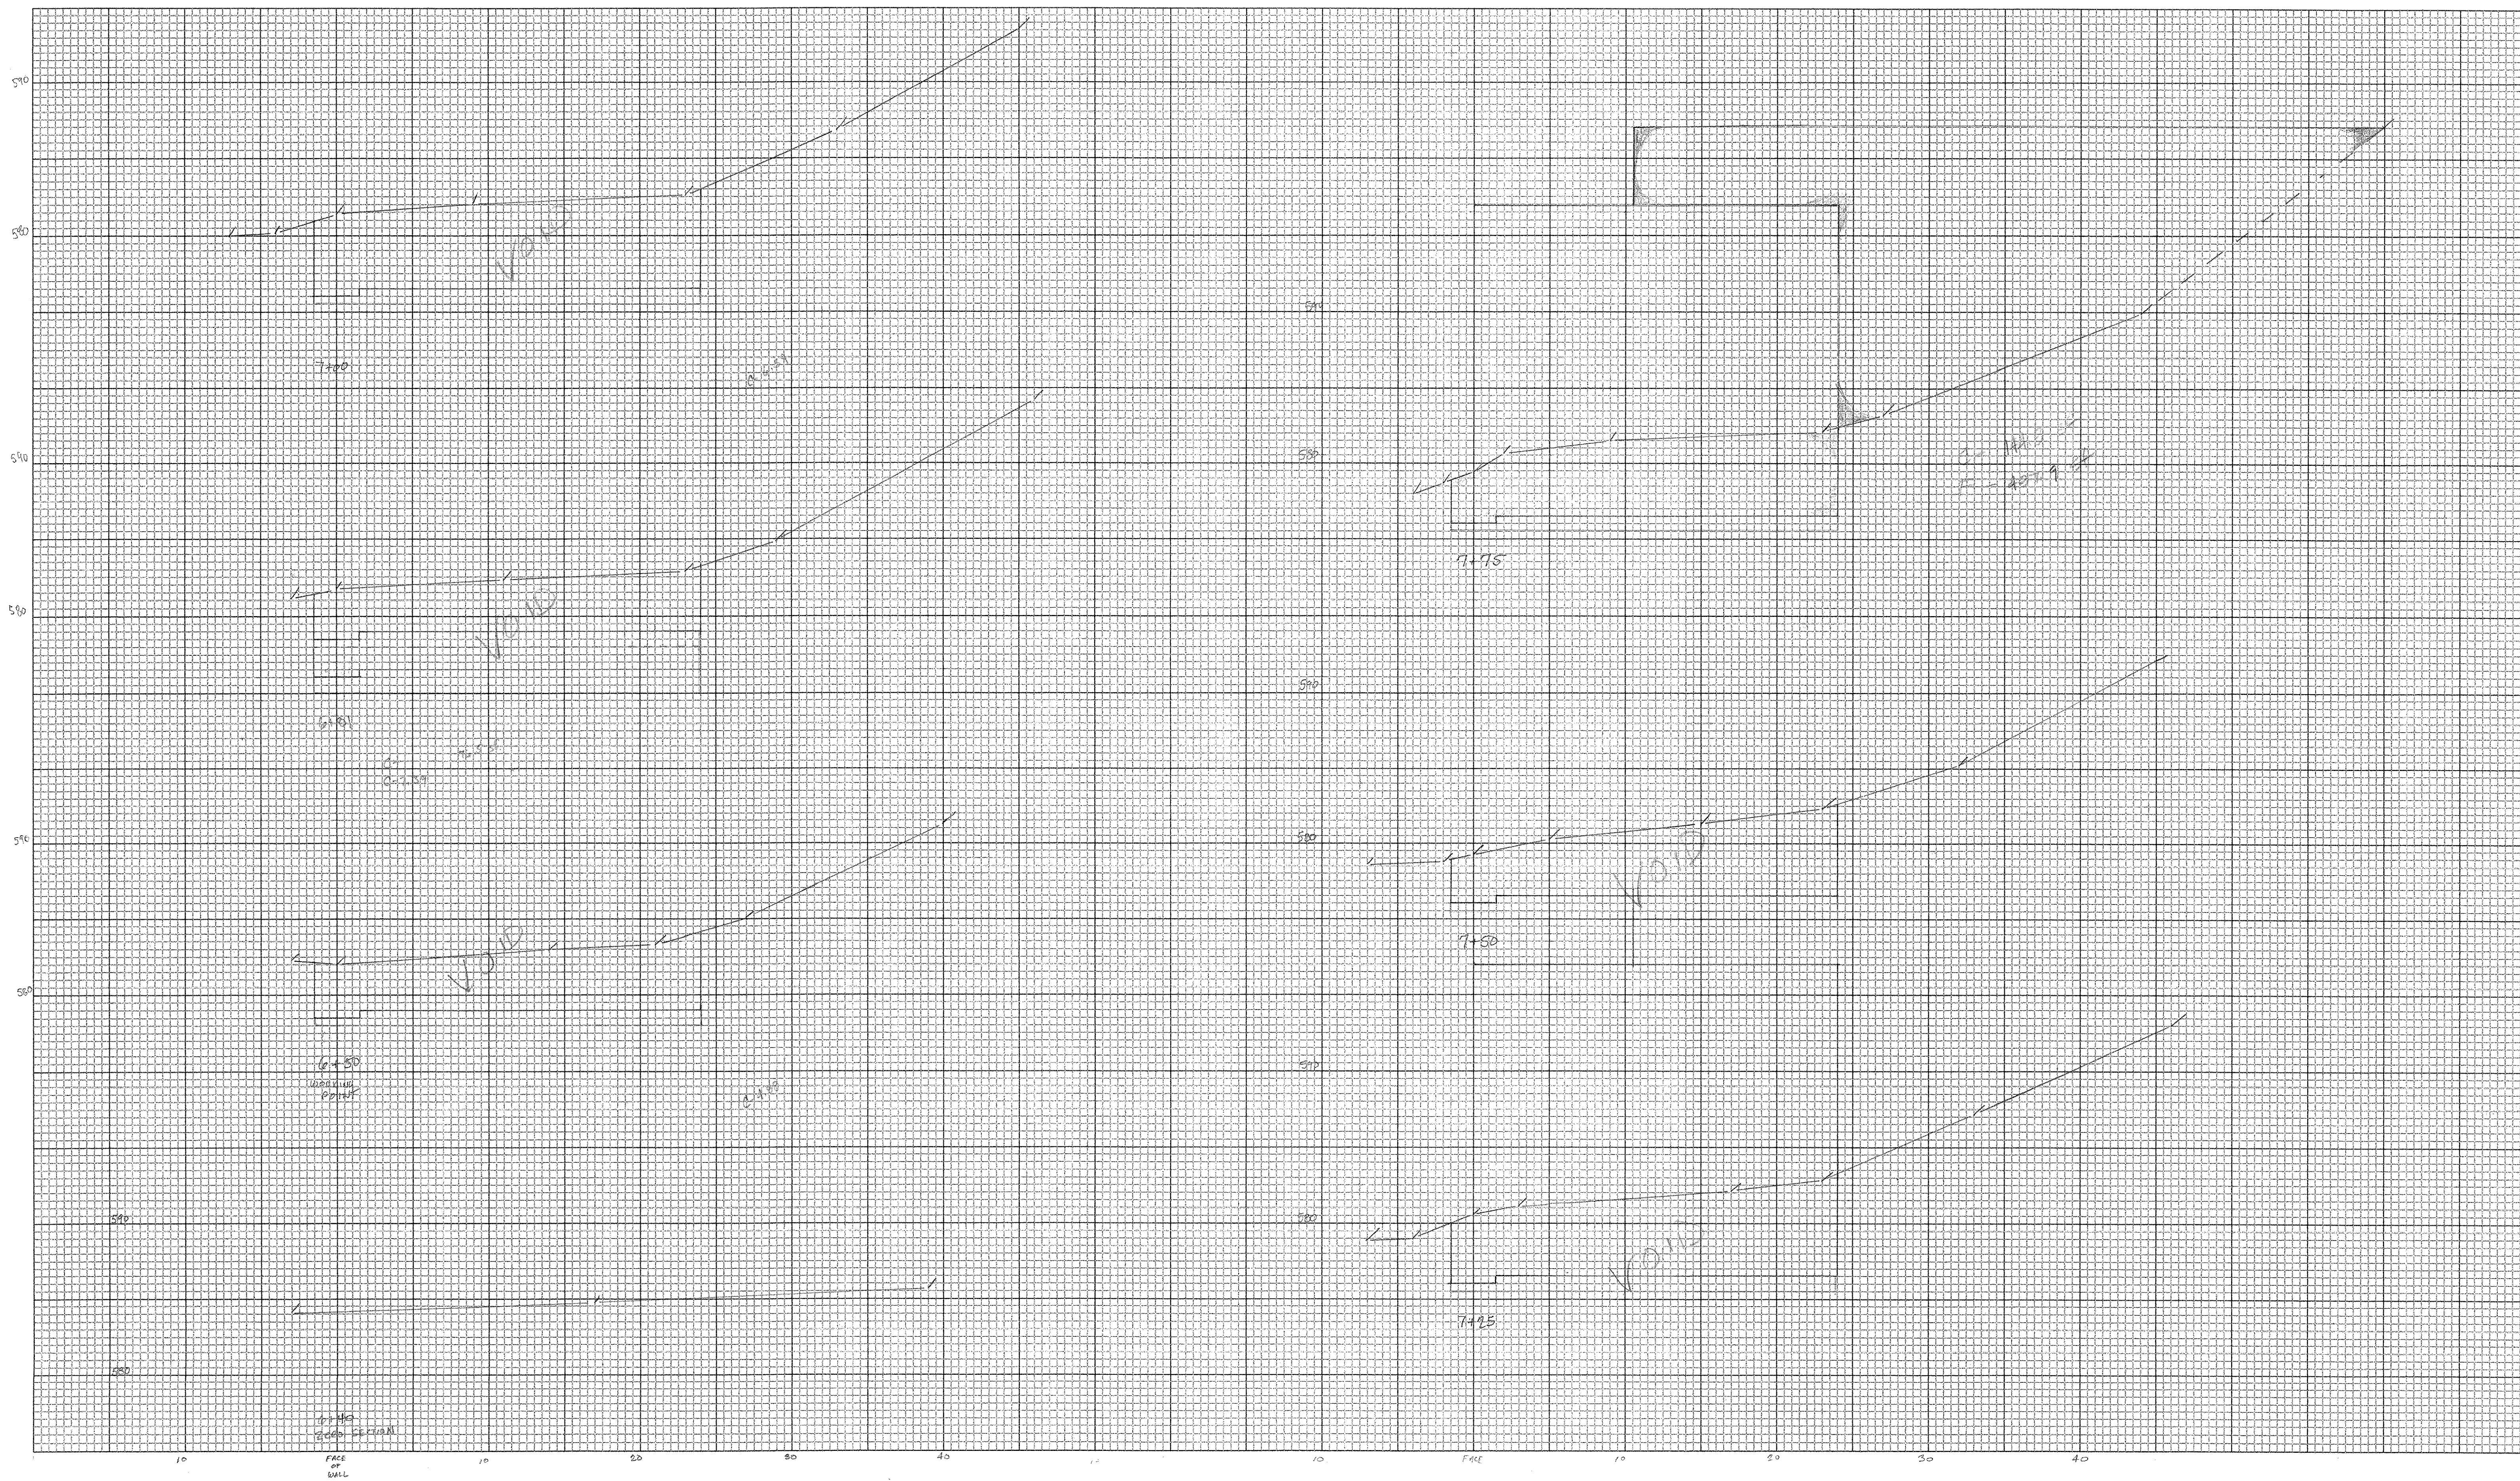

Blue - CONCRETE EXCAVATION

Green - GRANULAR FILL

CROSS SECTION SHEET

1" = 5 ft

PROJECT NAME: FAIRFAX - ST. ALBANS 2nd 039.3 (27)
PROJECT NUMBER: _____
FILE NAME: STRUCTURE EXCAVATION @ SEWELL #2
PROJECT LEADER: _____ PLOT DATE: 05-JUN-2000 09
DESIGNED BY: _____ DRAWN BY: KNP/S
CHECKED BY: 39/
const: g:/common/cadd/e-xsection.dgn SHEET 2 OF 3