



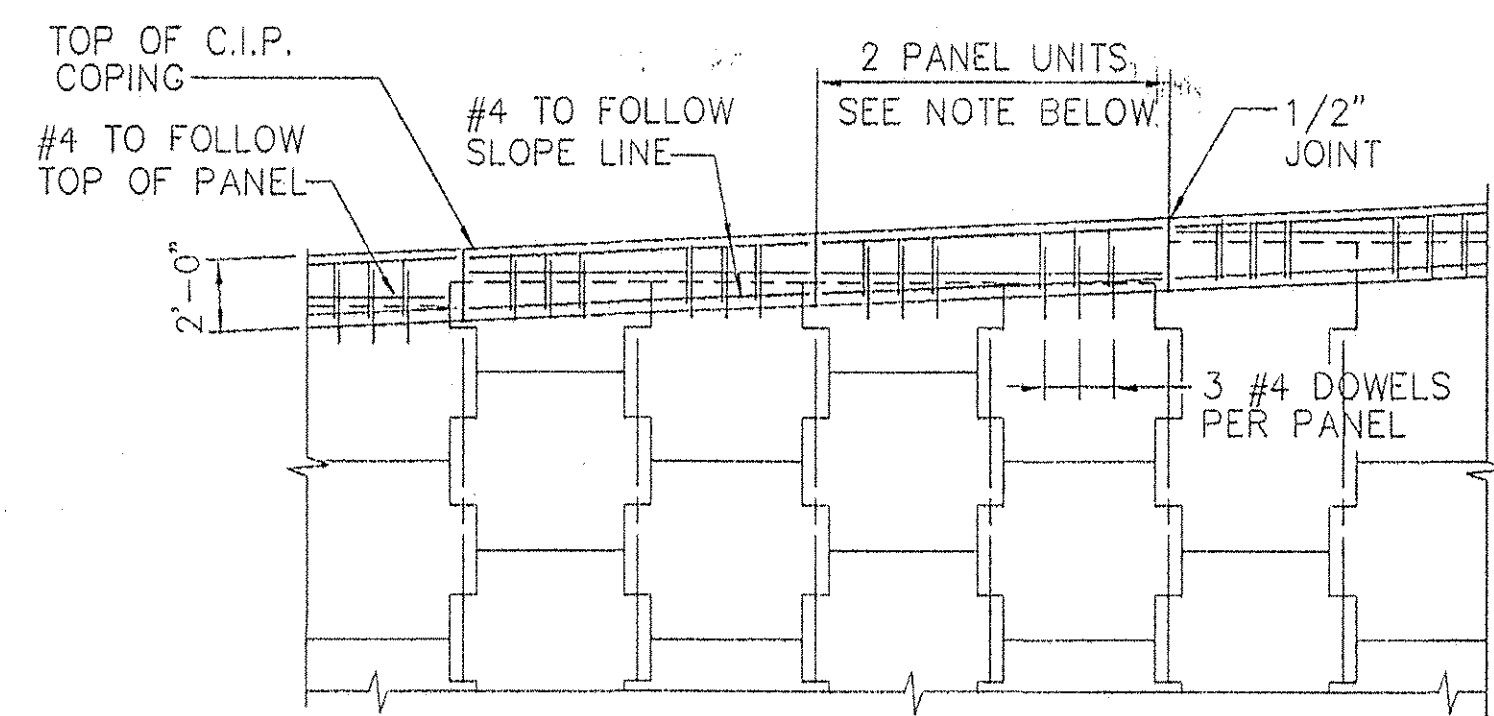

C.I.P. COPING - PARTIAL ELEVATION


SCALE: 3/16" = 1'-0"

NOTE:
JOINTS IN COPING SHALL BE AT 2 PANEL INTERVALS AND COINCIDE APPROXIMATELY WITH C.C.P. ALIGNMENT DEVICE. REINFORCING STEEL SHALL BE STOPPED 2" SHORT OF EITHER SIDE OF THE CONSTRUCTION AND EXPANSION JOINTS.

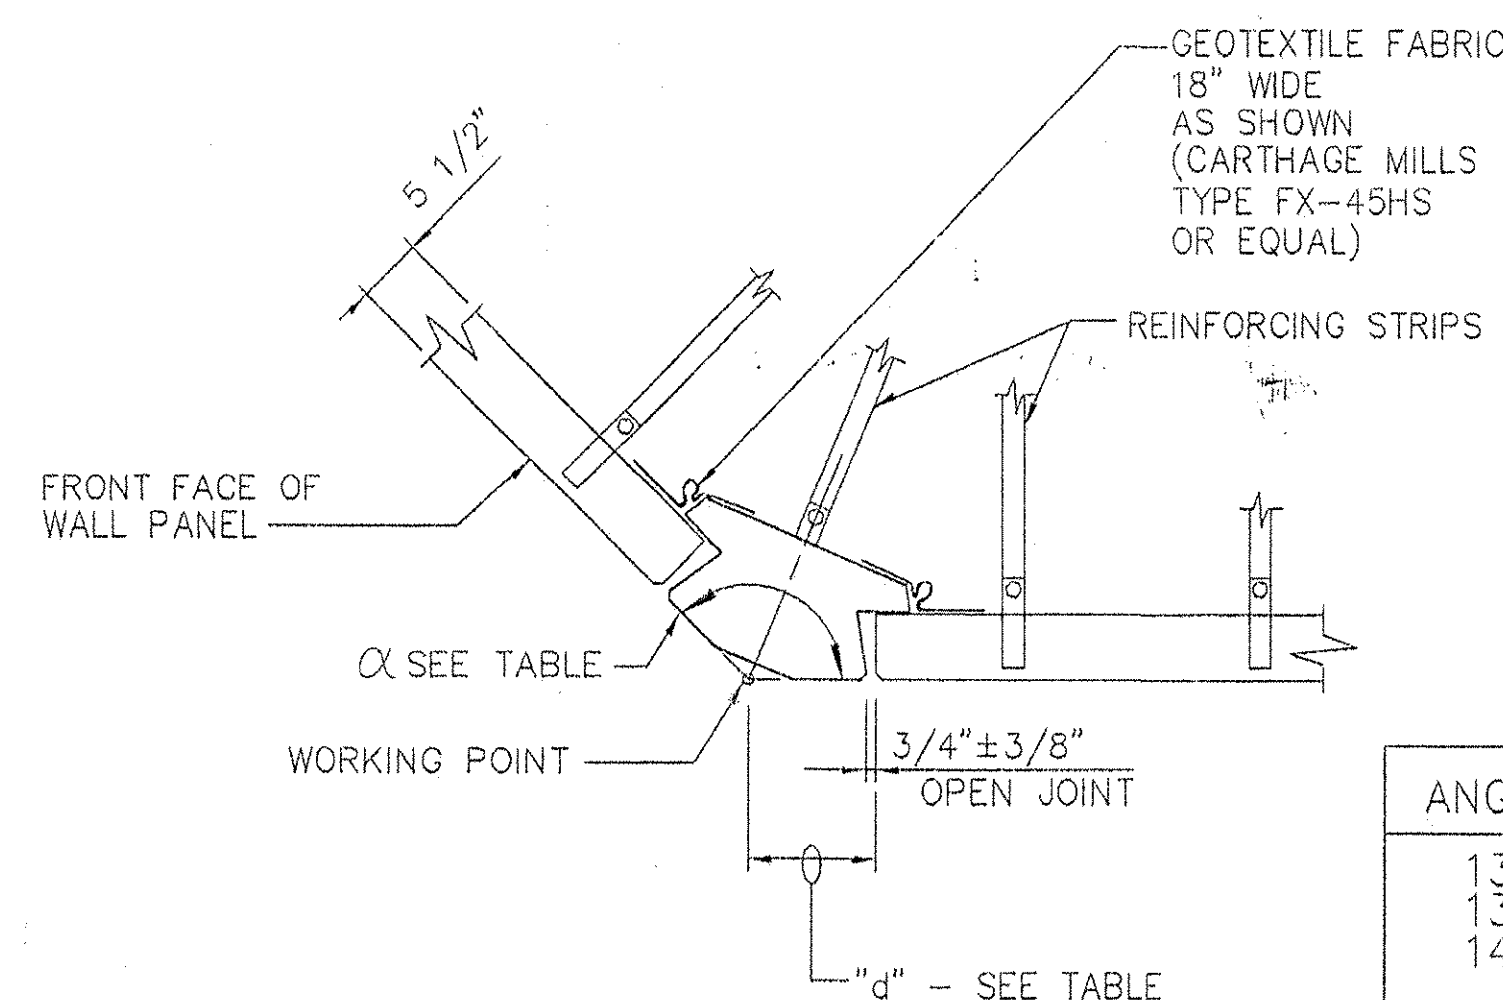


OBTUSE CORNER ELEMENT DETAIL

SCALE: 3/4" = 1'-0"

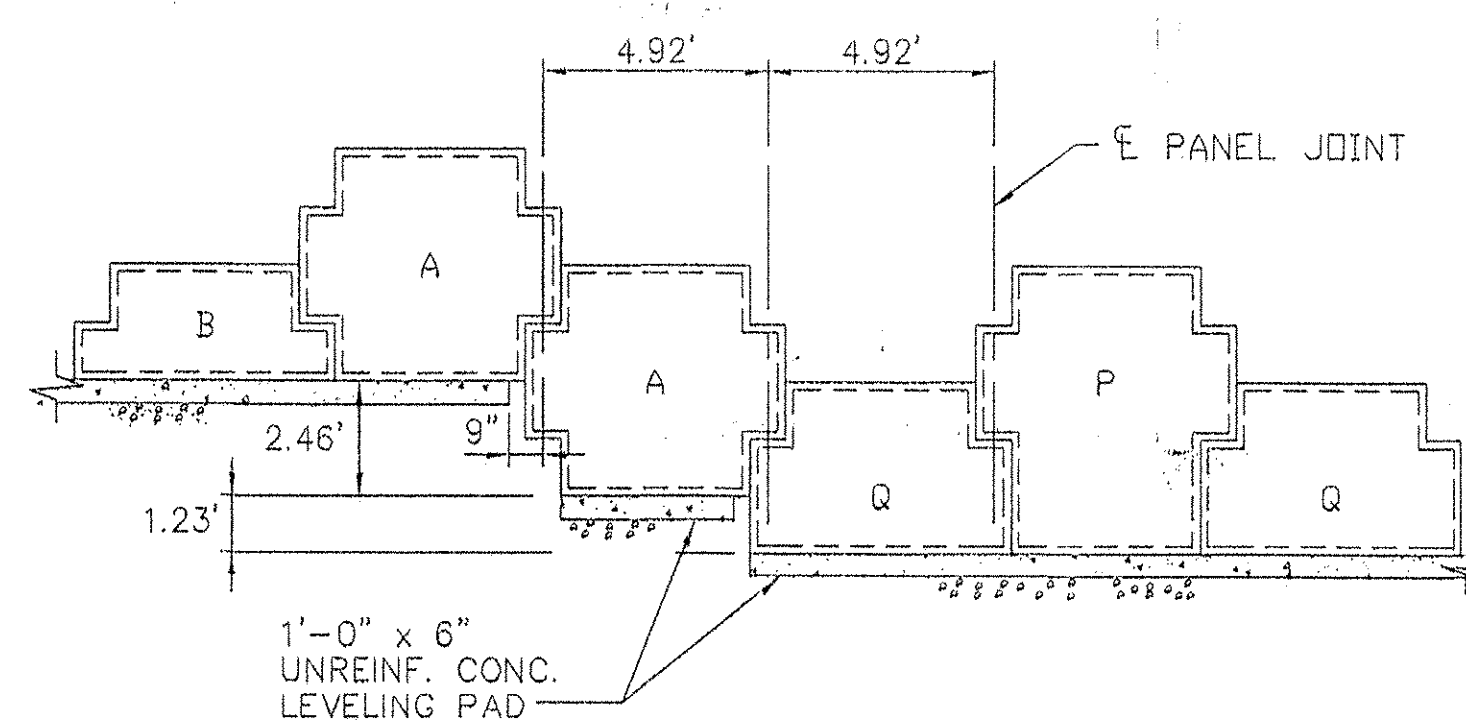


TYP LEVELING PAD STEP DETAIL

NOT TO SCALE

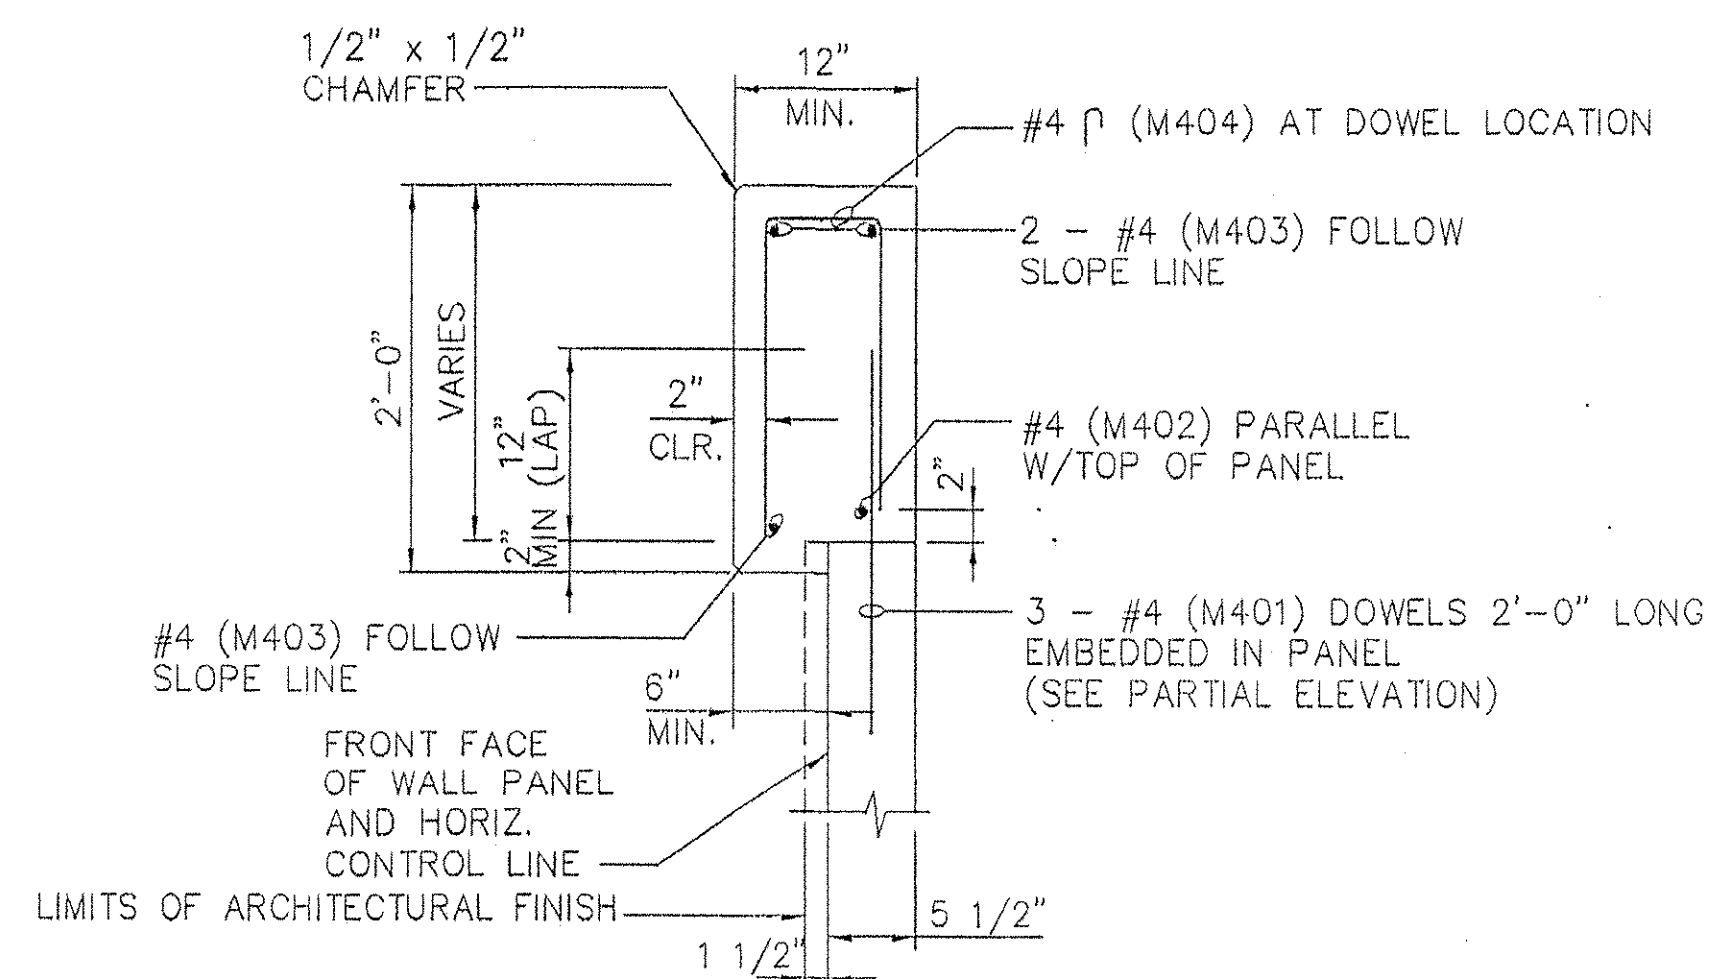


C.I.P. CONC. COPING

SCALE: 1" = 1'-0"

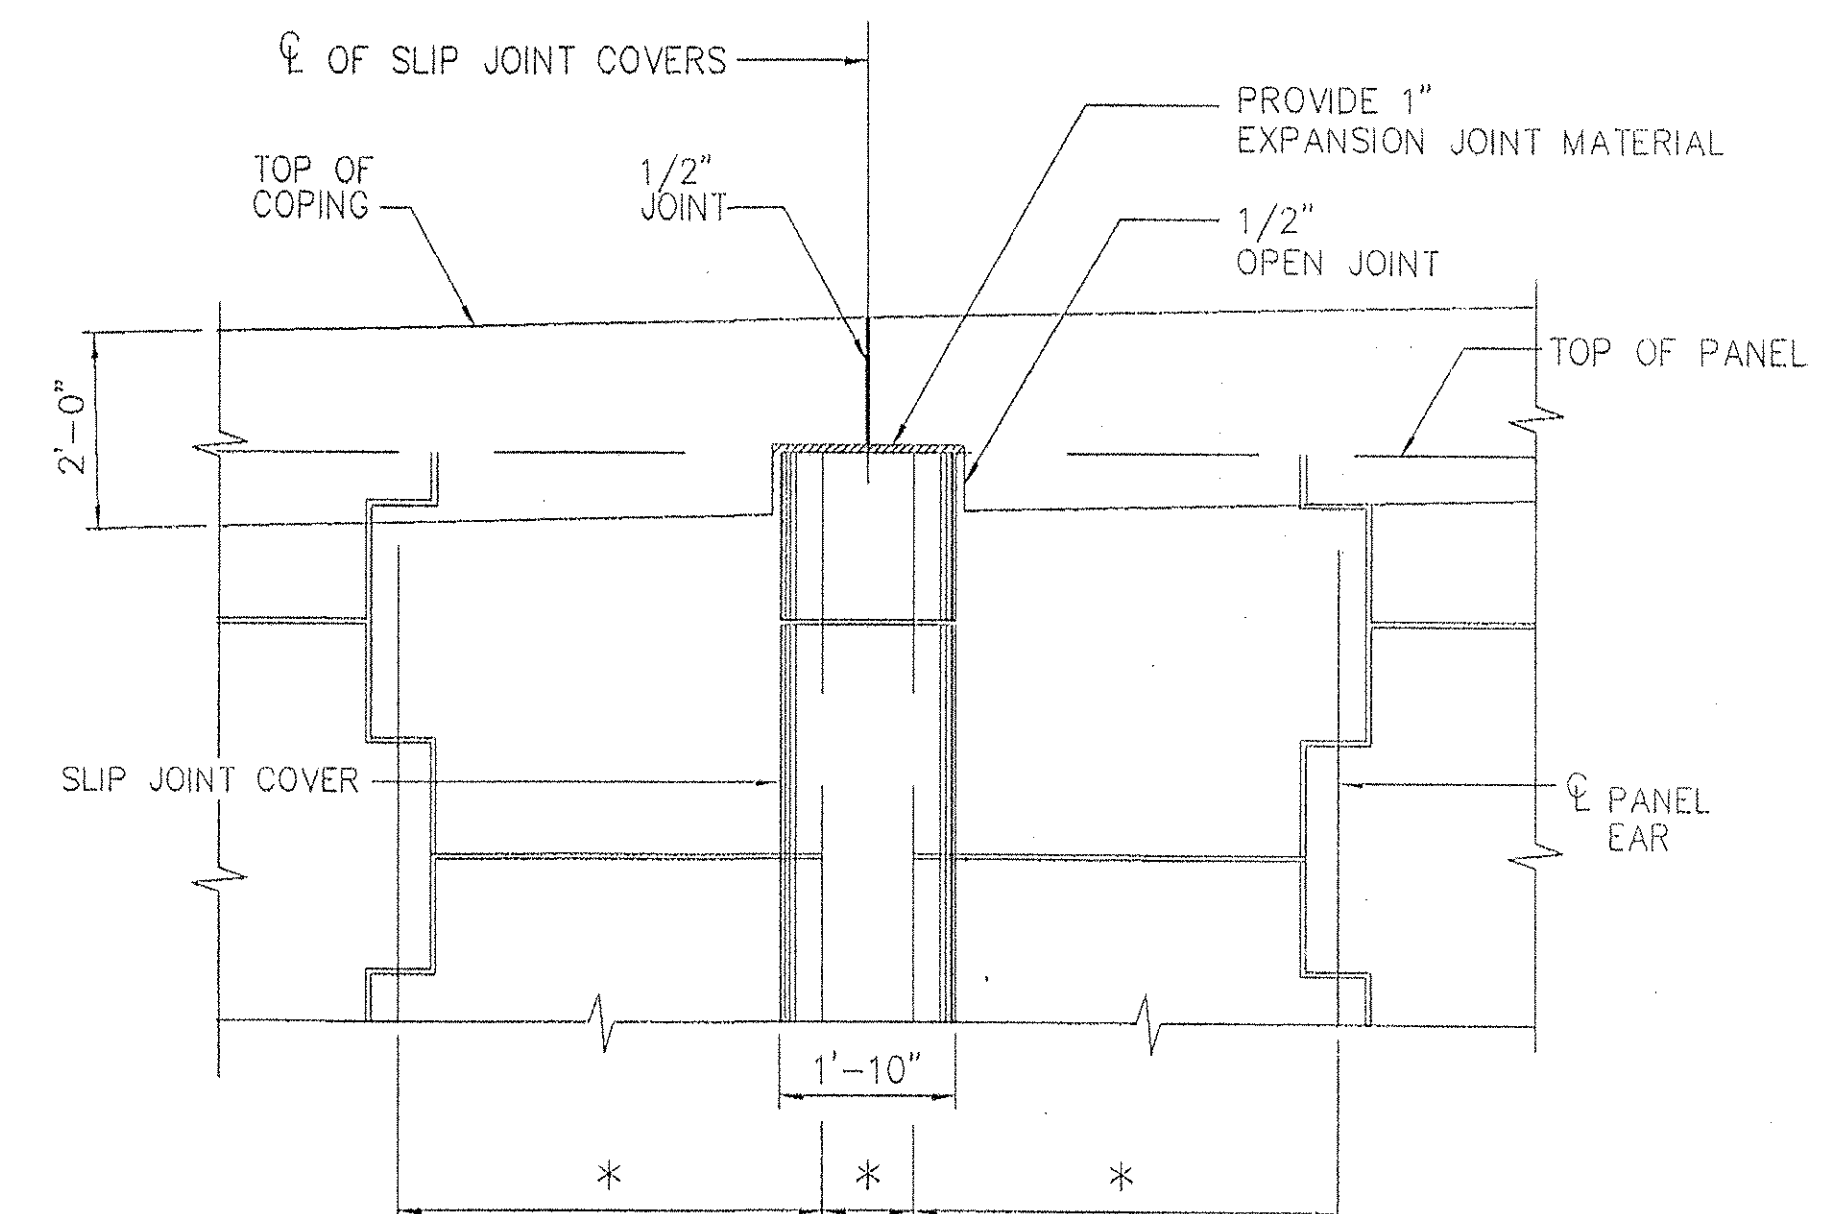


C.I.P. COPING
OVER SLIP JOINT COVER

SCALE: 1/2" = 1'-0"

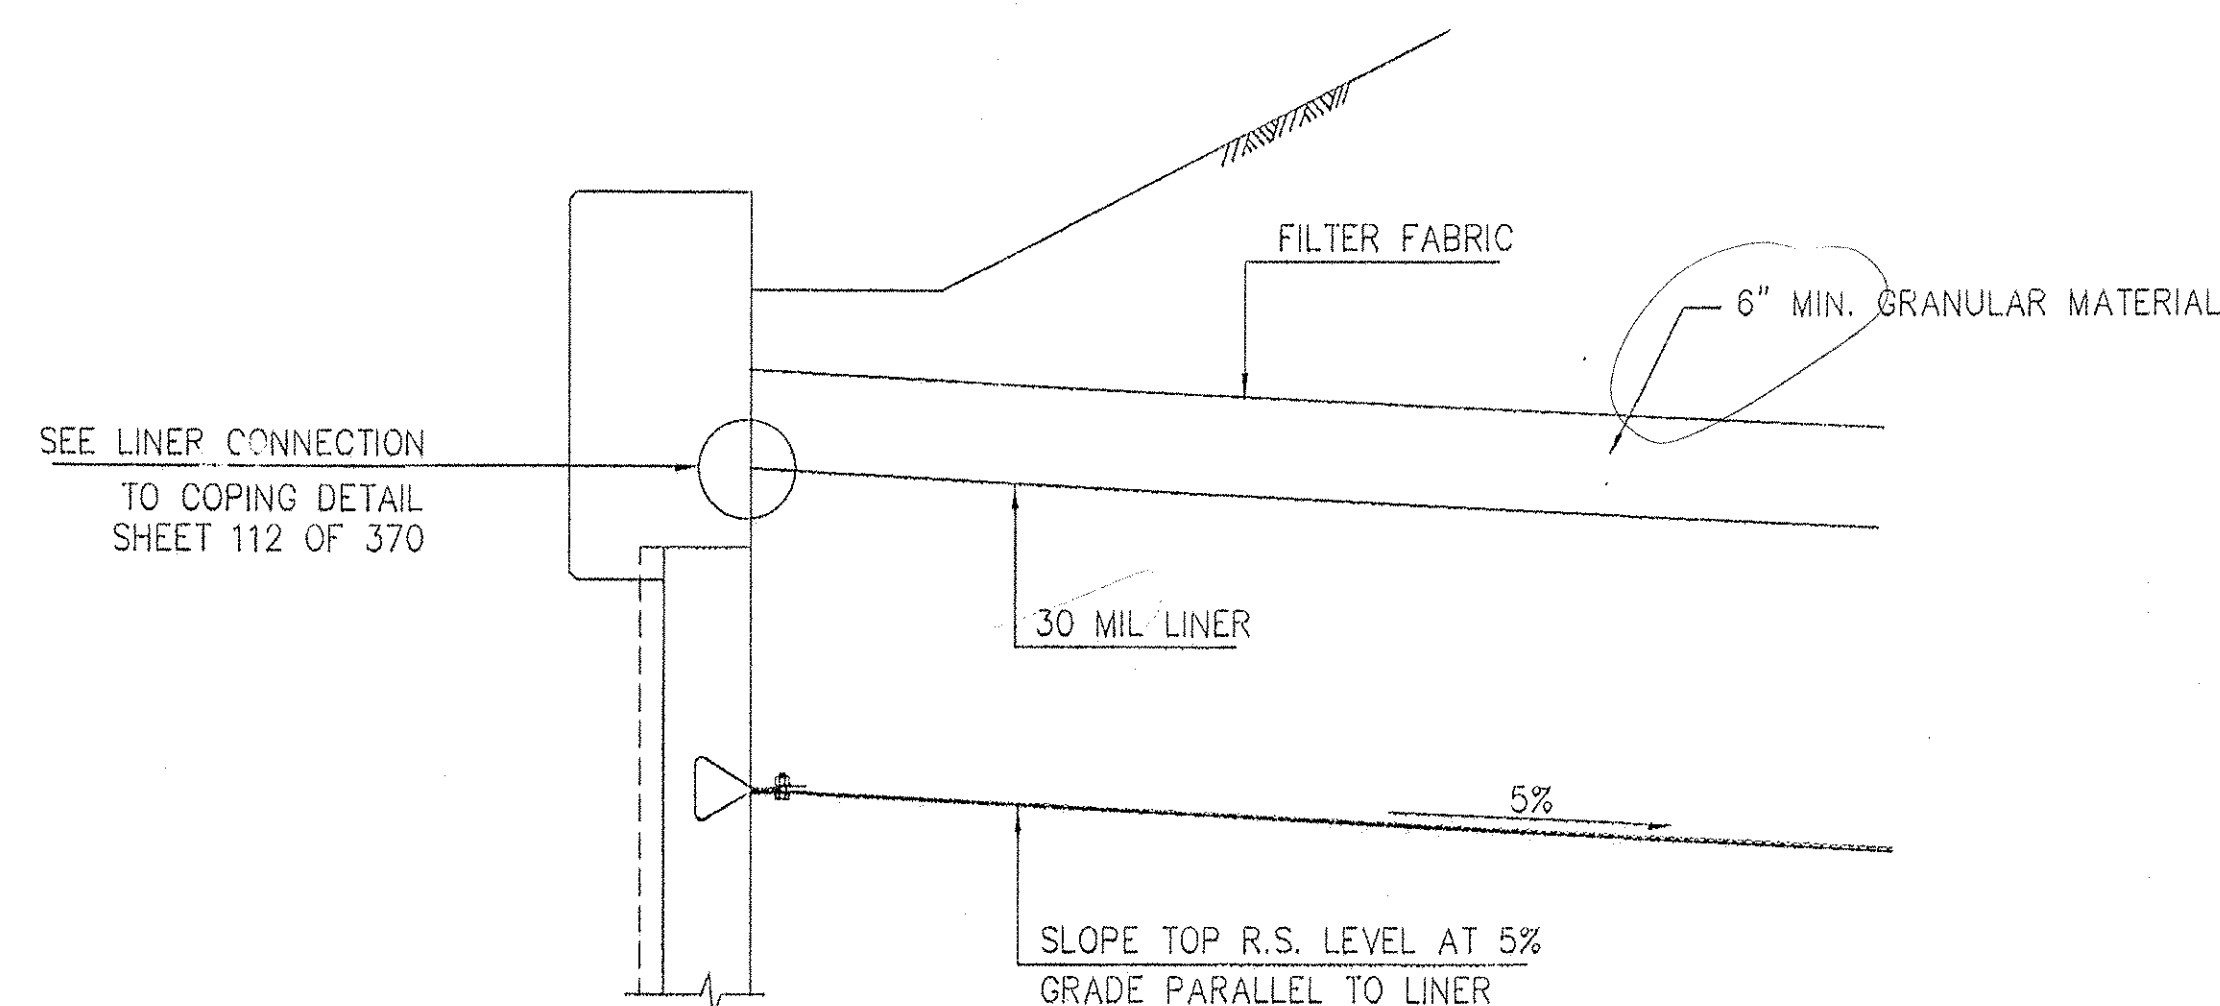

DETAIL A


SCALE: 1" = 1'-0"

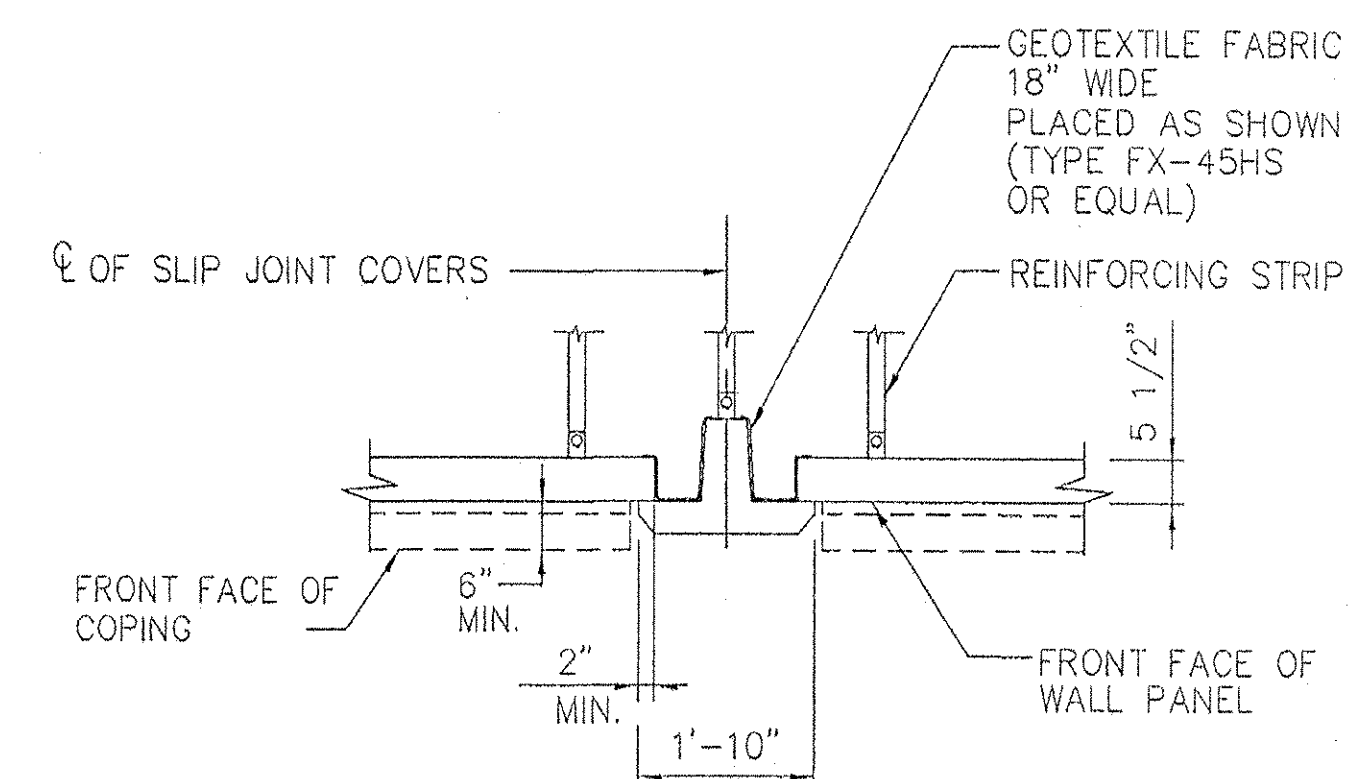

SLIP JOINT COVER DETAIL

SCALE: 1/2" = 1'-0"

CERTIFIED WITH
RESPECT TO THE
INTERNAL STABILITY
OF REINFORCED EARTH
STRUCTURES ONLY

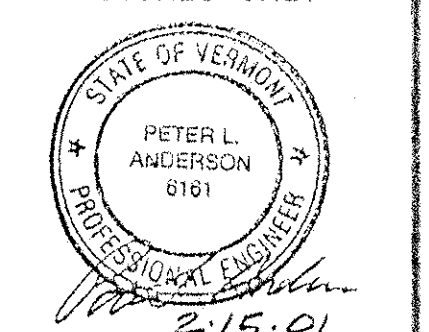

This drawing contains information proprietary to The Reinforced Earth Company, and is being furnished for the use of VERMONT AGENCY OF TRANSPORTATION only in connection with this project, and the information contained herein is not to be transmitted to any other organization unless specifically authorized in writing by The Reinforced Earth Company. The Reinforced Earth Company is exclusive licensee in the United States under patents issued to Henri Vidal, and the furnishing of this drawing does not constitute an expressed or implied license under the Vidal patents.

The design contained on these drawings is based on information provided by the owner. On the basis of this information, The Reinforced Earth Company has designed, and is responsible for the internal stability of the structure only. External stability, including foundation (bearing capacity and settlement) and slope (global) stability, is the responsibility of the owner.



The Reinforced Earth Company

6614 Westwood Center Drive Suite 1100, Vienna, Virginia 22182 (703) 821-1175

"REINFORCED EARTH" is the registered trademark of The Reinforced Earth Company.

DESIGNED BY: KPB				PROJECT NAME	FAIRFAX-FAIRFIELD-ST. ALBANS I-89 OVER VT 104	DATE 2-15-01
PROJECT ENGR: KPB				LOCATION	FAIRFAX-FAIRFIELD-ST. ALBANS VERMONT	CONTRACT NO. 9360
CHECKED BY: PLA				OWNER	VT AOT	DRAWING NO. 5 OF 6
ENG. MANAGER	REV.	DATE	DESCRIPTION	DRAWING COVERS	DETAILS	SCALE AS SHOWN

403MSE