




EAST RAILING - LOOKING WEST  
BRIDGE 88 SOUTHBOUND

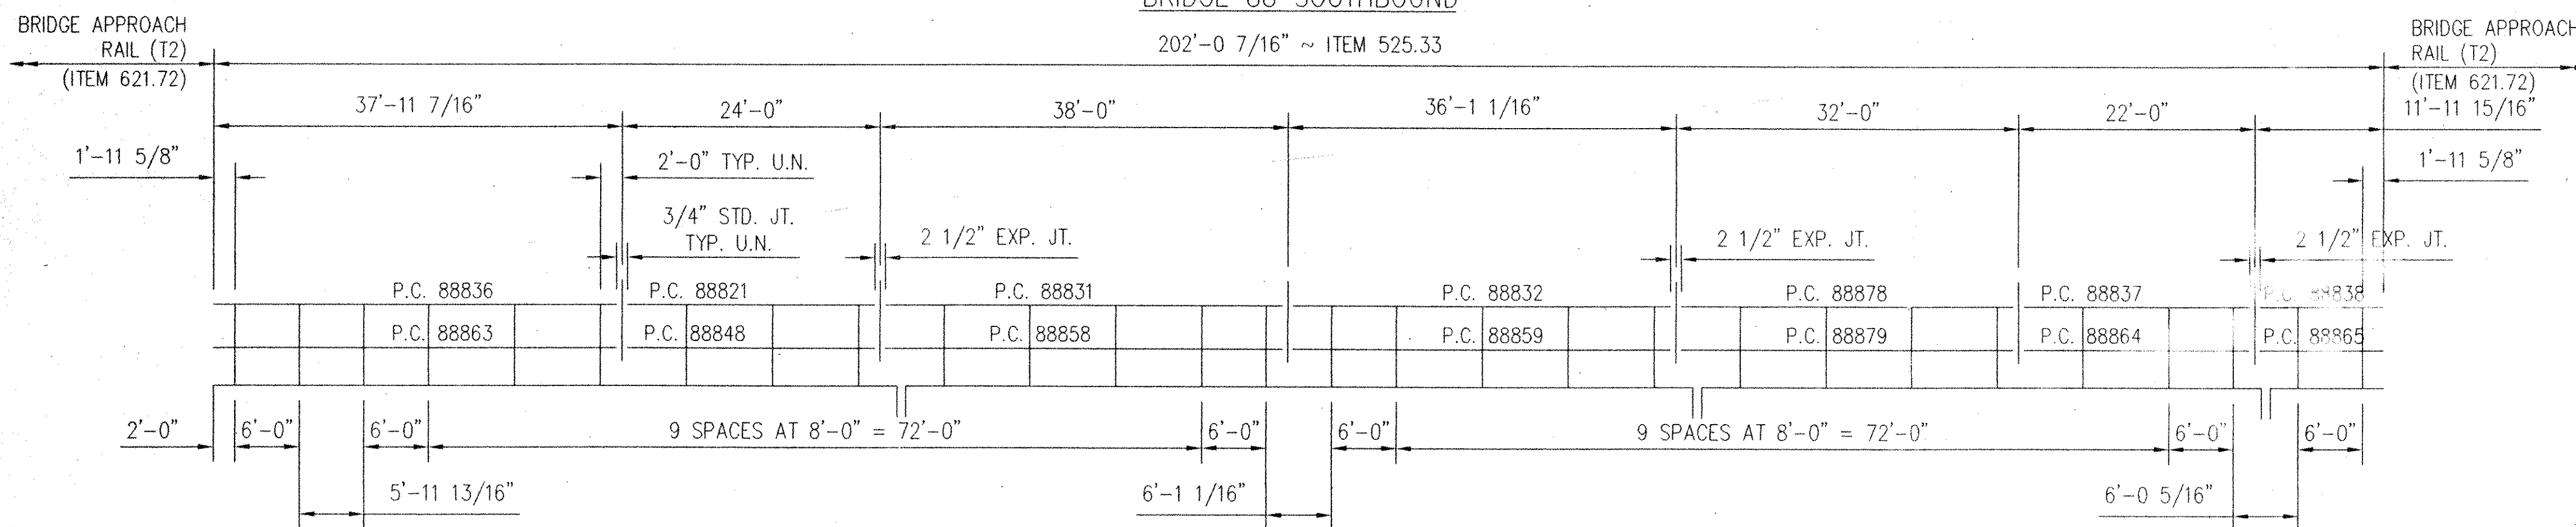


WEST RAILING - LOOKING WEST  
BRIDGE 88 SOUTHBOUND

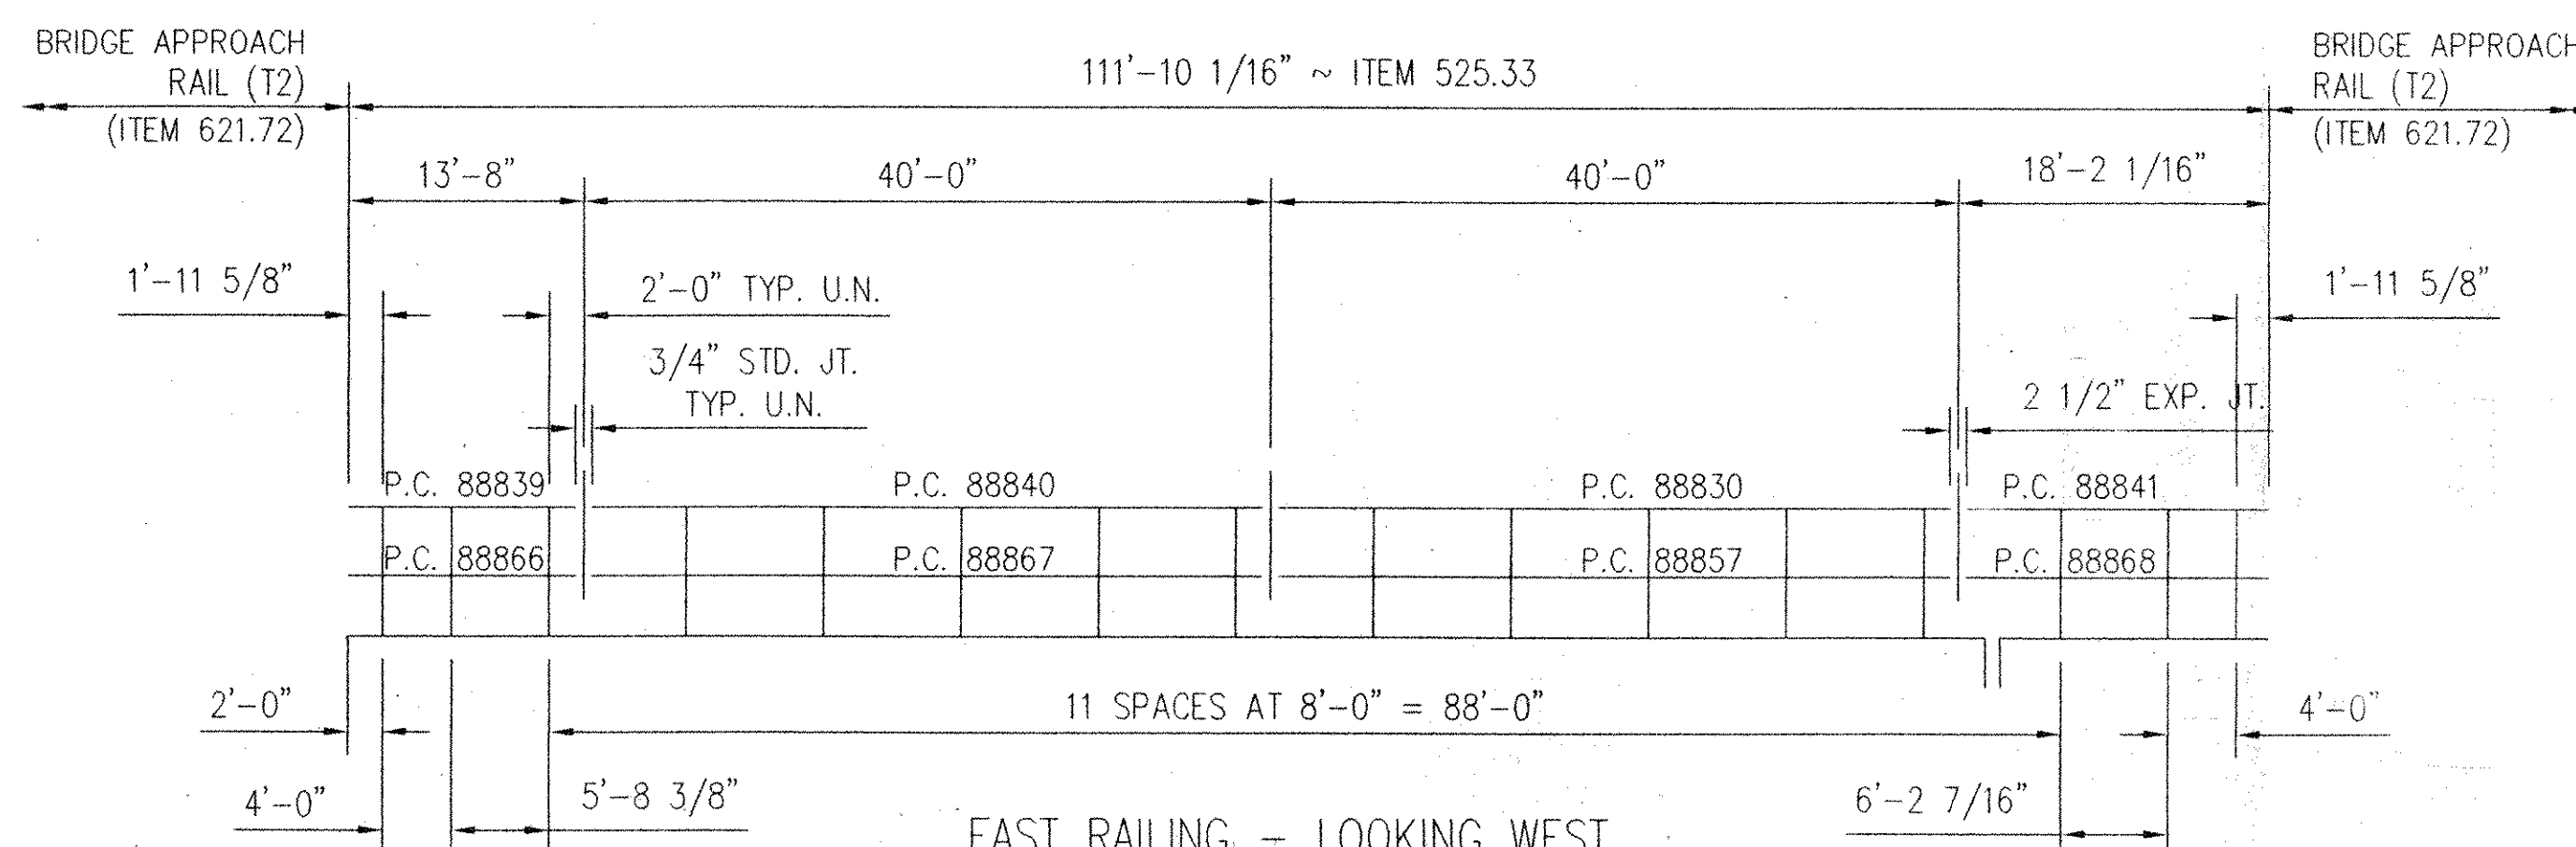

EAST RAILING - LOOKING WEST  
BRIDGE 87 NORTHBOUND

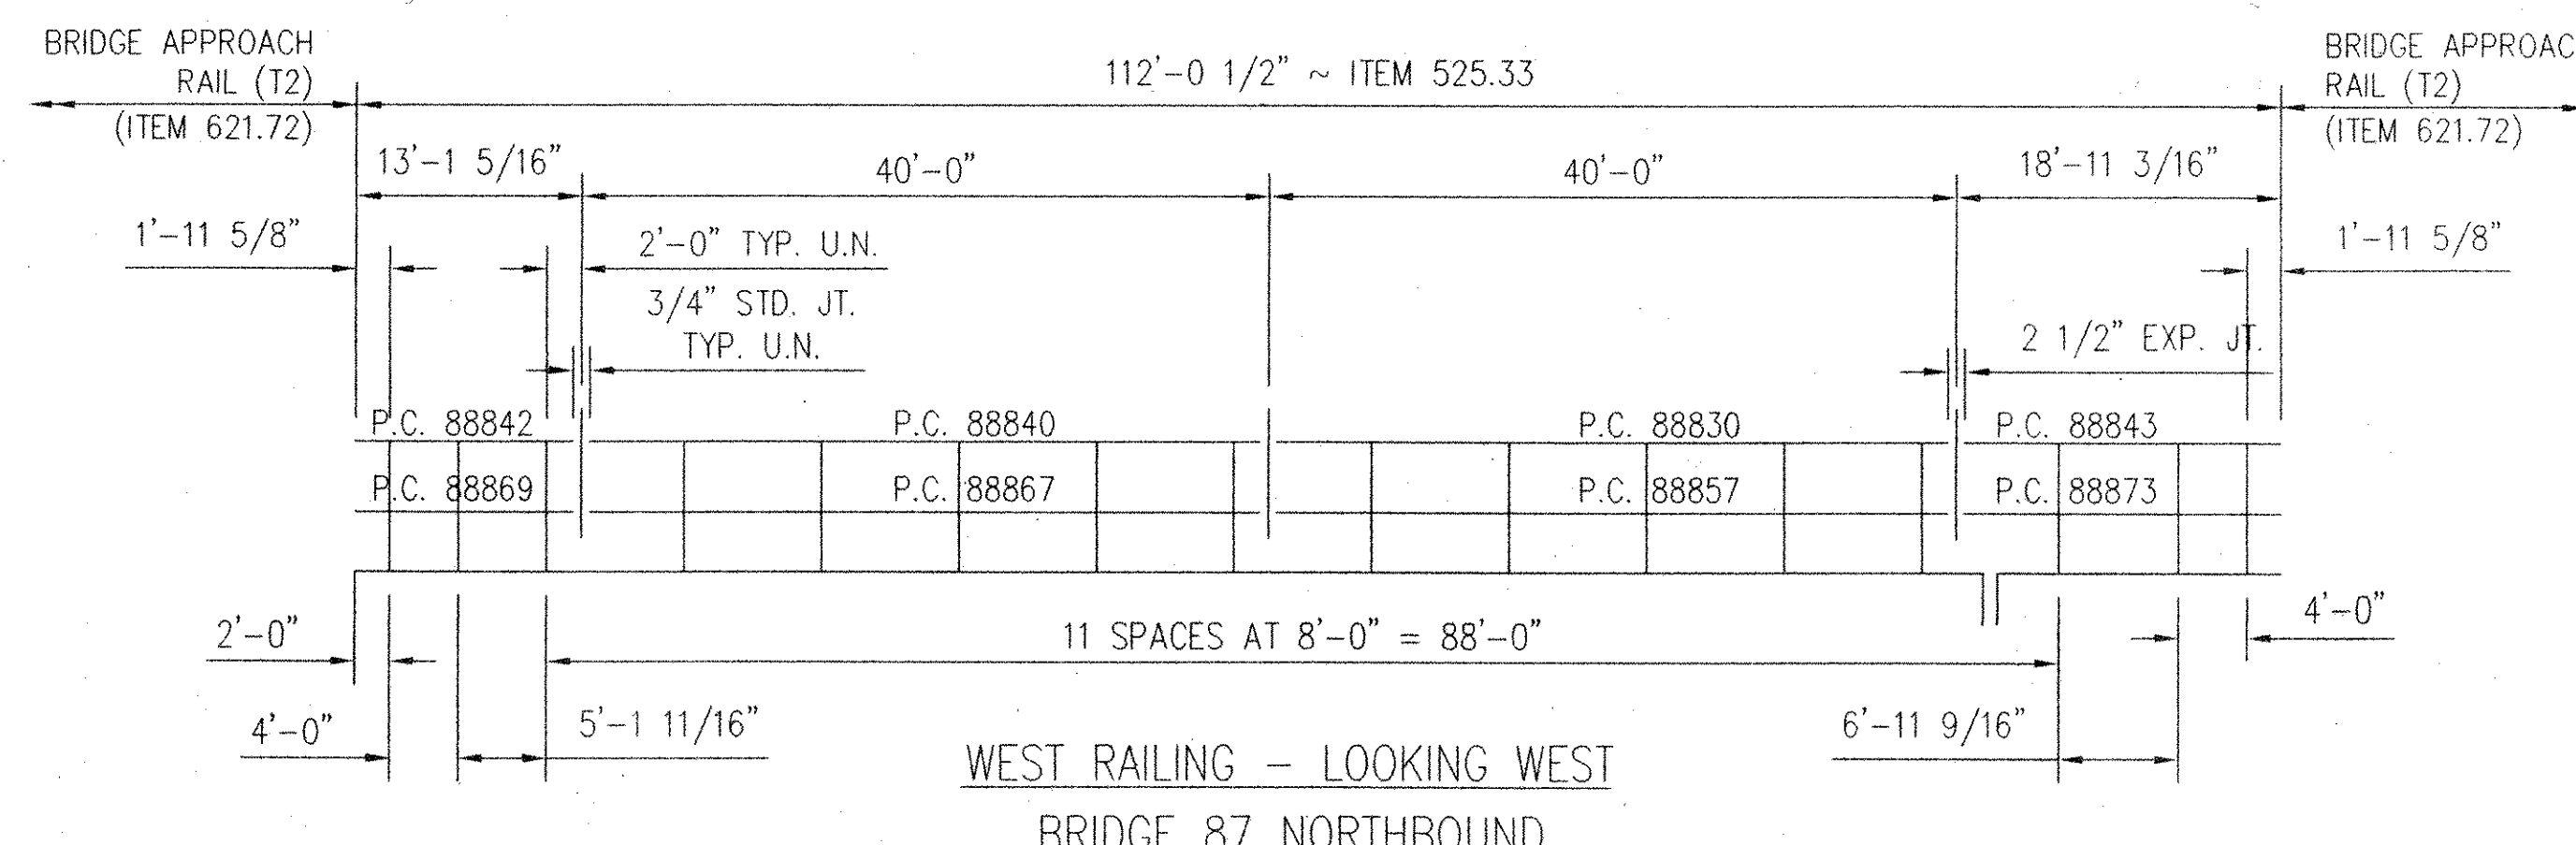

WEST RAILING - LOOKING WEST  
BRIDGE 87 NORTHBOUND

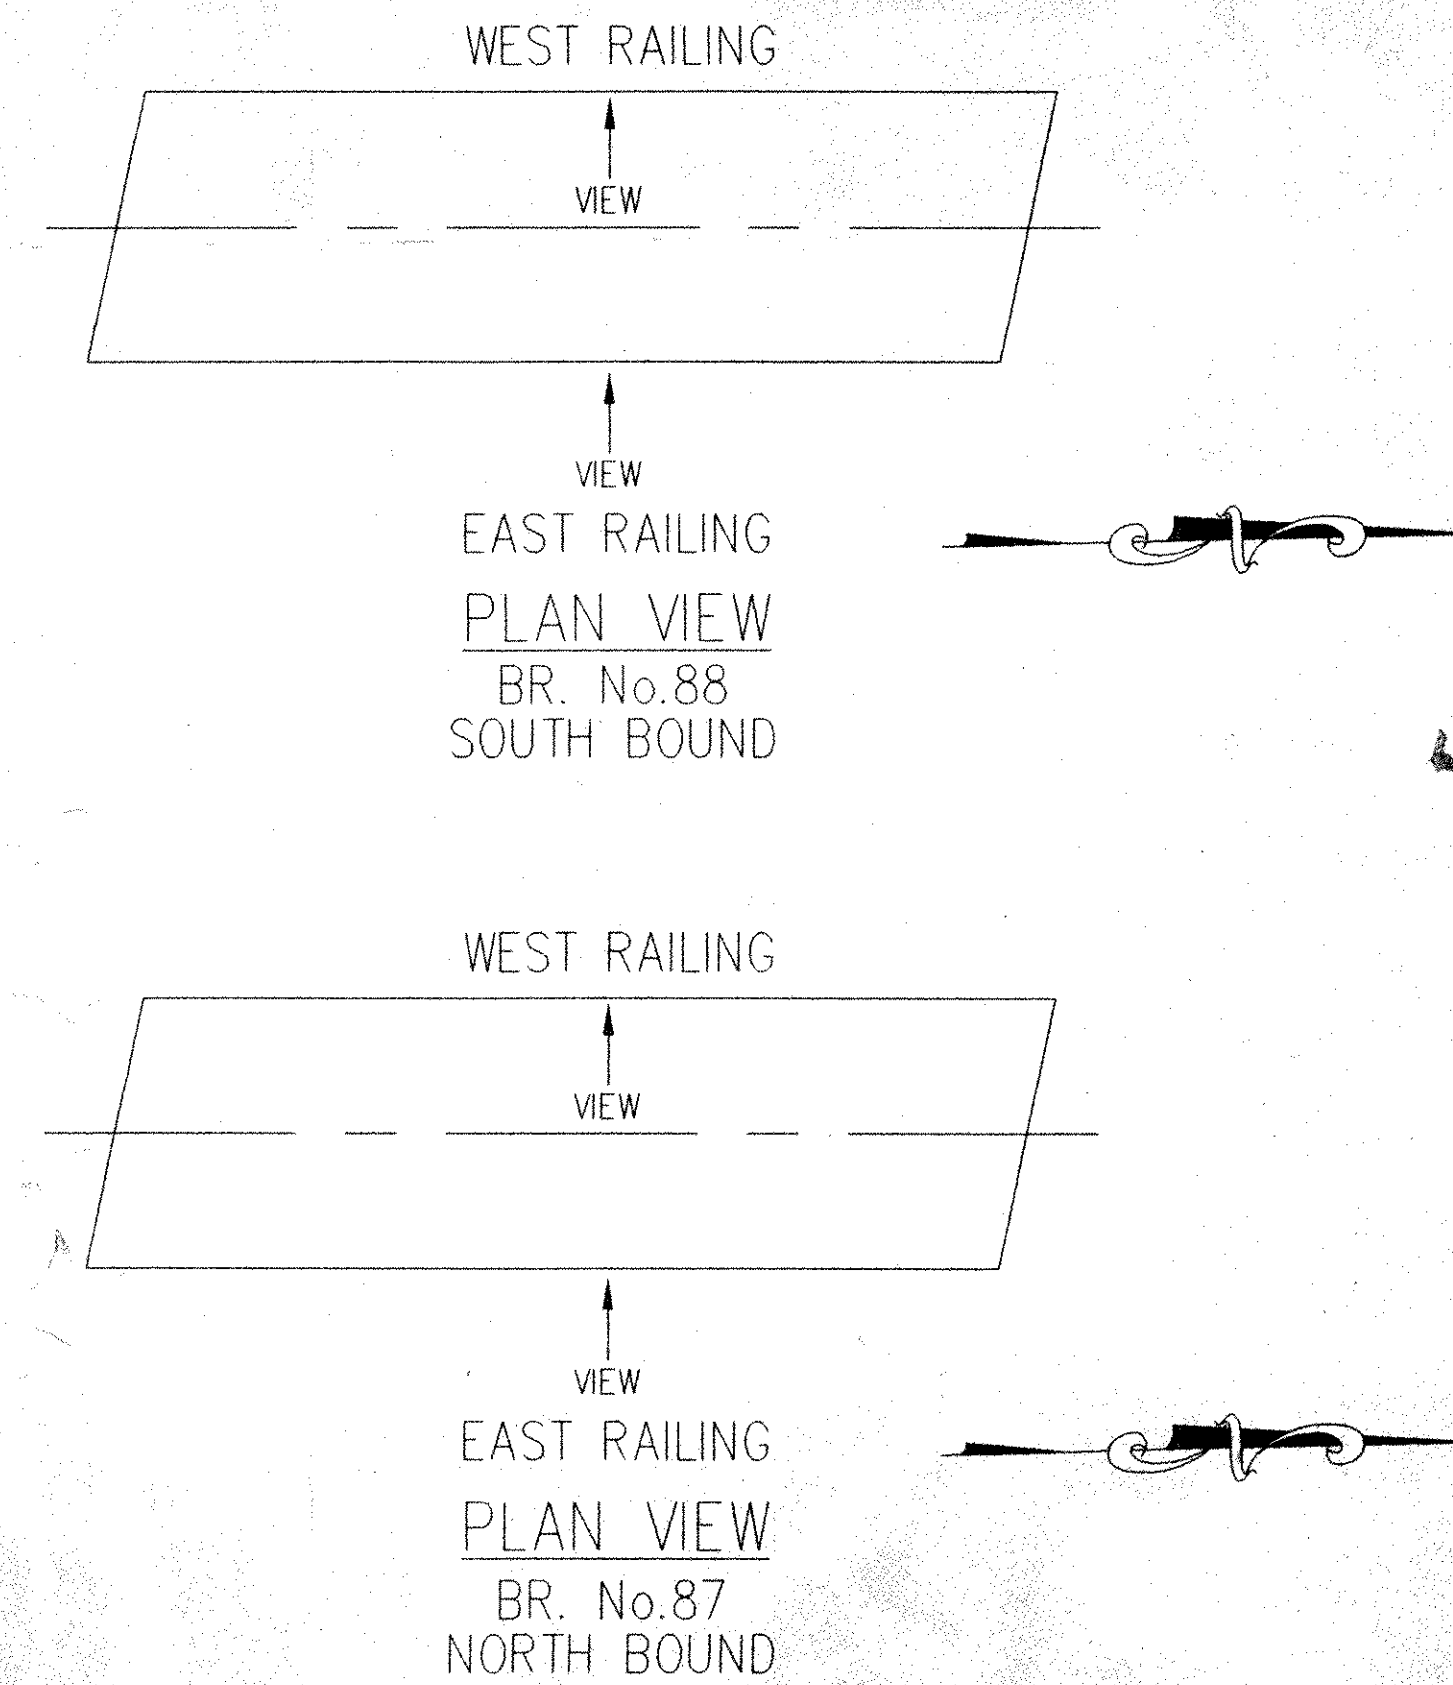

V.A.O.T.  
**RECEIVED**  
 OK'D BY JEL OK'D BY G.Roy  
 5-30-01 6-4-01  
**MAY 24 2001**  
 RESUBMIT APPROVED X  
 BY G.Roy DATE 6-4-01

NOTES:

1. ALL RAILING POSTS ARE PC-27782.
2. ALL TS 8" x 4" RAIL SPLICES ARE PC 35107.
3. ALL TS 4" x 4" RAIL SPLICES ARE PC 35103.
4. TOTAL PAY LENGTH: 1231.48 LIN. FT.
5. FINISH: GALV. A123, HARDWARE: GALV. A153.

This drawing and the information shown thereon is the sole property of TRINITY INDUSTRIES, INC. Neither the drawing nor such information is to be used for any purpose other than that for which it was specifically furnished by TRINITY

GIRARD ENGINEERING DEPT.  
**ISSUED**  
 MAY 17 2001  
 TRINITY INDUSTRIES, INC.  
 1170 N. STATE STREET  
 GIRARD, OHIO 44420

APPROVAL DRAWING

FOR DETAILS SEE SHEET D1, D2, D3 & D4 OF 4 (22) 102392

REV.	CHK'D	BY	DATE	REMARKS

ITEM NUMBER 525.33 T2 STEEL BRIDGE RAIL (PL2)

STATE OF VERMONT AGENCY OF TRANSPORTATION INTERSTATE ROUTE 89	DRAWN SAR
TOWNS OF FAIRFAX, FAIRLAND & ST. ALBANS COUNTY OF FRANKLIN STATE PROJECT NO. IM 089-3(27) BRIDGE NO. 87/88	CHECKED S.H.
CUSTOMER NORTHLAND SPECIALTIES P.O. No. VERBAL	SCALE: N.T.S.
TRINITY INDUSTRIES, INC. 423 HIGHWAY SAFETY PRODUCTS 2525 STEMMONS FREEWAY, DALLAS, TX 75207	DATE 4/30/01
	ENG. FILE # 22-102392-E2
	SHT. No. E2 OF 3
	TRINITY SALES ORDER NO. (??) 102392