


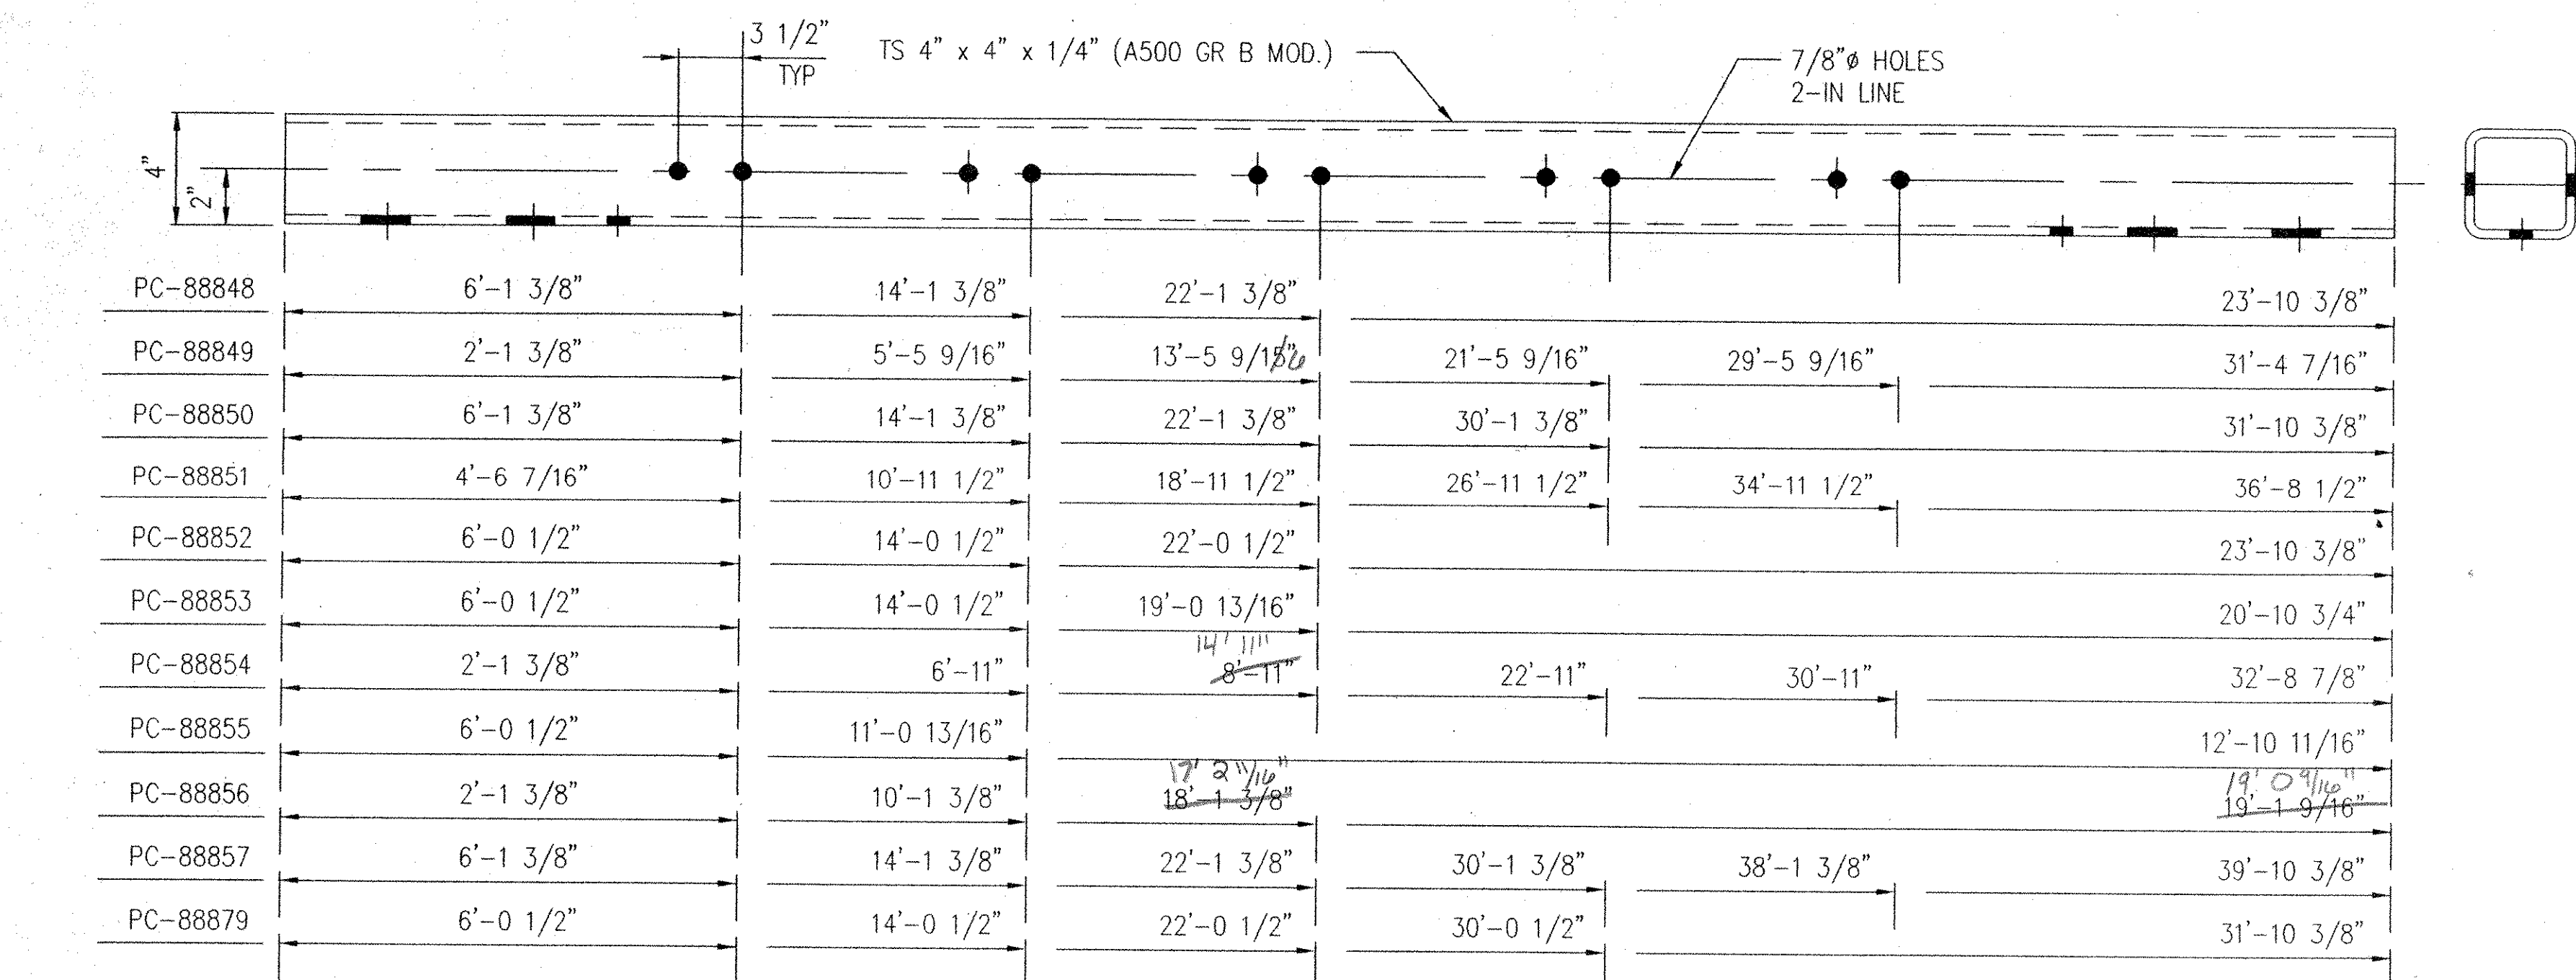

This drawing and the information shown thereon is the sole property of TRINITY INDUSTRIES, INC. Neither the drawing nor such information is to be used for any purpose other than that for which it was specifically furnished by TRINITY INDUSTRIES, INC.

REV.				CHK'D				BY				DATE				REMARKS																					
ITEM NUMBER 525.33 T2 STEEL BRIDGE RAIL (PL2)																																					
STATE OF VERMONT AGENCY OF TRANSPORTATION																DRAWN												SAR									
INTERSTATE ROUTE 89																CHECKED												S.H.									
TOWNS OF FAIRFAX, FAIRLAND & ST. ALBANS COUNTY OF FRANKLIN																SCALE:												N.T.S.									
STATE PROJECT NO. IM 089-3(27)																BRIDGE NOS. 87/88																					
CUSTOMER								NORTHLAND SPECIALTIES								P.O. No.				VERBAL																	
								TRINITY INDUSTRIES, INC. <i>426</i>																													
								HIGHWAY SAFETY PRODUCTS																													
								2535 STEPHENS FREEWAY, DALLAS, TX 75207																													
																ENG. FILE #												22-102392-02									
																SHT. NO.												D2 OF 4									
																TRINITY SALES ORDER NO.												REV.									