
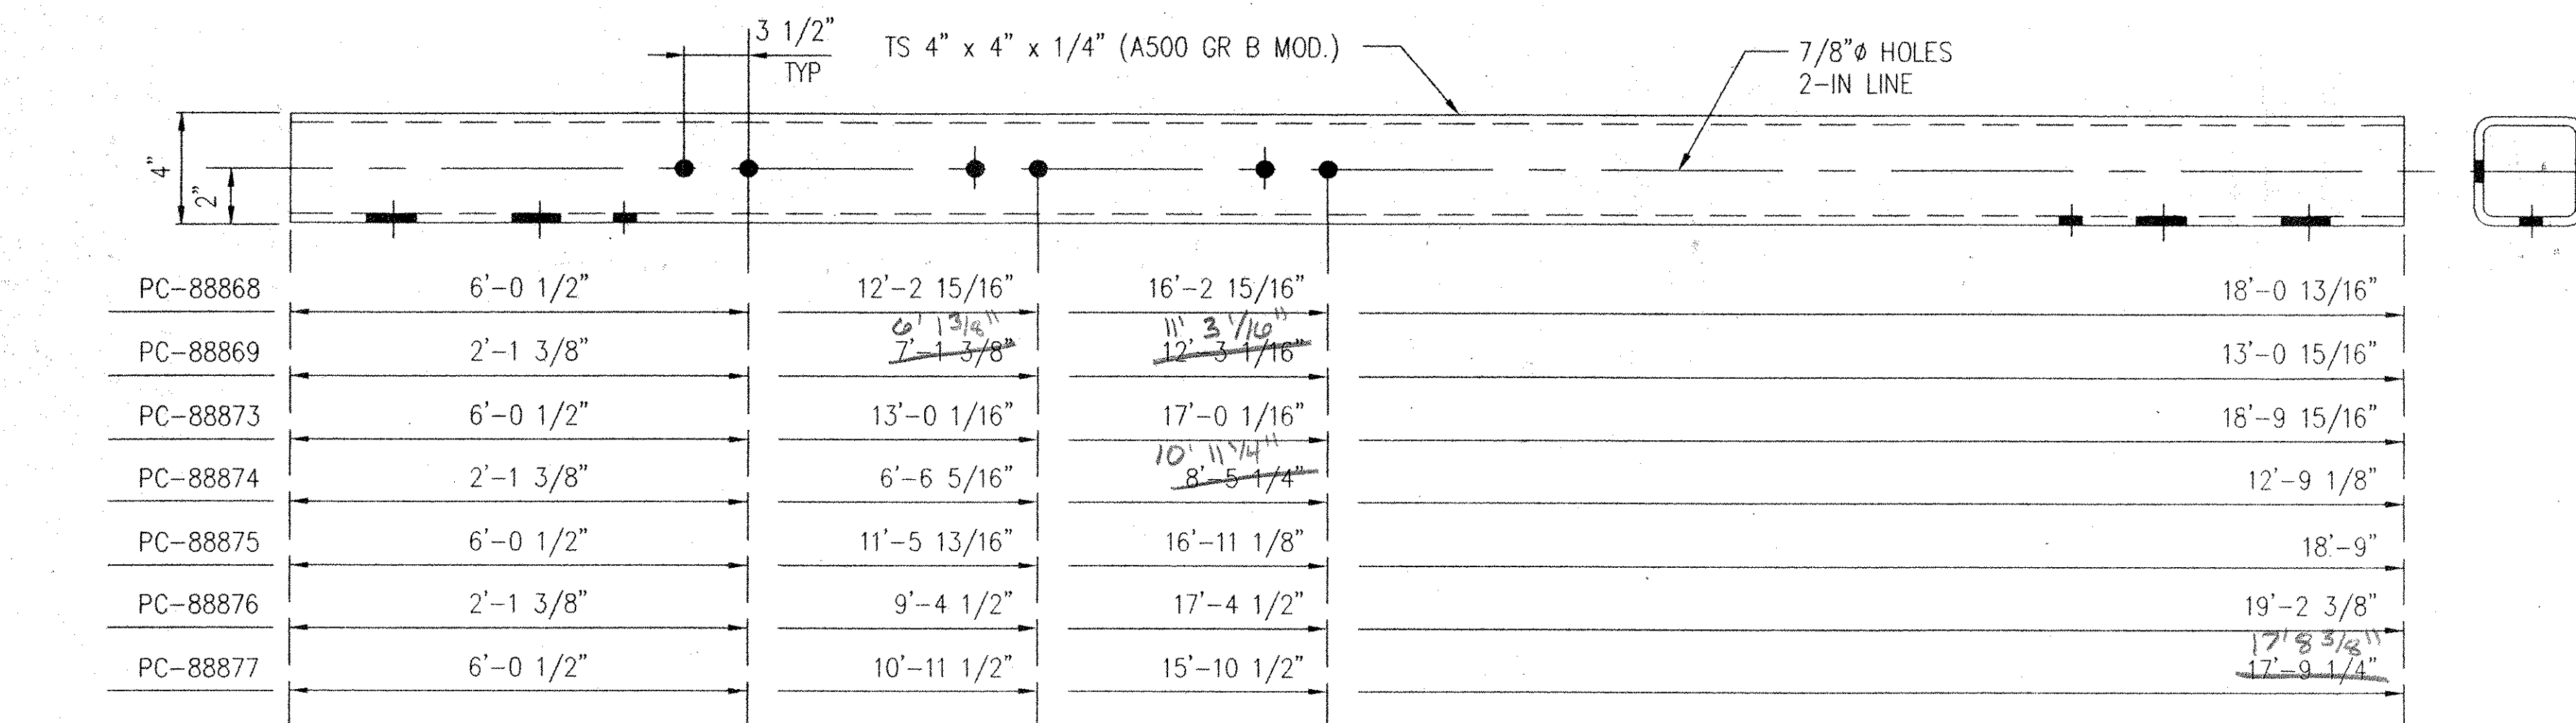


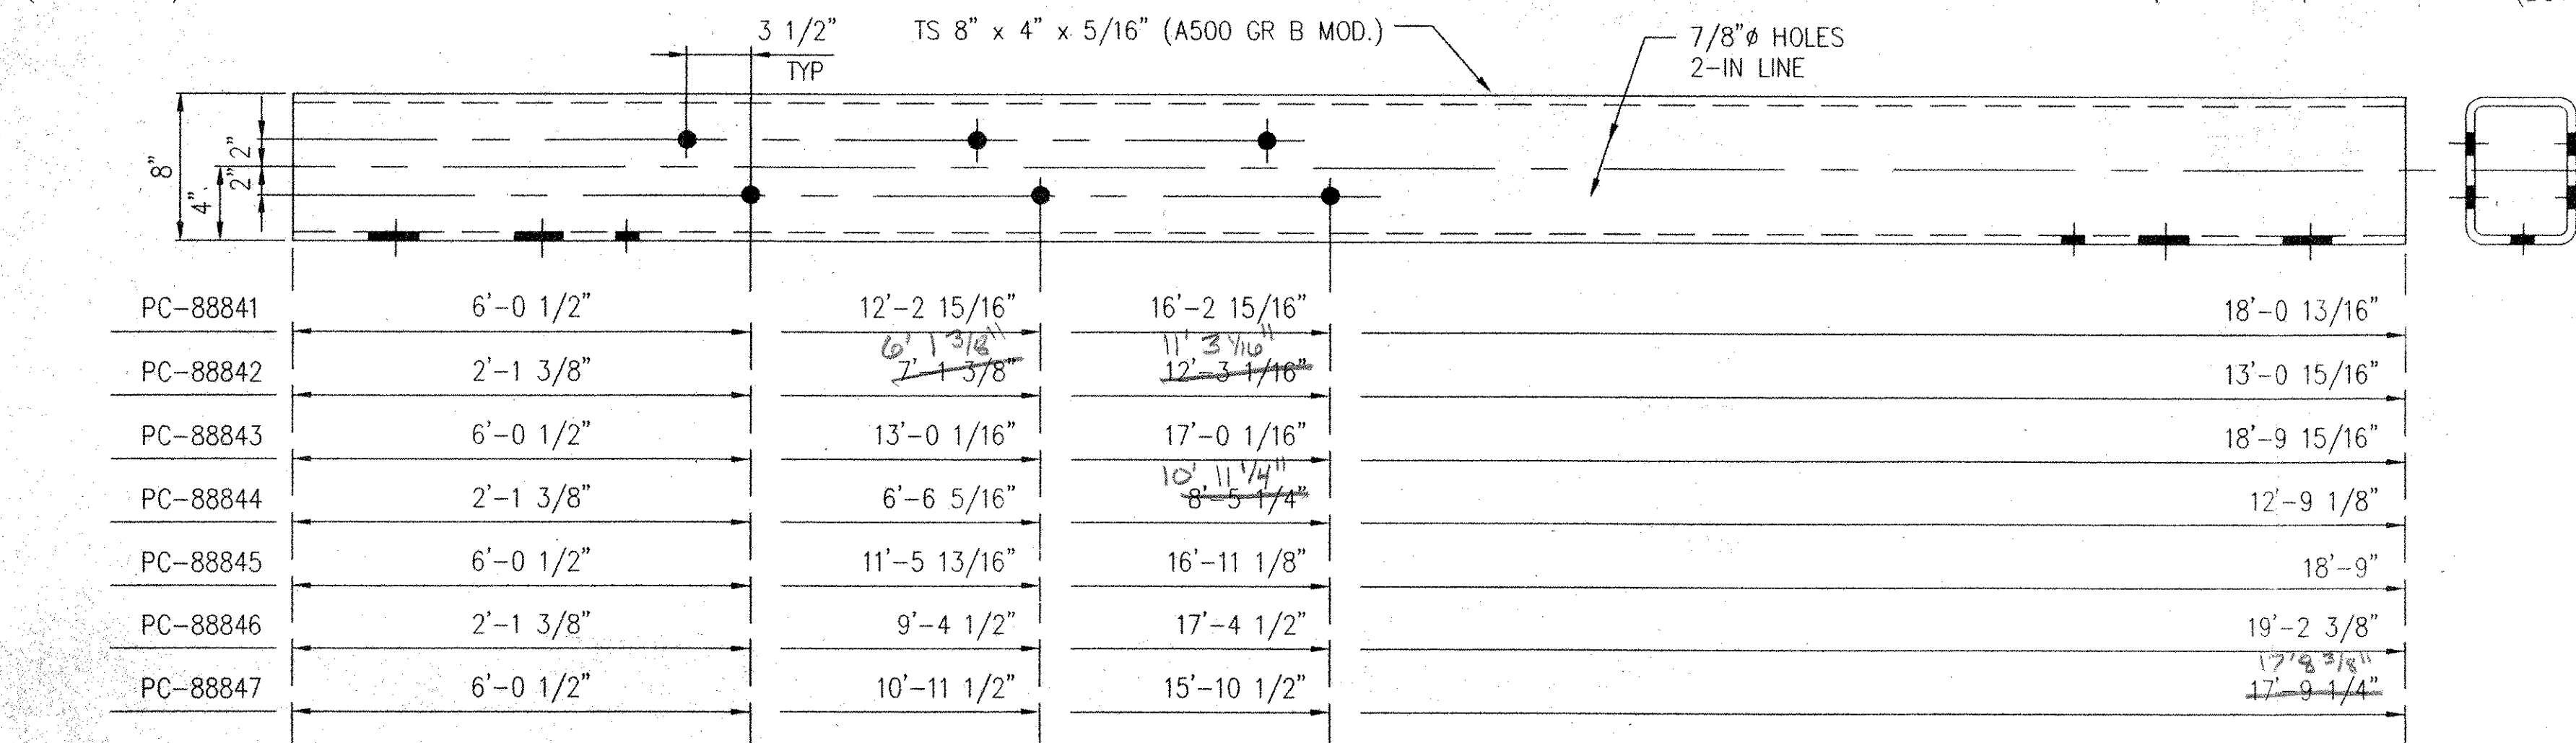

NOTES:

APPROVAL DRAWING

GIRARD ENGINEERING DEPT.
ISSUED
MAY 17 2001
TRINITY INDUSTRIES, INC.
1170 N. STATE STREET
GIRARD, OHIO 44420

V.A.O.T.
RECEIVED
OK'D BY JEL OK'D BY G. Roy
5/30/01 6.4.01
MAY 24 2001
RESUBMIT _____ APPROVED ASW
BY G. Roy DATE 6.4.01

This drawing and the information shown thereon is the sole property of TRINIT INDUSTRIES, INC. Neither the drawing nor such information is to be used for any purpose other than that for which it was specifically furnished by TRINIT INDUSTRIES, INC. nor is any remedy to be sought without written permission.

TRINITY INDUSTRIES, INC. 42
HIGHWAY SAFETY PRODUCTS
2525 STEMMONS FREEWAY, DALLAS, TX 75207

428

ITEM NUMBER 525.33 T2 STEEL BRIDGE RAIL (PL2)

STATE OF VERMONT AGENCY OF TRANSPORTATION INTERSTATE ROUTE 89 TOWNS OF FAIRFAX, FAIRLAND & ST. ALBANS COUNTY OF FRANKLIN STATE PROJECT NO. IM 089-(27) BRIDGE NOS. 87/88		DRAWN SAR CHECKED S.H. SCALE: N.T.S.
CUSTOMER	NORTHLAND SPECIALTIES	P.O. No. VERBAL
 TRINITY INDUSTRIES, INC. HIGHWAY SAFETY PRODUCTS 2525 STEMMONS FREEWAY, DALLAS, TX 75207		DATE 5/2/01 ENG. FILE # 22-102392-D4 SHITNo. D4 OF 4 TRINITY SALES ORDER NO. (22) 102392

REV. 0

4

NAL School Engineering WITH 10935001-00-10935001-04 due This May 17 40:56 AM 2004 DINED BY STATION 4