




HEADWALL H1 PLAN VIEW

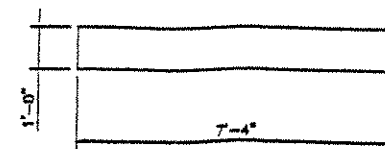


HEADWALL H2 PLAN VIEW

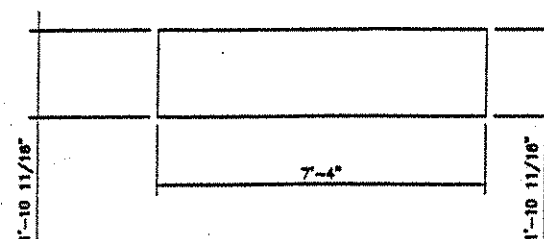


HEADWALL H1 ELEVATION VIEW

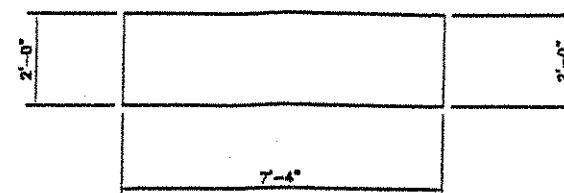


HEADWALL H2 ELEVATION VIEW

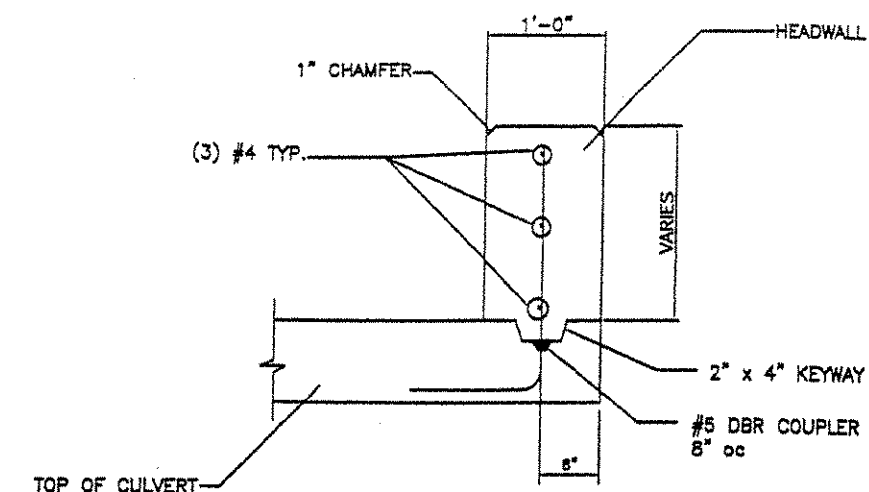


HEADWALL DETAIL

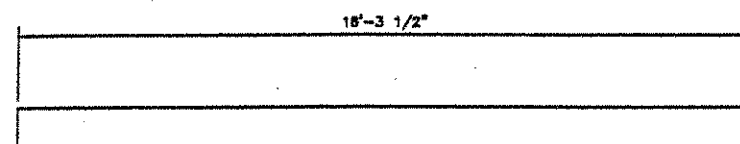


CUTOFF WALL C1 PLAN VIEW

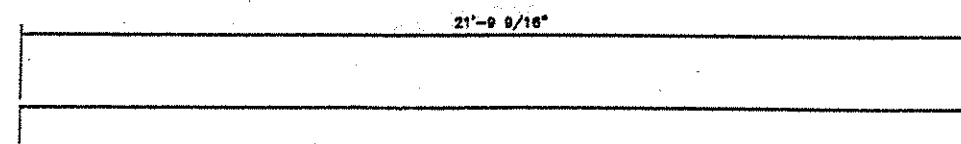

CUTOFF WALL C2 PLAN VIEW

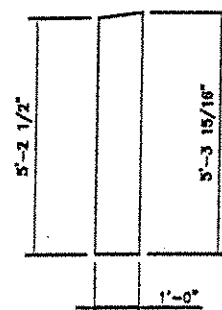


CUTOFF WALL C1 END VIEW

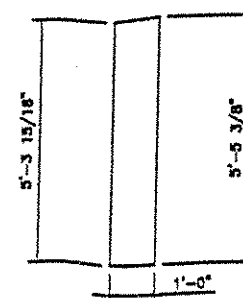

CUTOFF WALL C2 END VIEW

V.A.O.T
RECEIVED
OK'D BY *C. Roy* OK'D BY *mgl*
3-21-01 3-29-01
MAR 21 2001
RESUBMIT APPROVED
DATE 3-29-01

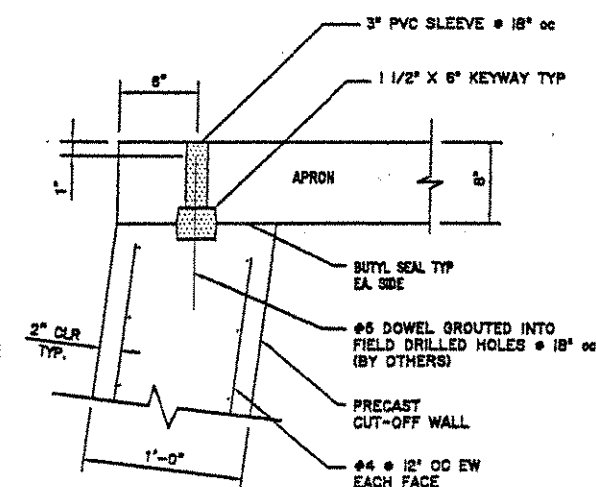

CUTOFF WALL DETAIL



Ralph Verrastro
2/21/01

	TOWN OF ST. ALBANS, VT. 6'-0" x 6'-0" x 78'-0" BR 87-3 NORTHBOUND CONTRACTOR: 431 ENGINEER: SHEET 3 OF 3 PRECAST
--	---