

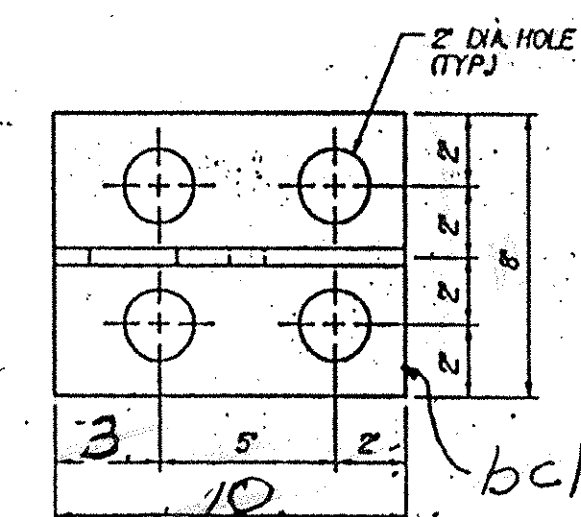
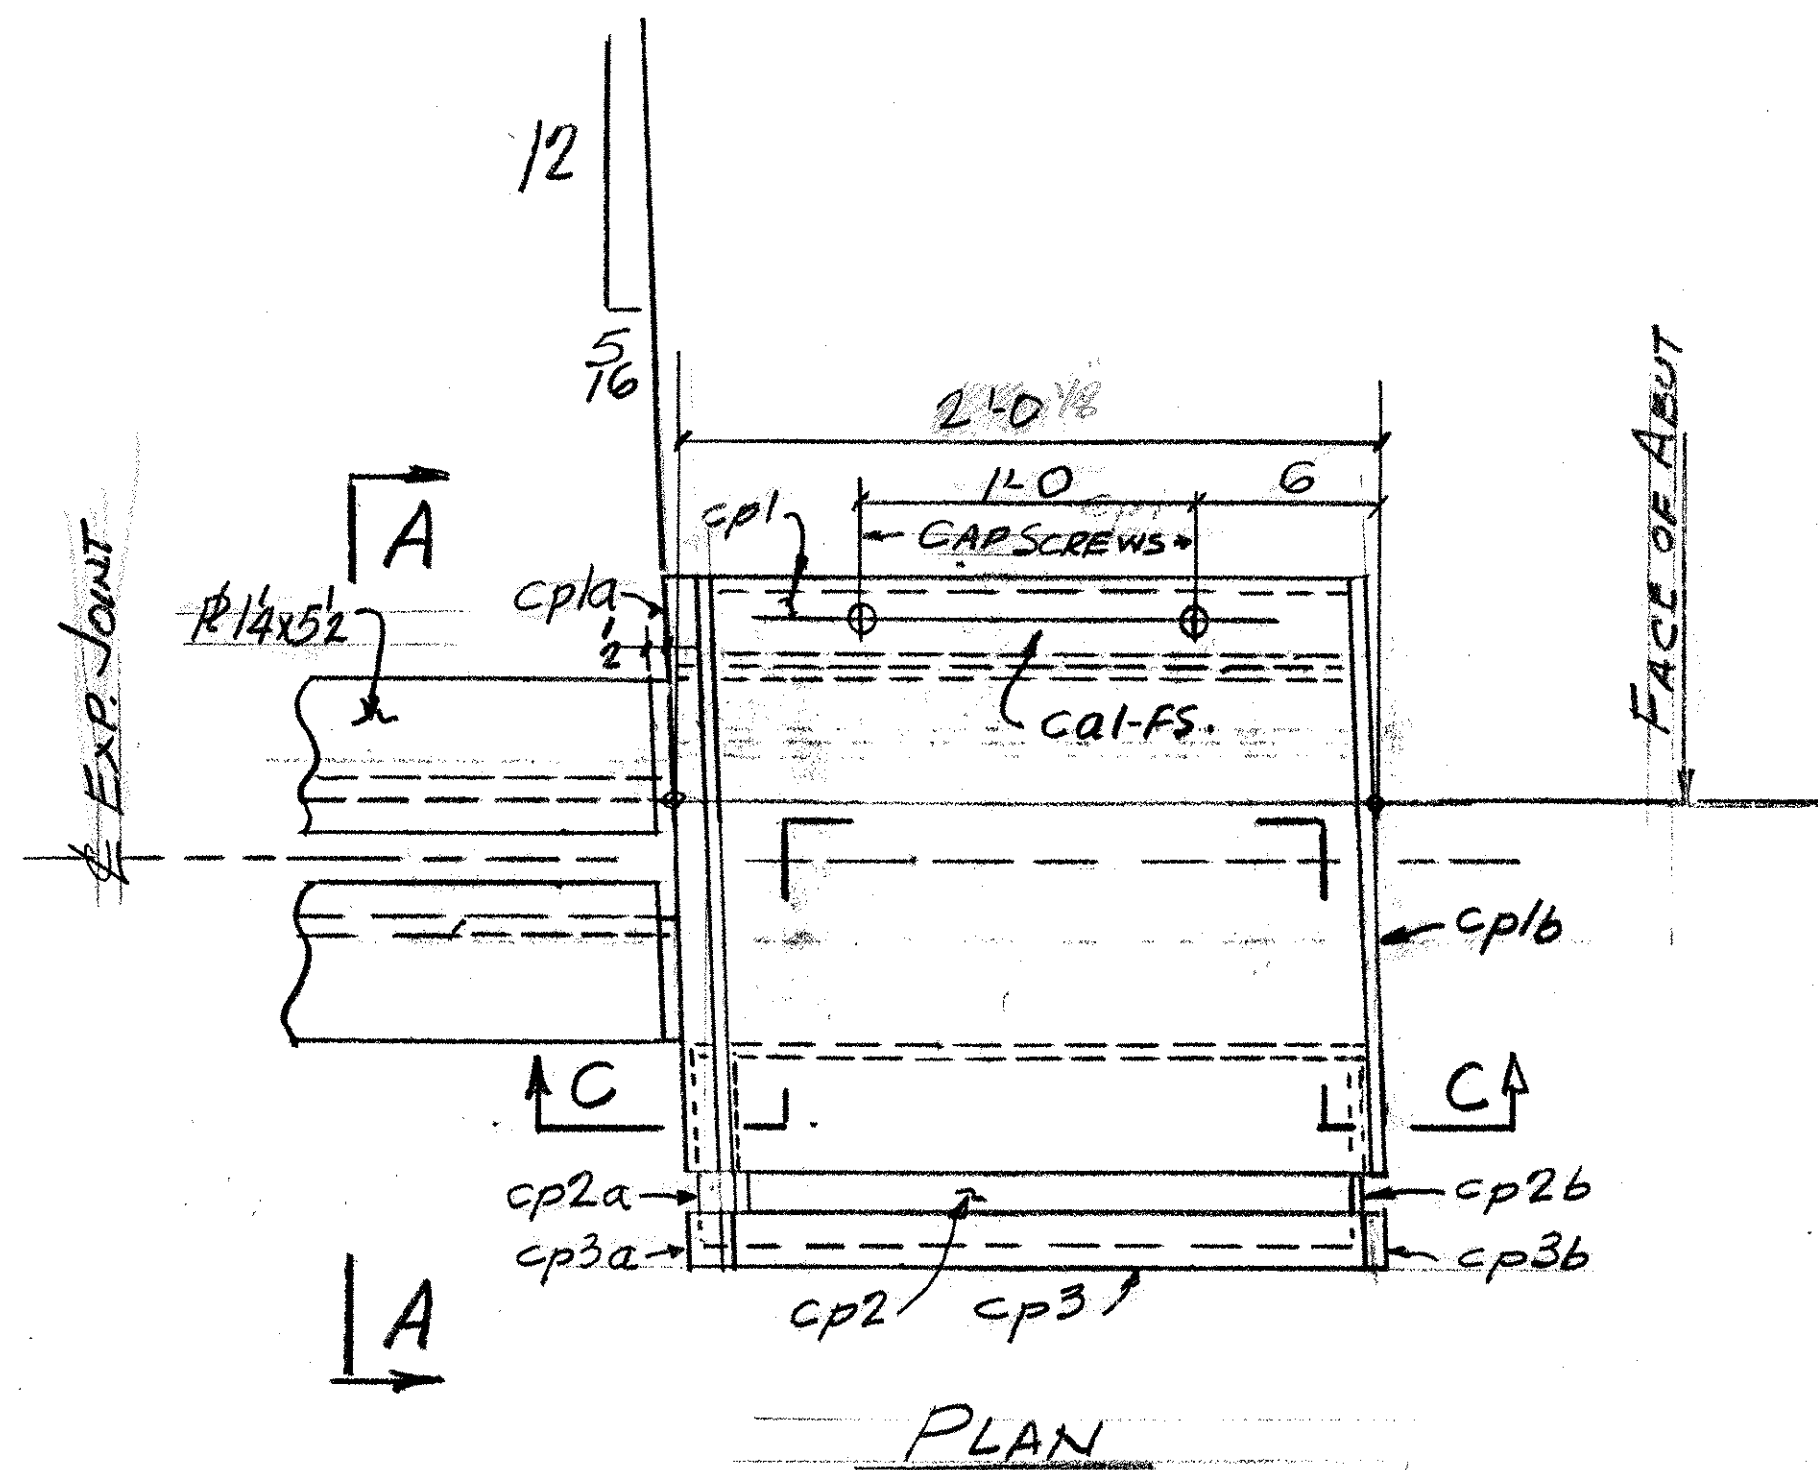
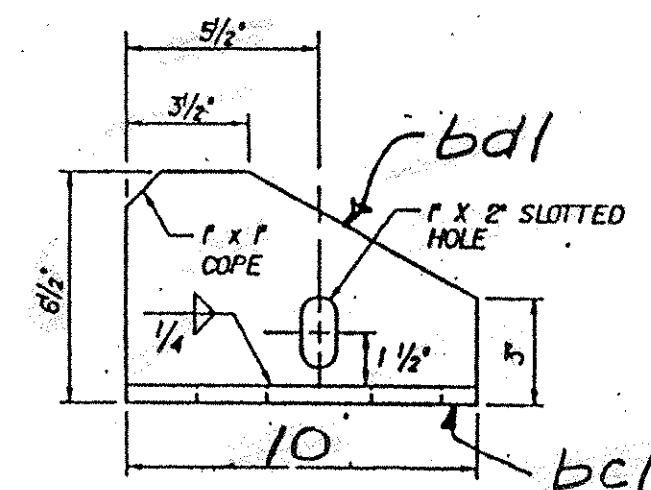


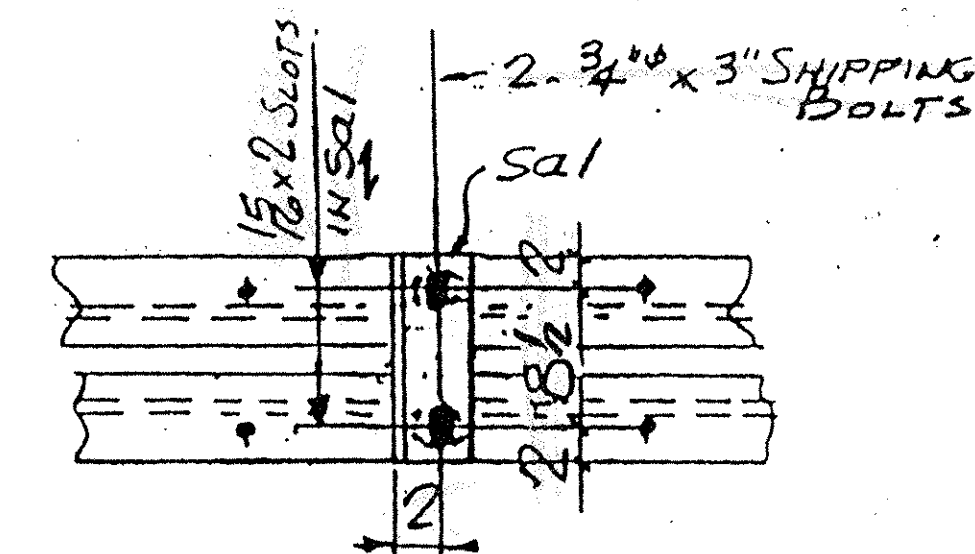

BRACKET PLAN


BRACKET ELEVATION

SHIPPING DEVICE
SPACED 540.00 MAX. (8 REQ'D)

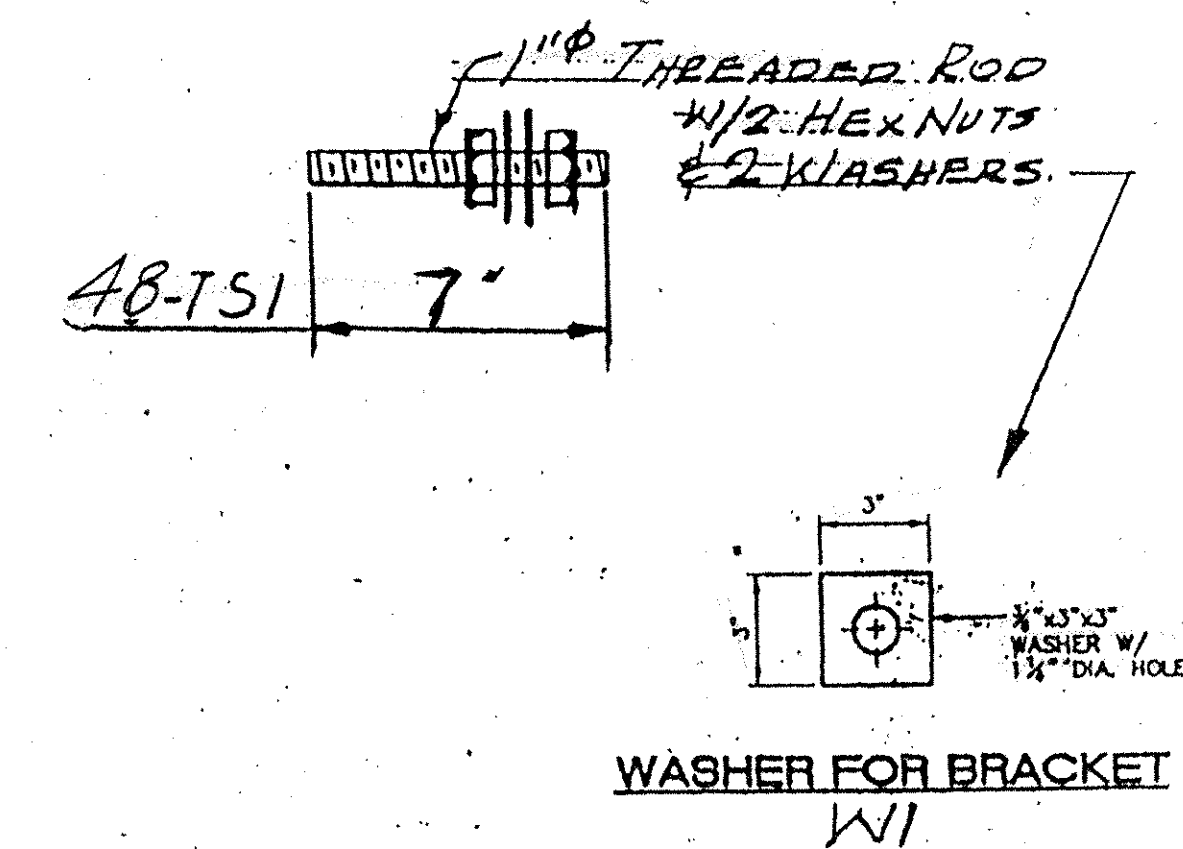


WASHER FOR BRACKET
WI

WORK THIS DWG. W/ DWG. J1

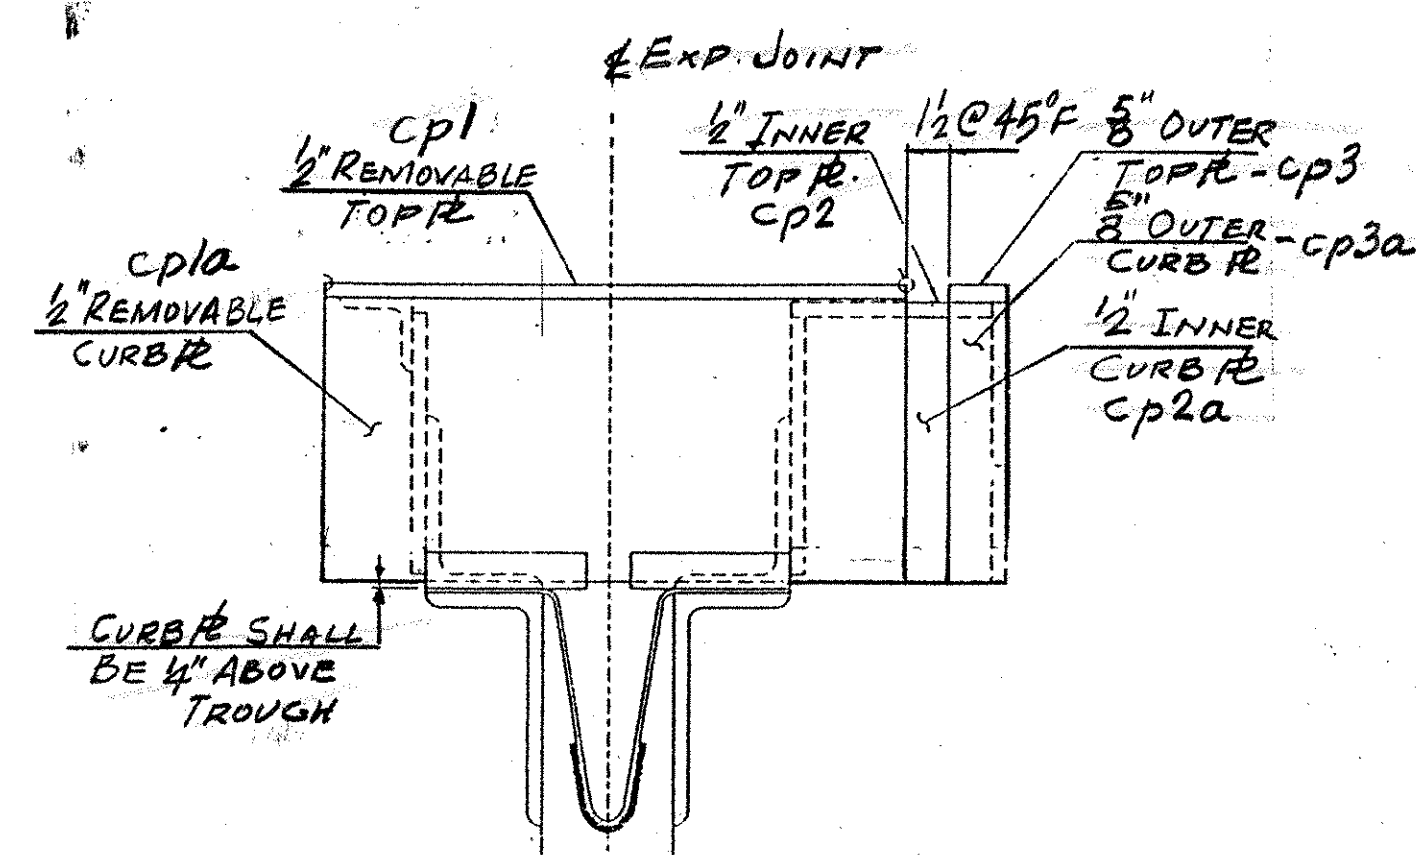


SECTION A-A

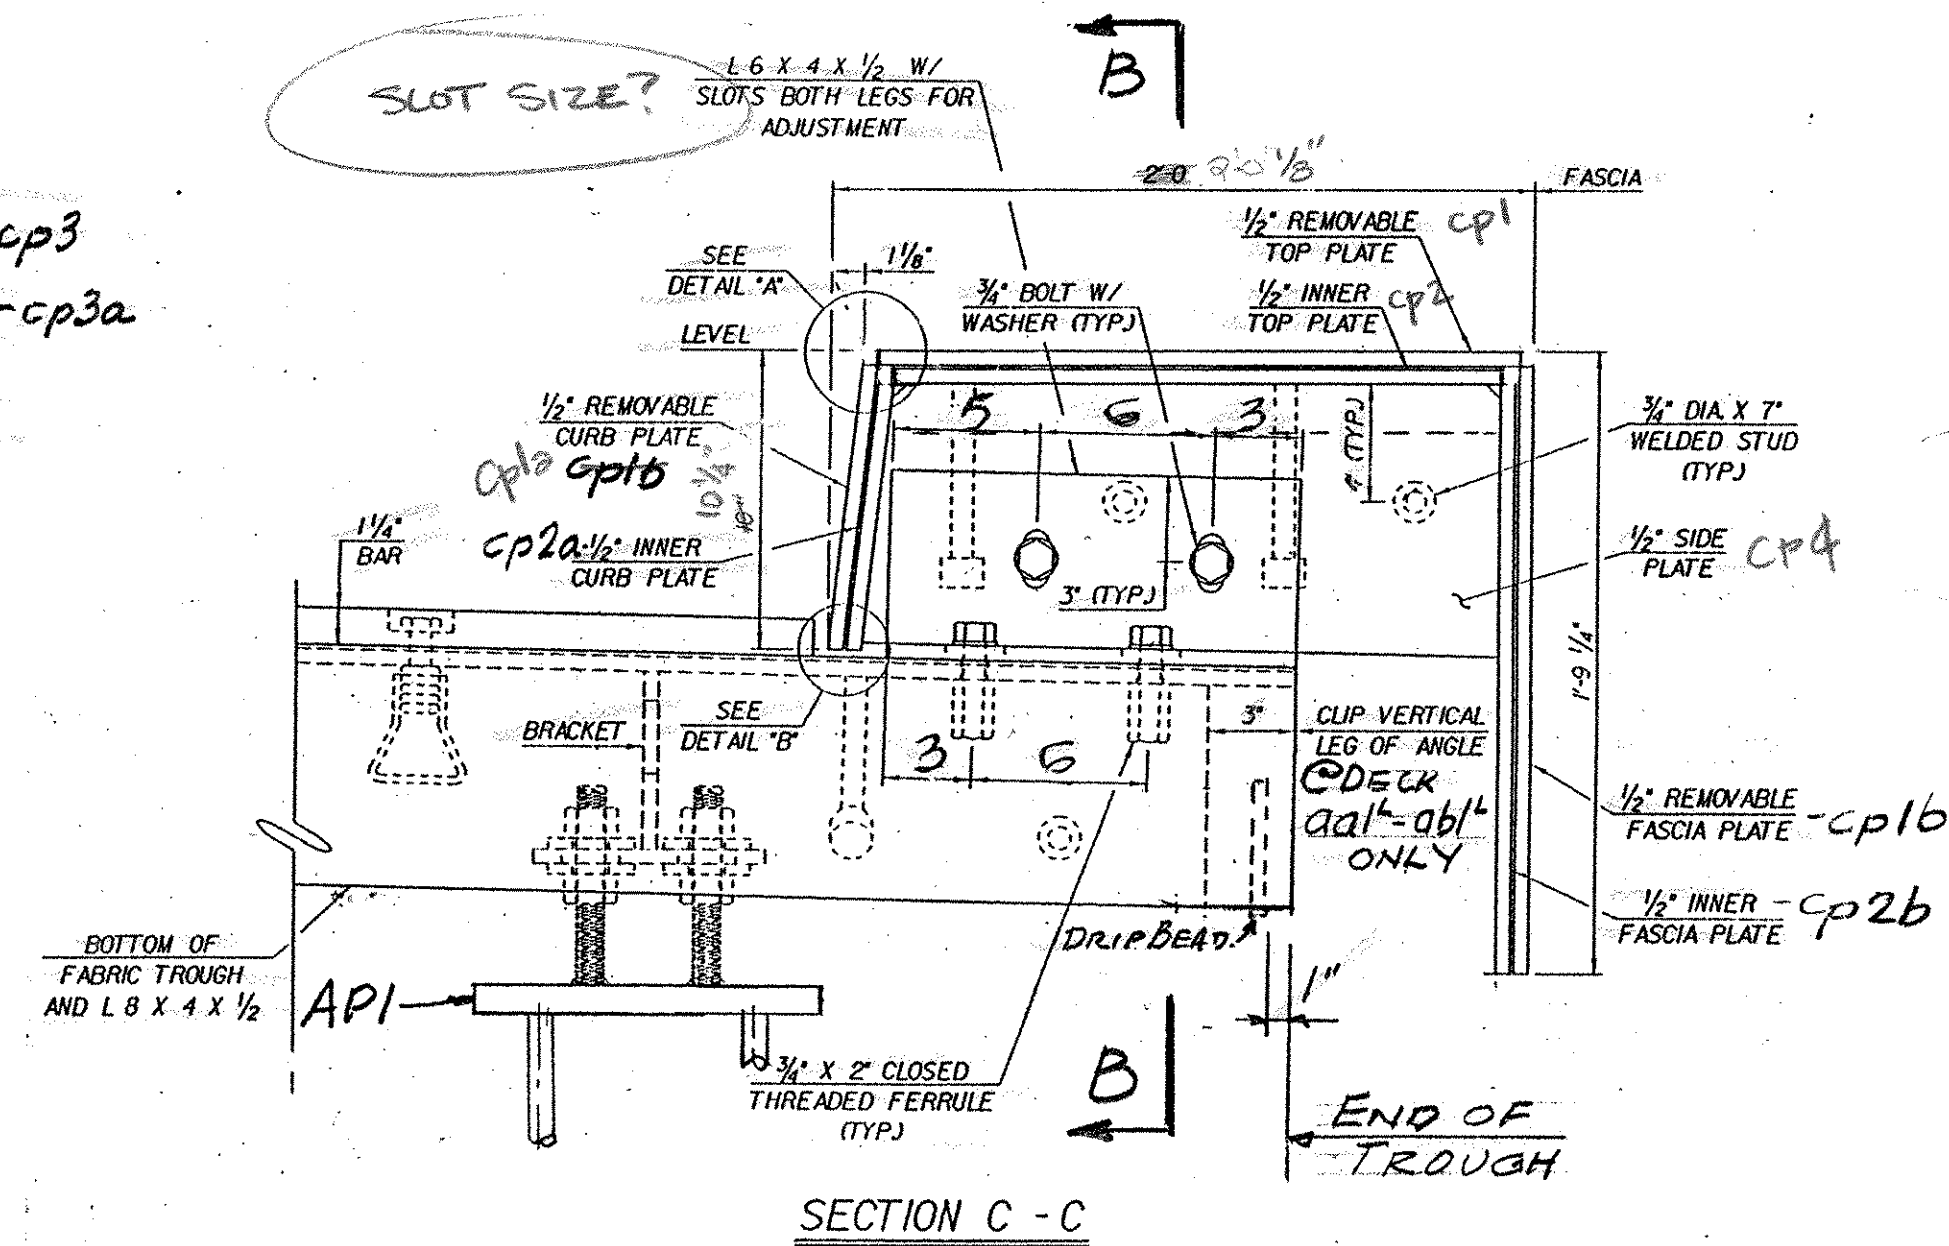


SECTION C - C

RIGHT END BRUSH CURB SHOWN
LEFT END - OPP HAND.

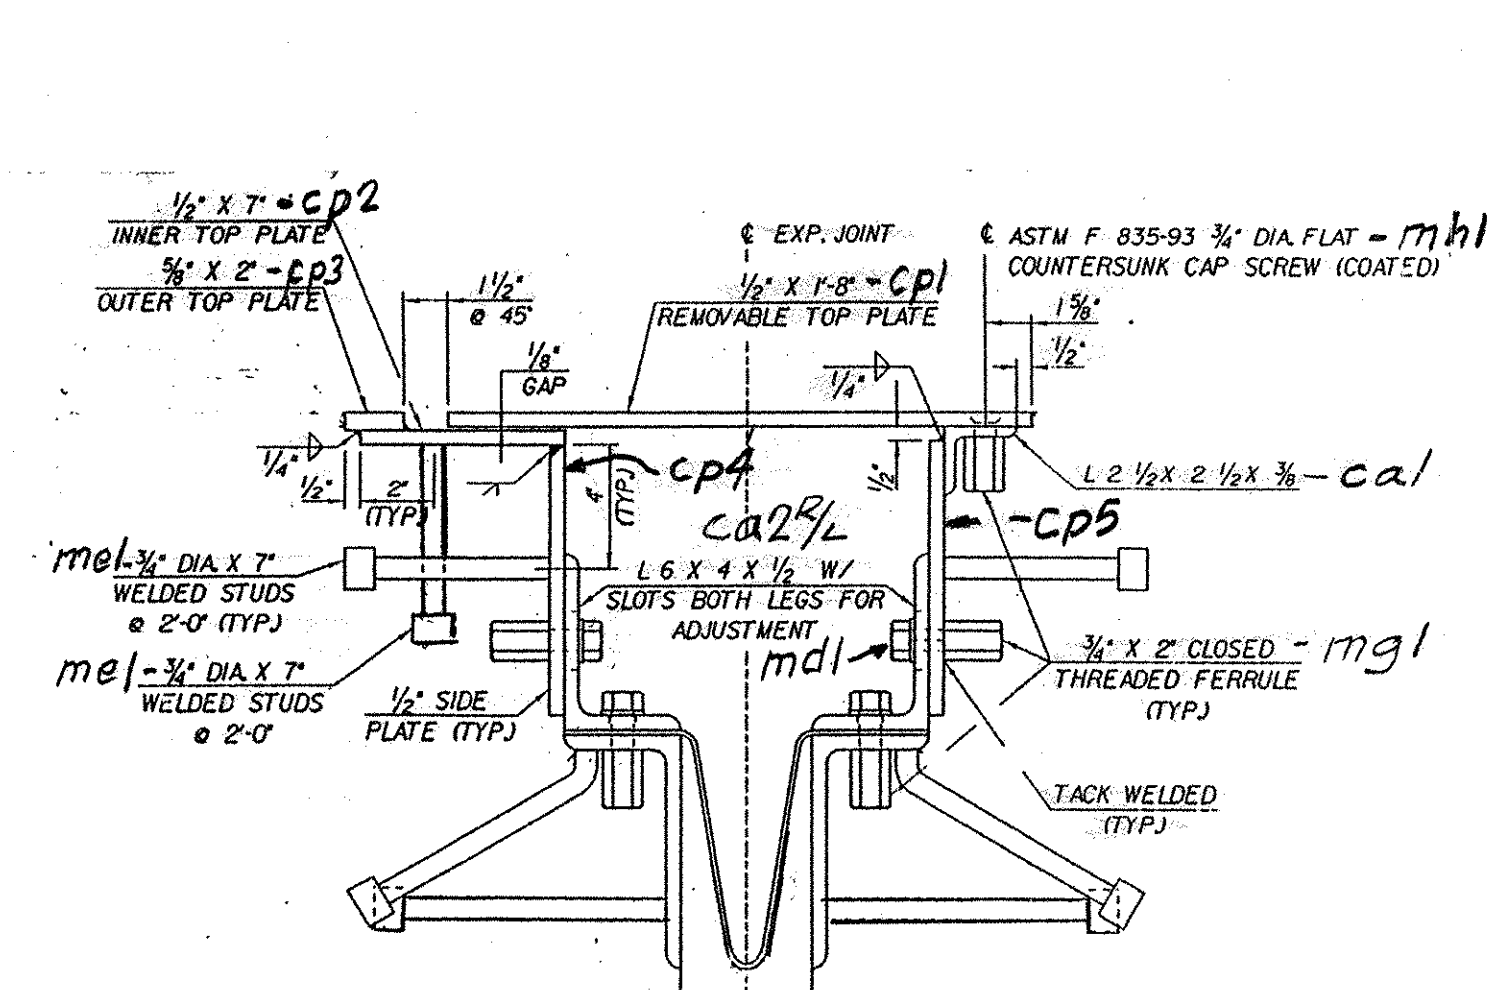

SECTION B-B

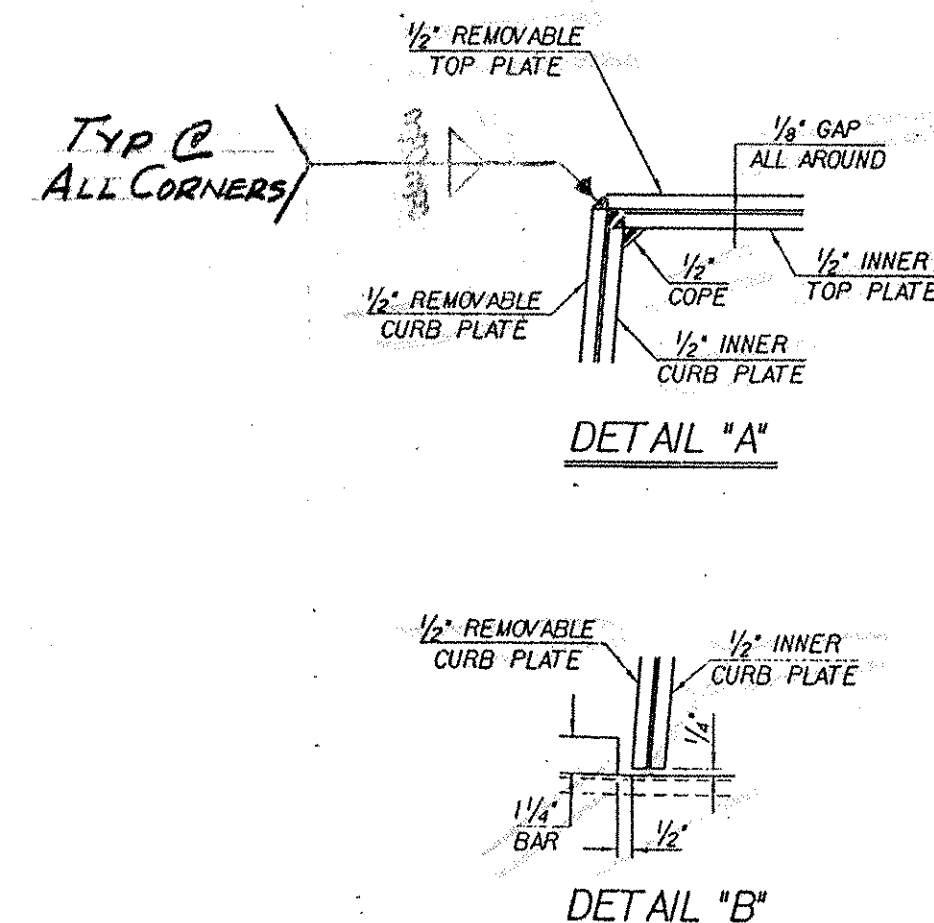

DETAIL "B"

API-6-REQ'D
DO NOT GALVANIZE

V AOT
 RECEIVED
 CK'D BY SEL OK'D BY C. Ray
 4-3-01
 MAR 29 2001
 RESUBMIT _____ APPROVED ✓ AS NOTED
 BY mel DATE 4-17-01

[illegible]