

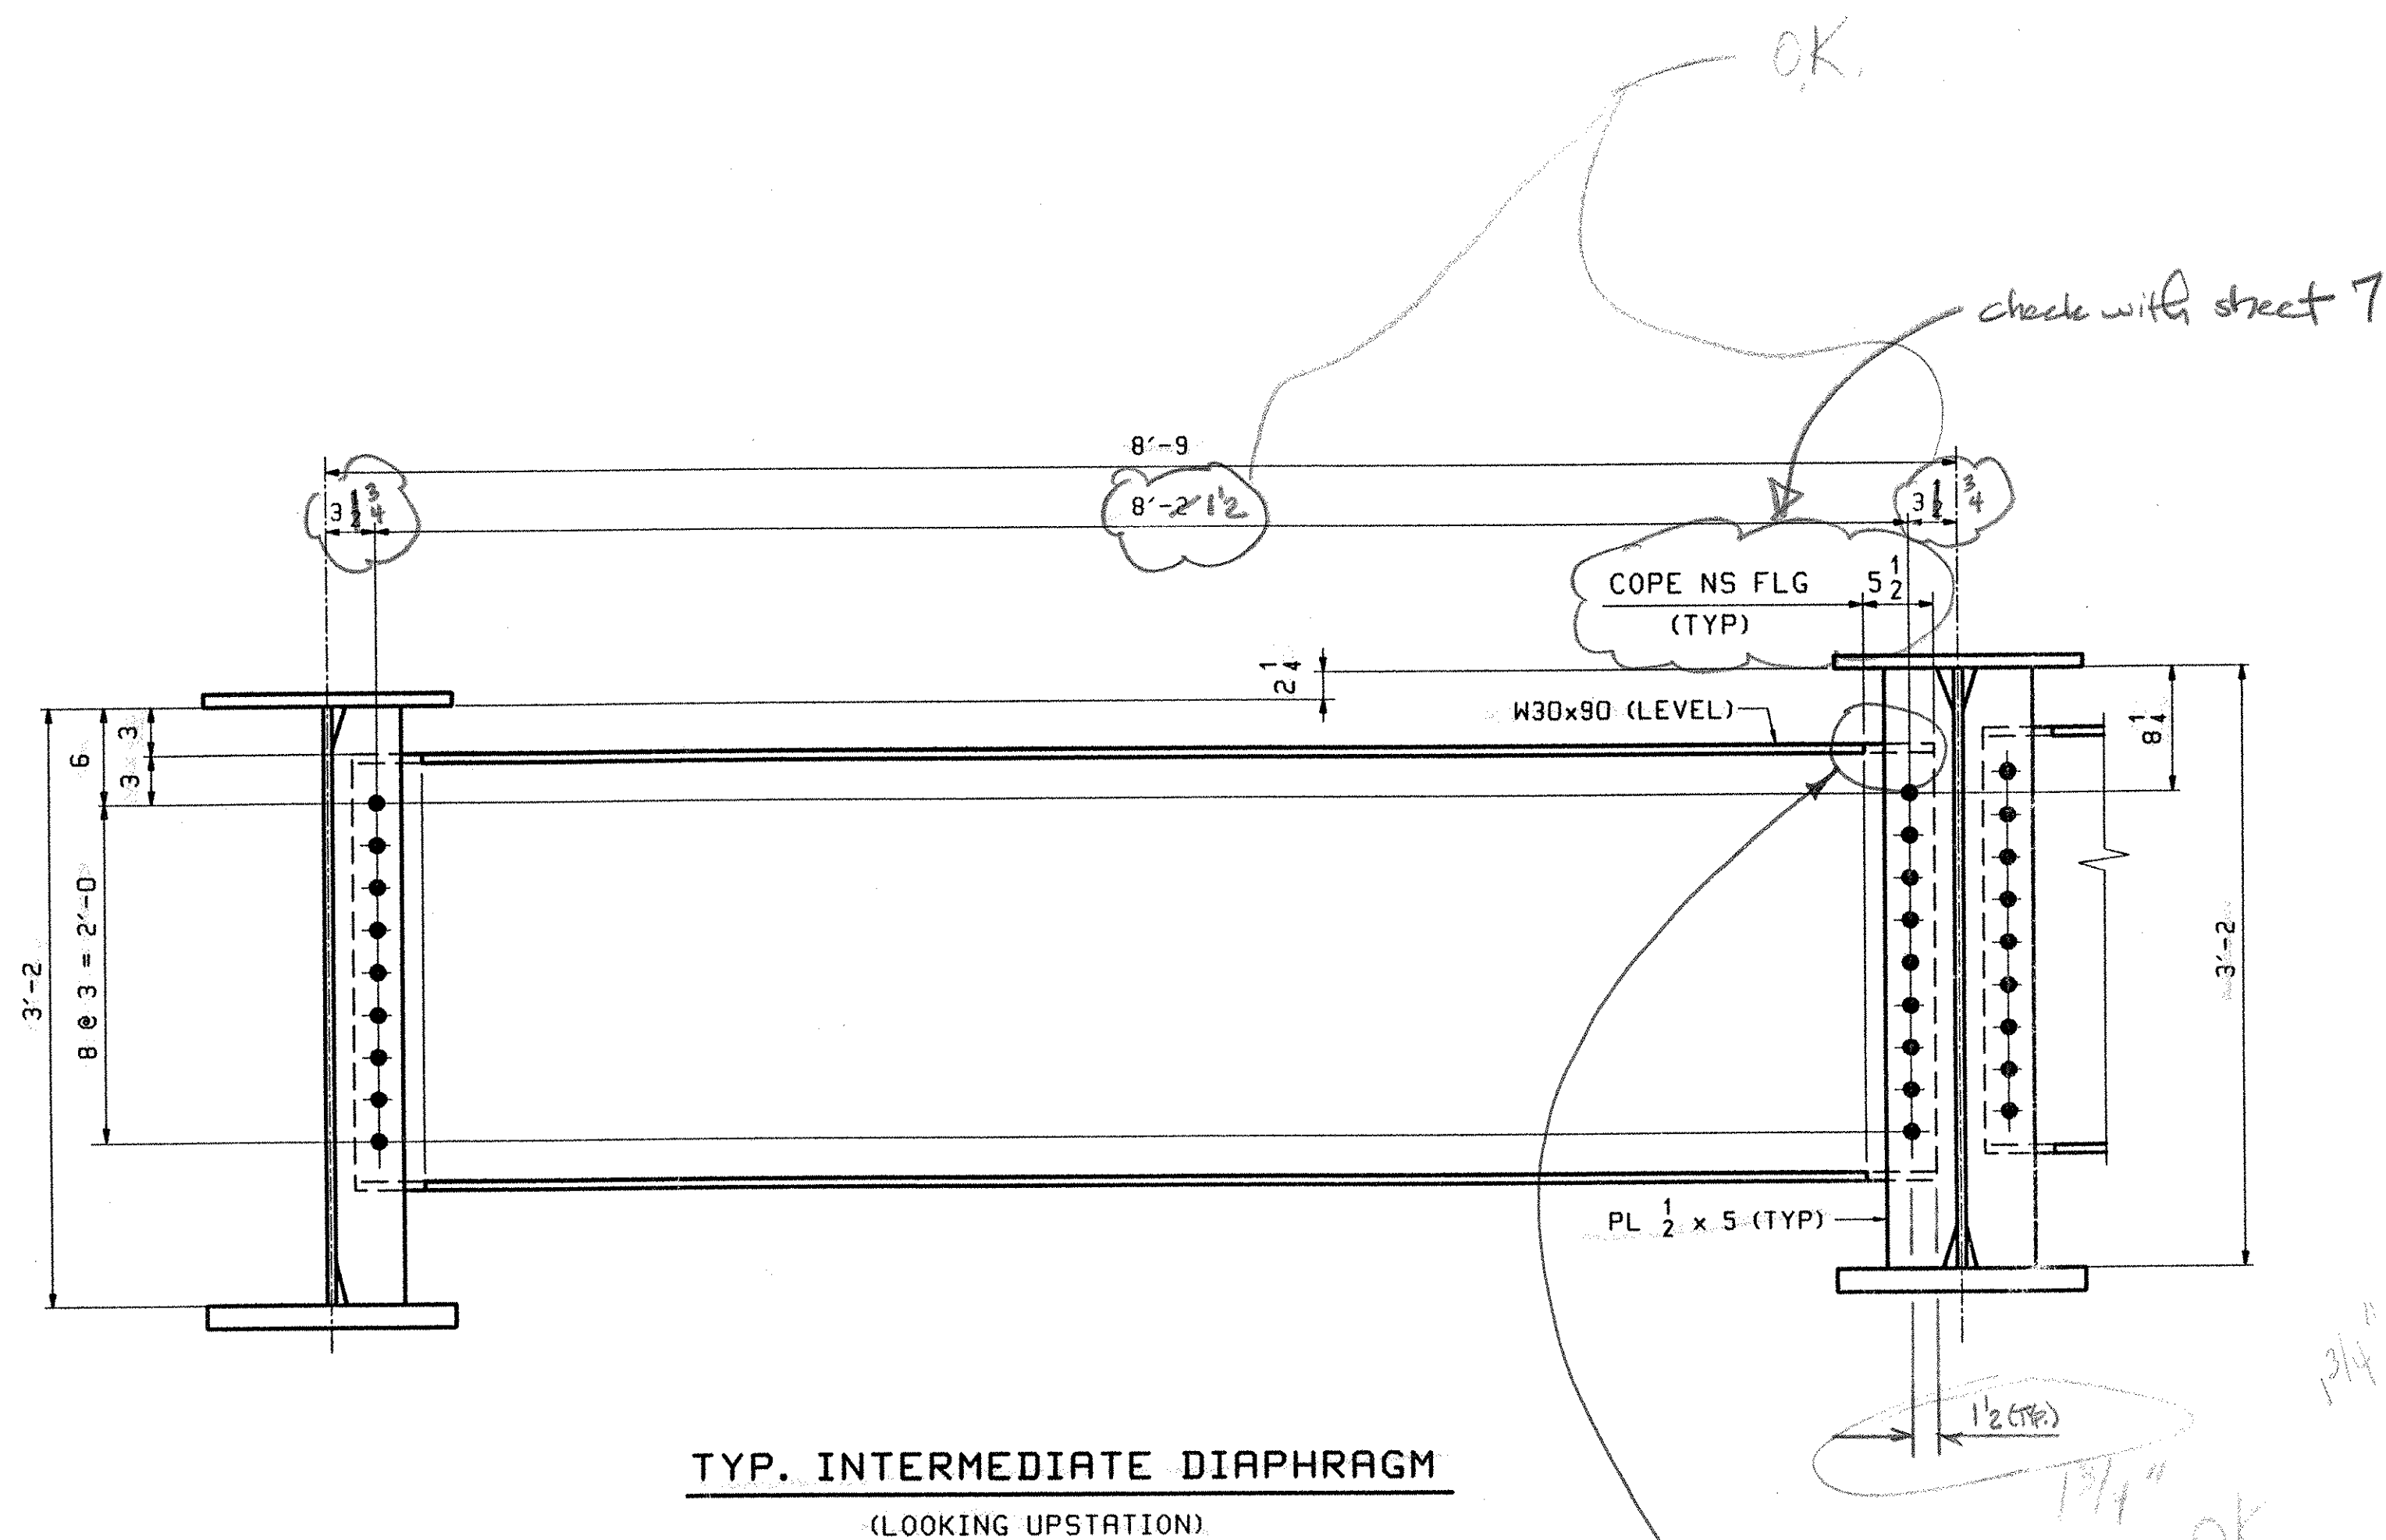


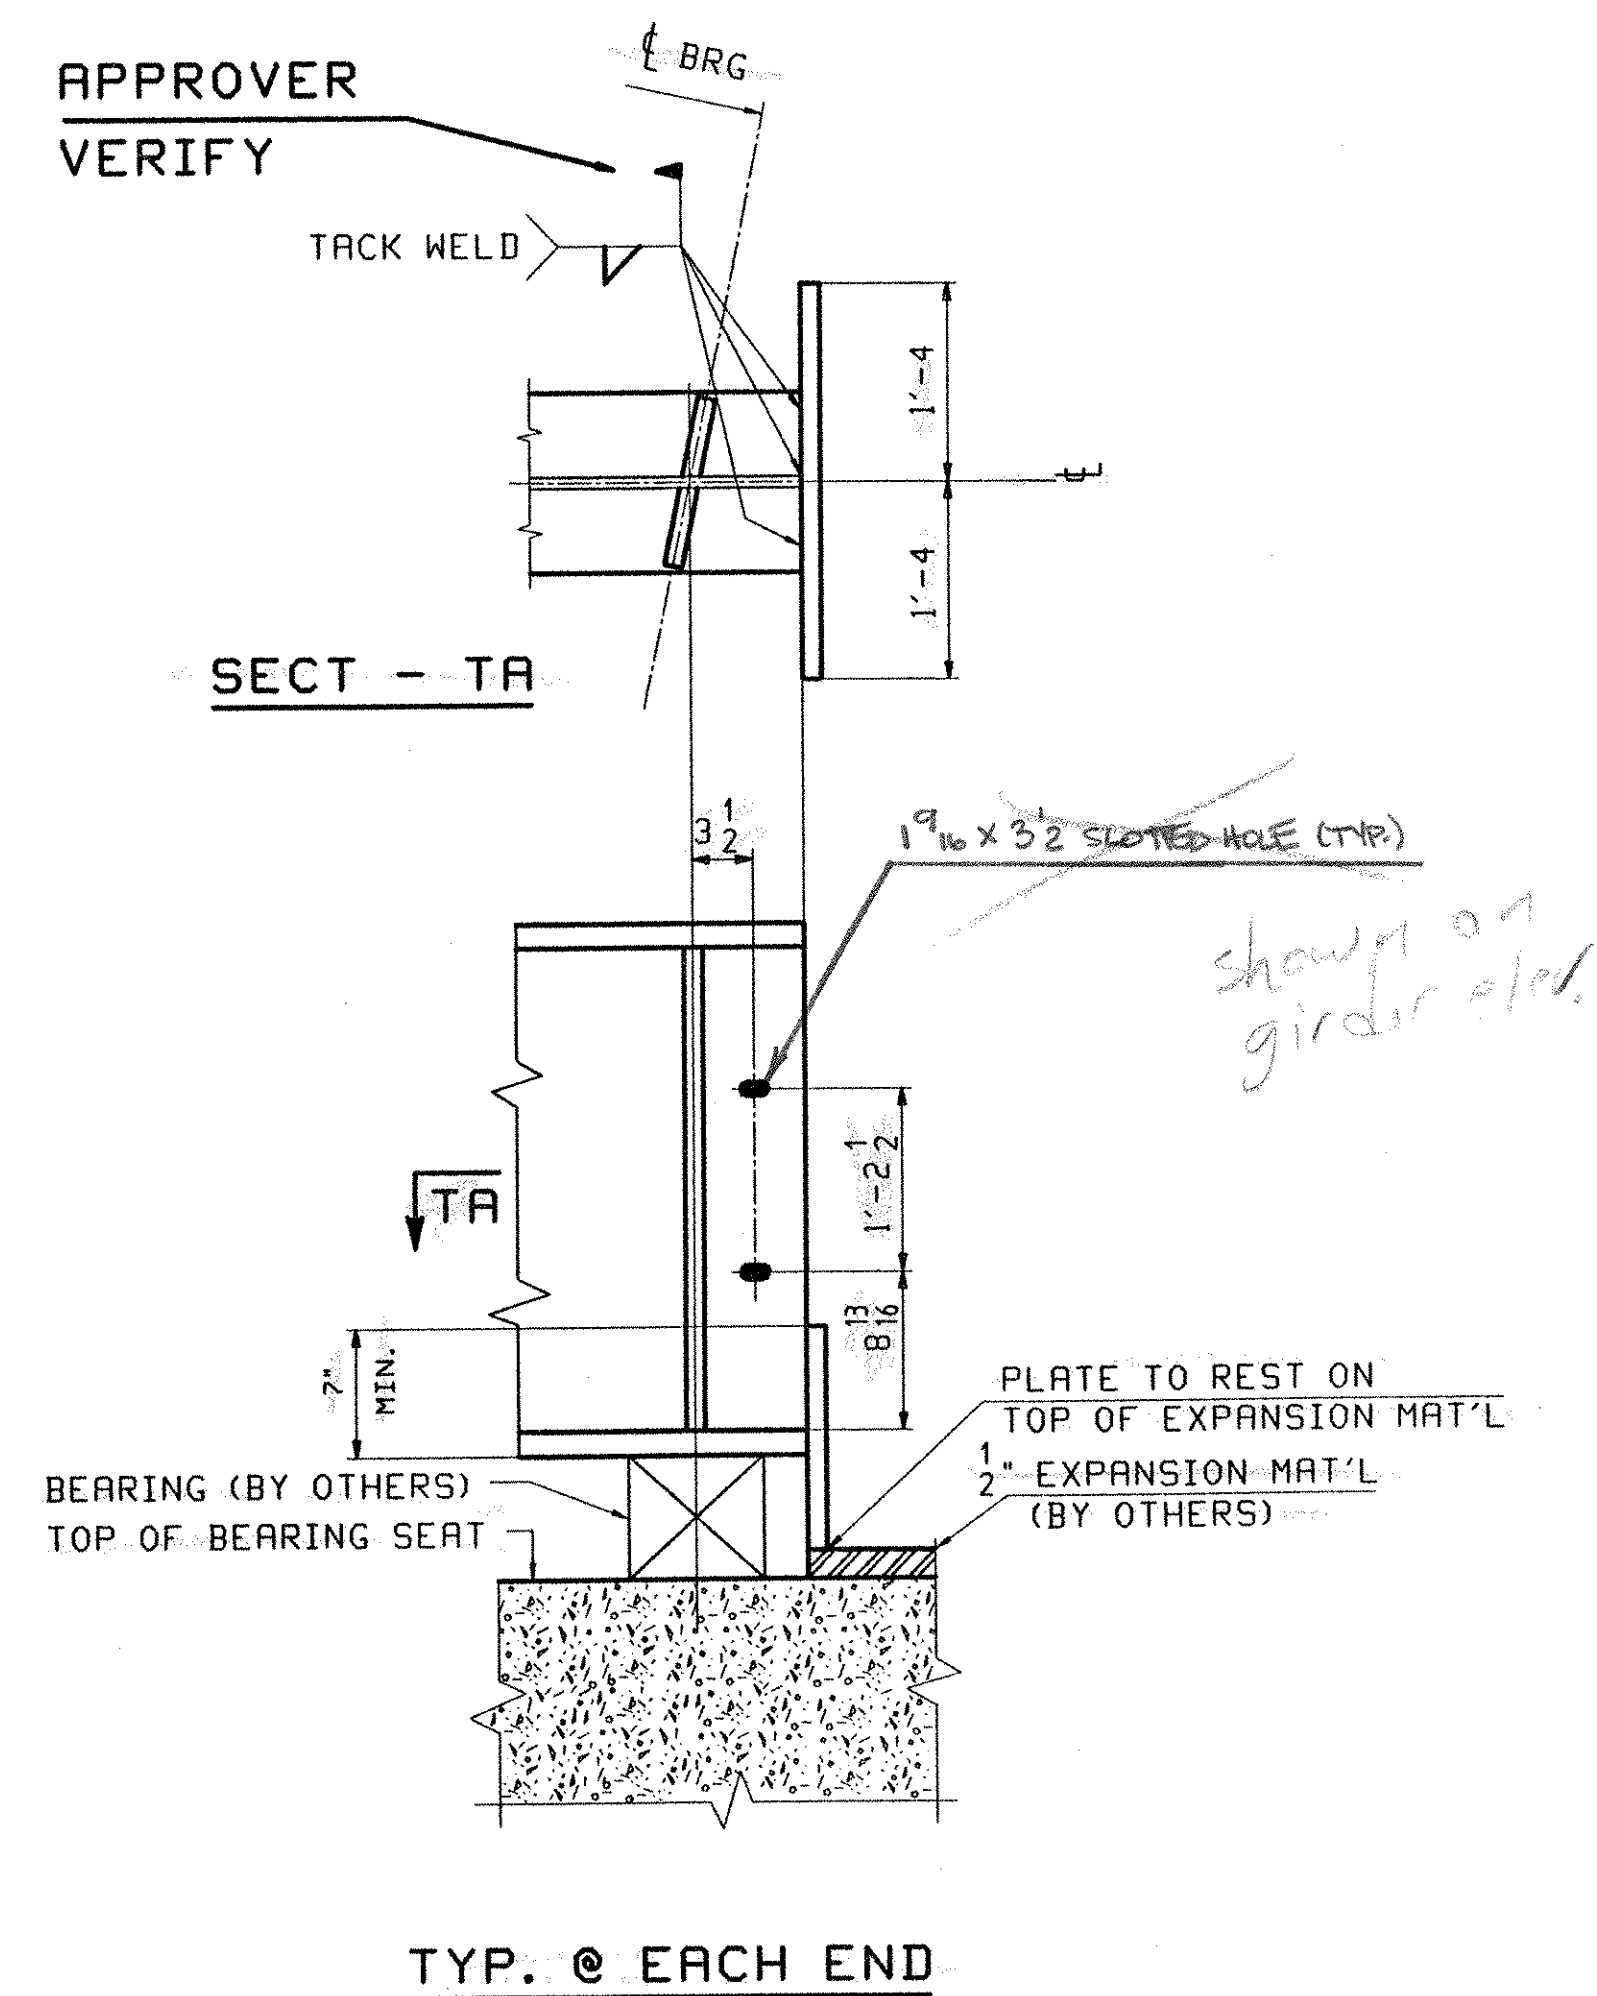

SHOP NOTE
REENTRANT CUTS AT FLANGE
COPIES TO HAVE A 2 INCH MIN.
RADIUS (TYP). CUT NS FLANGE
FLUSH

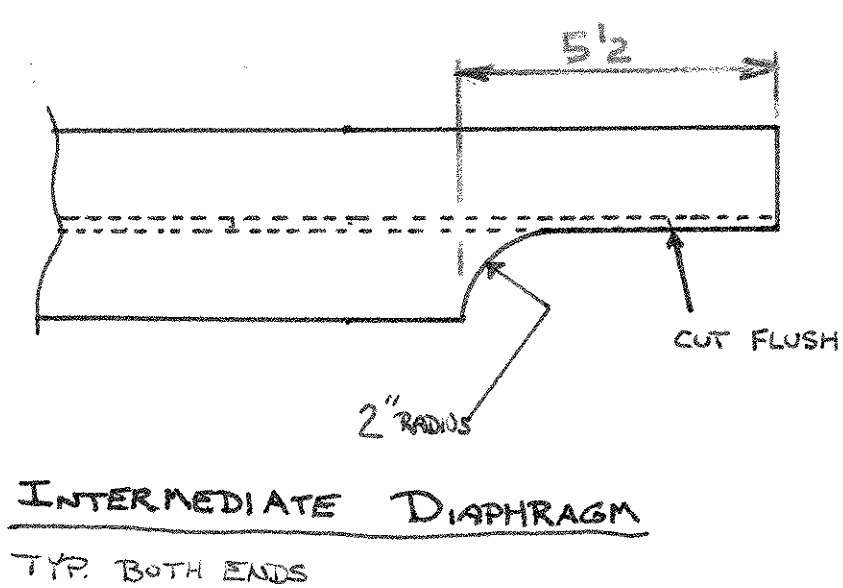

DETAILER NOTE

ALL EDGE DISTANCES ARE 1 1/4" U.N.

**** NOTE ****
THE PURPOSE OF THIS DRAWING IS TO COORDINATE GEOMETRIC CONTROL INFORMATION AND CONNECTION SPACING. THIS DWG IS SUBMITTED FOR INFORMATION ONLY & IS NOT INTENDED FOR SHOP FABRICATION. DETAIL DWGS WILL SHOW ALL WELDING AND DIMENSIONS REQ'D FOR FABRICATION.

SCALE: 1 1/8" = 1'-0"

VAOT
RECEIVED
CHK'D BY *mg* OK'D BY *A.P.*
3-30-01 4-18-01
MAR 29 2001
RESUBMIT *mg* APPROVED *AS NOTED*
DATE 4-18-01

OUT FOR APPROVAL	3-26-01																		
OUT FOR APPROVAL																			
ISSUED TO SHOP																			
FIELD & OFFICE																			
REV.	REMARKS	DATE	DWN	CHK	APP	Q.A.	NO.	DIA.	LGT	TYPE	WASHER								
MATERIAL:	M270-GR. 50W	ELECTRODES:		HOLES:	15 16 U.N.	SHOP BOLTS:													
SURFACE PREP. & PAINT:																			
DESCRIPTION: DIAPHRAGM LAYOUT												DRAWN BY		DATE					
JOB: I-89 OVER VT 104												JAK		03/12					
BRIDGE 875 & 87-N												CHKD BY							
I-89 IMPROVEMENTS												WMJ		3/15					
FAIRFAX FRANKLIN COUNTY												APPROV BY							
TENSOR 2126												SUPERVISOR		W. J. GATTI					
PROJ NO. IM-089-3(27)												Q.A.							
CUSTOMER: VERMONT AGENCY OF TRANSPORTATION																			
CASCO BAY STEEL STRUCTURES, INC.												JOB NO.		DRG. NO.					
75 SPRING HILL ROAD SACO, MAINE 04072												131		TD1					
PHONE (207) 282-7360 FAX. (207) 282-1179												442		REV. Δ					