


OK to use $\frac{7}{8}$ "
 $\frac{13}{16}$ not readily
available
preferred

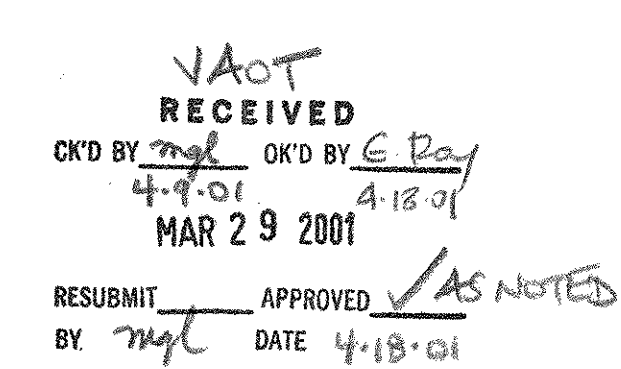

1. FOR GIRDER STANDARD DETAILS SEE DRAWING XI.
2. FOR CAMBER AND FLANGE DIAGRAMS SEE DRAWING CI.
3. FOR GENERAL NOTES SEE DRAWING GNI.

DESCRIPTION: GIRDER IGI		DRAWN BY	DATE
	JOB: I-89 OVER VT 104	JAK	03/16
	BRIDGE 875 & 87 N	CHKD BY	
	I-89 IMPROVEMENTS	JB	3/22/01
	FAIRFAX FRANKLIN COUNTY	APPROV BY	
		SUPERVISOR	W. J. GAT
PROJ NO. IM 089-3(27)		O.R.	
CUSTOMER: VERMONT AGENCY OF TRANSPORTATION			
CASCO BAY STEEL STRUCTURES, INC.		JOB NO.	DRG. NO.
75 SPRING HILL ROAD SACO, MAINE 04072		131	1
PHONE (207) 282-7360 FAX. (207) 282-1179		447	REV. 1