


140T
RECEIVED
CK'D BY mgf OK'D BY E. Ray
4-18-01 4-18-01
MAR 29 2001
RESUBMIT _____ APPROVED ✓ AS NOTED
BY mgf DATE 4-18-01

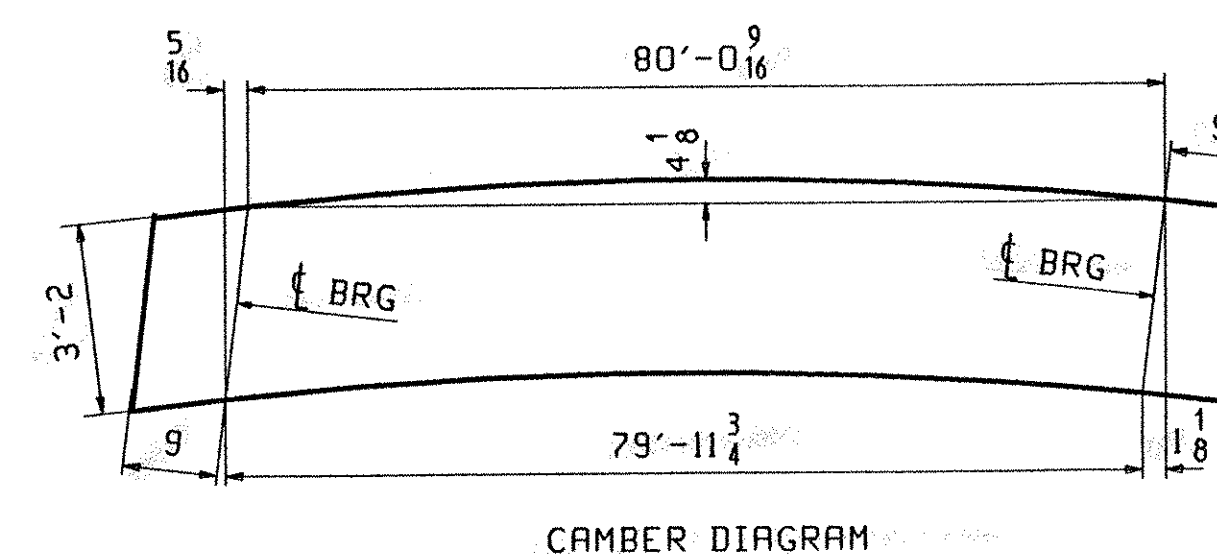

Thu Mar 23 11:06:18 EST 2001 /users/10be/2126/3 1 Rev 0