




HEADWALL H1 PLAN VIEW

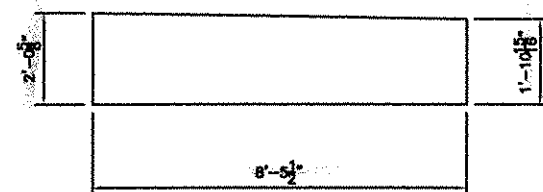


HEADWALL H1 ELEVATION VIEW

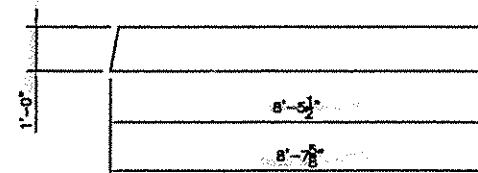


HEADWALL H2 PLAN VIEW

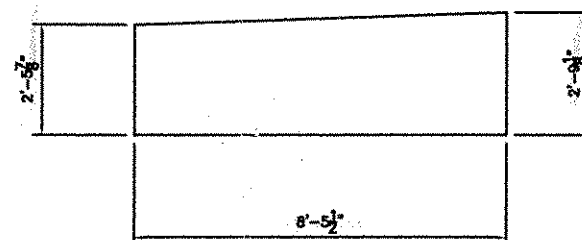


HEADWALL H2 ELEVATION VIEW

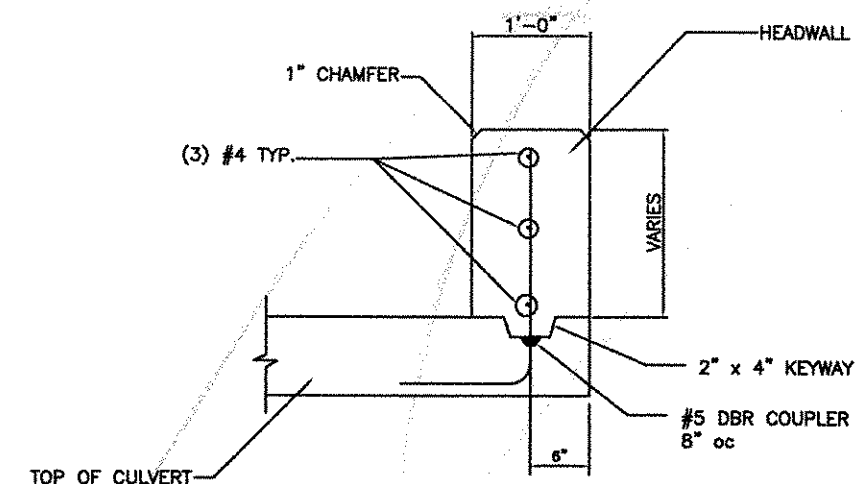


HEADWALL DETAIL

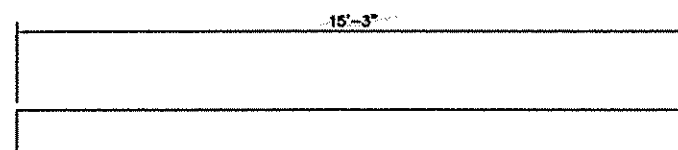


CUTOFF WALL C1 PLAN VIEW

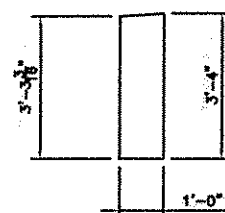


CUTOFF WALL C1 END VIEW

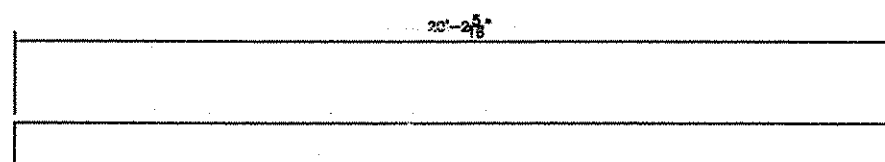

CUTOFF WALL C2 PLAN VIEW

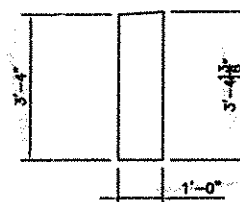


CUTOFF WALL C2 END VIEW

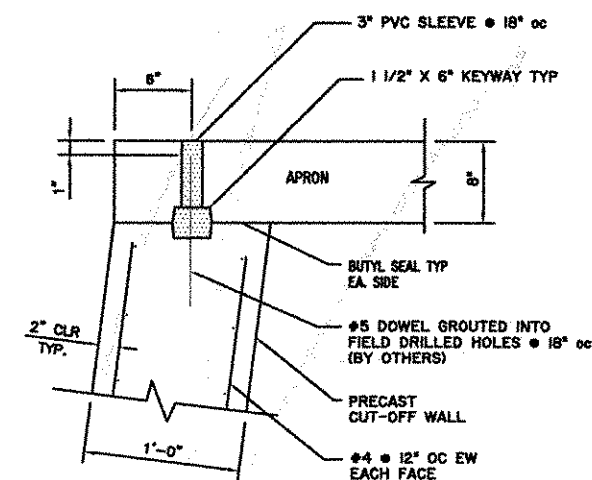

CUTOFF WALL DETAIL

V.A.O.T.
RECEIVED
CKD BY C. Ray 3.21.01
MAR 21 2001
APPROVED [Signature] 3.29.01
DATE 3.29.01

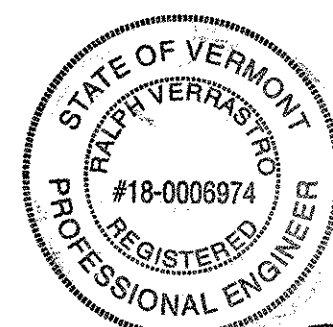

Ralph Verrastro
2/21/01

 DELTA ENGINEERS, P.C. ENGINEERS • ARCHITECTS 104 COURT STREET, BURLINGTON, VT 05401-3344 TEL: (802) 238-6600 FAX: (802) 238-6650 E-MAIL: info@deltaengineers.com	TOWN OF ST. ALBANS, VT.	
	7'-0" x 5'-0" x 14'-0" DRIVE BOX CULVERT	
CONTRACTOR:	ENGINEER:	SHEET 3 OF 3 CAMP PRECAST CONCRETE PRODUCTS
DWN BY: GAS	CKD BY: RET	
DWG ID: 1004-01 SCALE: NONE		REV: 0 DATE: 2/12/01