


- MSE Wall #2
 WW#2 & #3 Step Points
- #1 elev = 588.80
 - #2 elev = 586.34
 - #3 elev = 583.88
 - #4 elev = 581.42
 - #5 elev = 578.96
 - #6 elev = 576.50
 - #7 elev = 574.04
 - #8 elev = 571.58
 - #9 elev = 569.12
 - #10 elev = 566.66
 - #11 elev = 564.20

- MSE #1
 WW#1 & WW#2 Step Points
- #1 elev = 571.84
 - #2 elev = 585.48
 - #3 elev = 582.92
 - #4 elev = 580.36
 - #5 elev = 577.80
 - #6 elev = 575.24
 - #7 elev = 572.68
 - #8 elev = 570.12

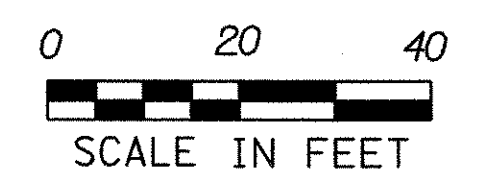

PROJECT NAME: Fairfax-Fairfield-St.Albans
 PROJECT NUMBER: IM 089-3 (27)
 FILE NAME: 87a007/survey/xa007hsv.dgn PLOT DATE: 21-MAR-2003
 PROJECT LEADER: R. Bullock DRAWN BY:
 DESIGNED BY: CHECKED BY:
 SHEET 1 OF 1468