



INDEX OF SHEETS
(SEE SHEET 2)

STATE OF VERMONT AGENCY OF TRANSPORTATION

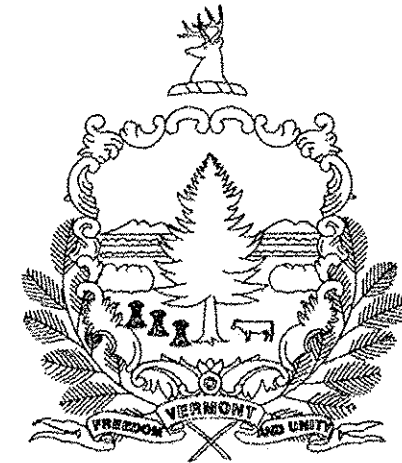

PROPOSED IMPROVEMENT TOWNS OF ST. ALBANS AND SWANTON COUNTY OF FRANKLIN INTERSTATE ROUTE 89

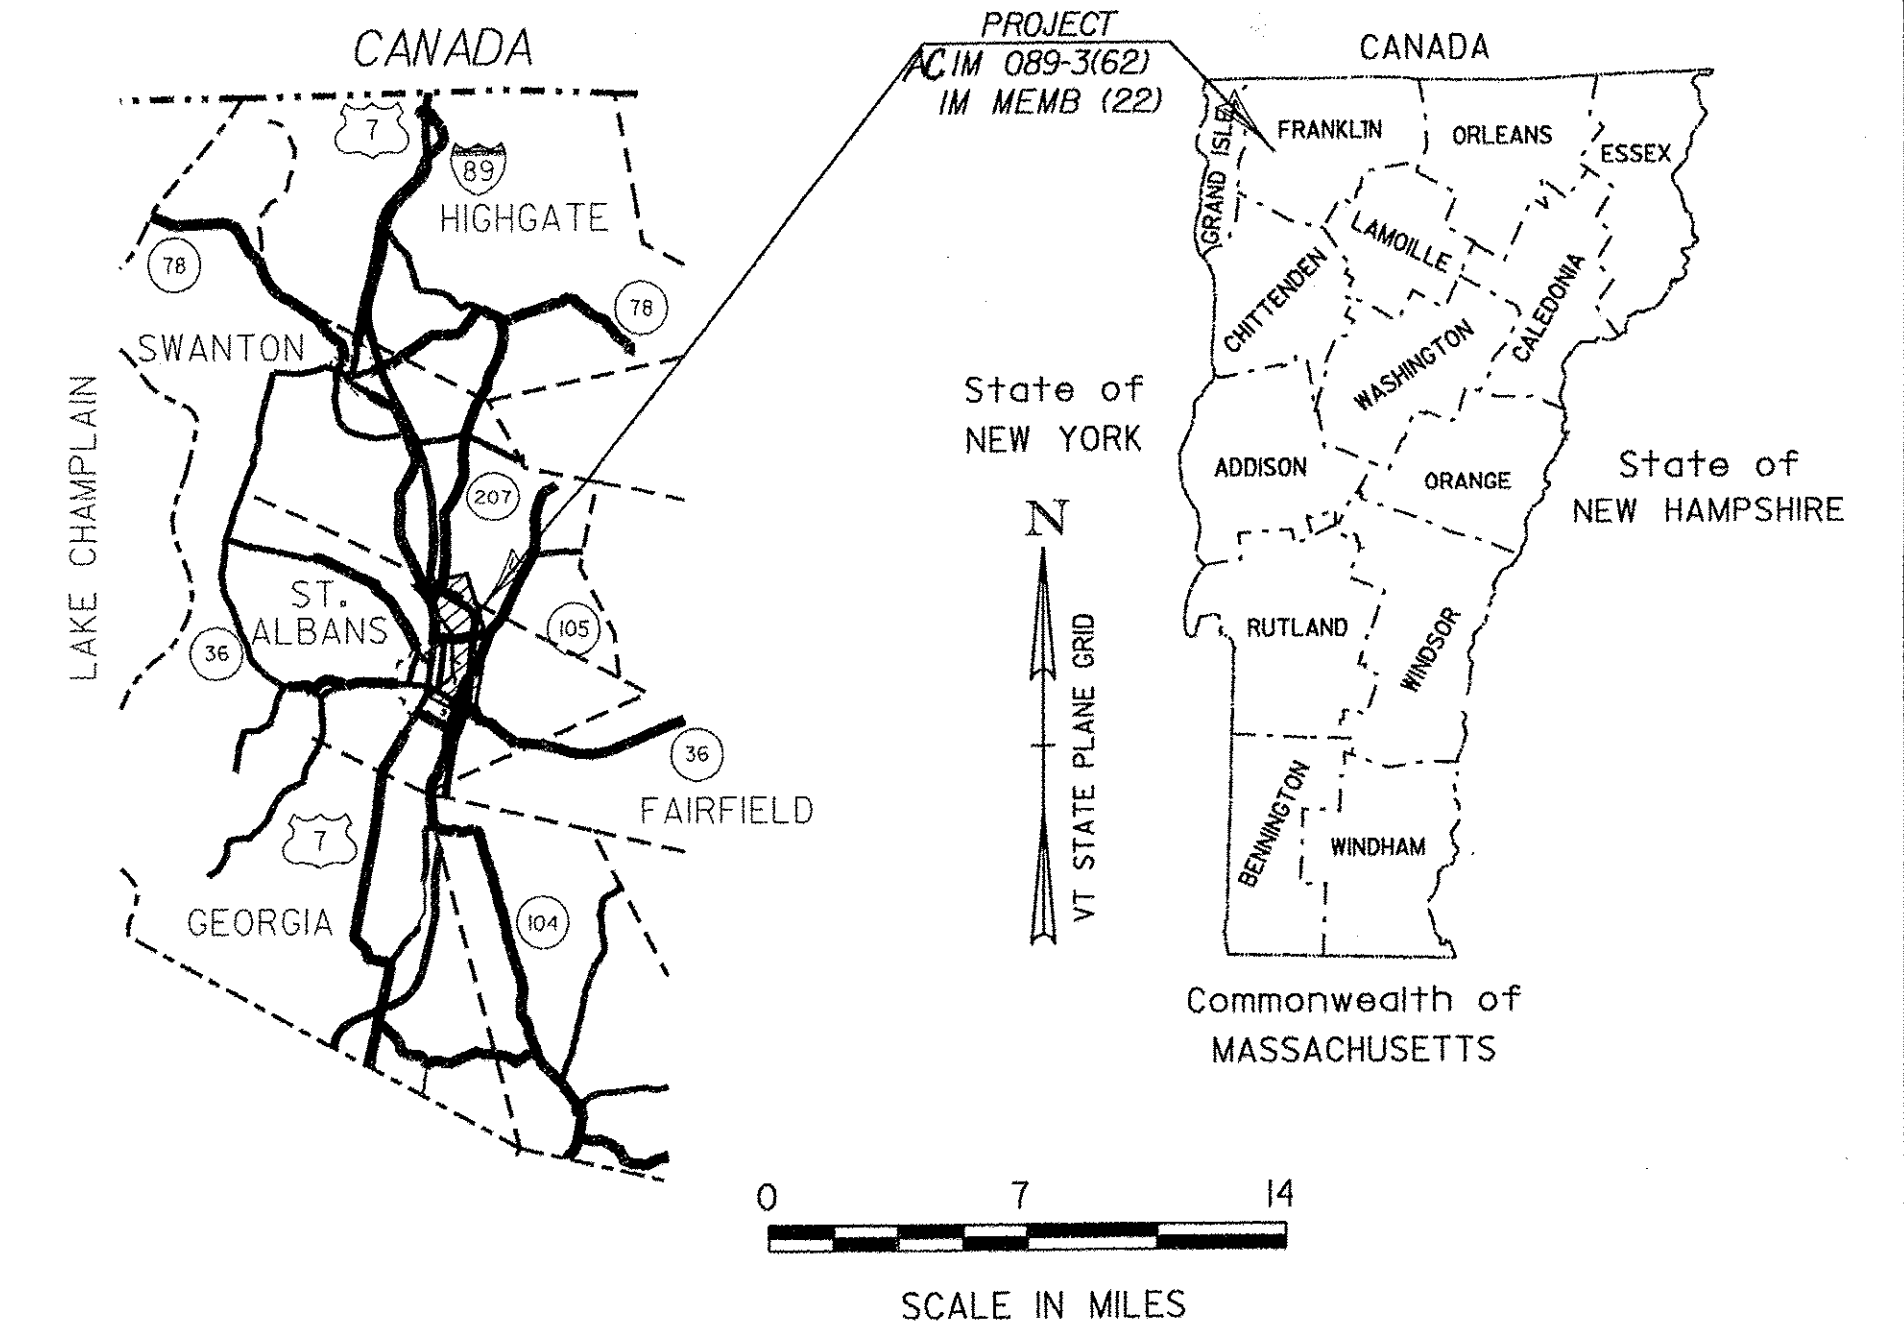



RECORD PLANS	
CONTRACTOR:	PIKE INDUSTRIES, INC. - BERLIN, VT
RESIDENT ENGINEER:	JON DAY
CONSTRUCTION BEGAN:	APRIL 19, 2010
CONSTRUCTION COMPLETE:	NOVEMBER 12, 2010
RECORD PLANS BY:	JON DAY & AMOS KEMPTON
I HEREBY CERTIFY THAT ALL THE CONSTRUCTION REQUIRED BY THIS SET OF DRAWINGS HAS BEEN ACCOMPLISHED AS INDICATED HEREIN.	
BY:	<i>John P. Day</i> RESIDENT ENGINEER
DATE:	09-22-11
NOTE: Any further information concerning final quantities, amounts or other details relative to this project may be found at Central Files in the electronic archives.	

ST. ALBANS - SWANTON
ACIM 089-3(62)
SEE SHEET 7
FOR ADDITIONAL PROJECT INFORMATION

ST. ALBANS
IM MEMB (22)
SEE SHEET 100
FOR ADDITIONAL PROJECT INFORMATION

NB MM 114.10 (NB STA. 3442+29)
SB MM 114.10 (SB STA. 3442+54)
BEGIN PROJECT ACIM 089-3(62)

NB MM 117.98 (NB STA. 3647+15)
SB MM 117.98 (SB STA. 3647+40)
END PROJECT ACIM 089-3(62)

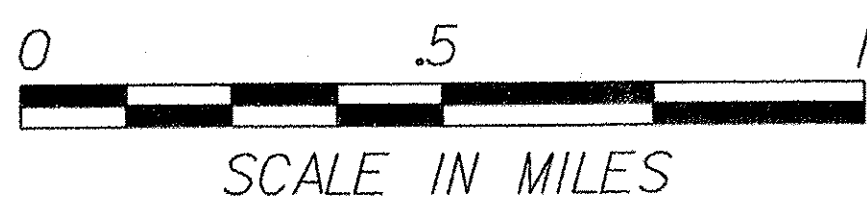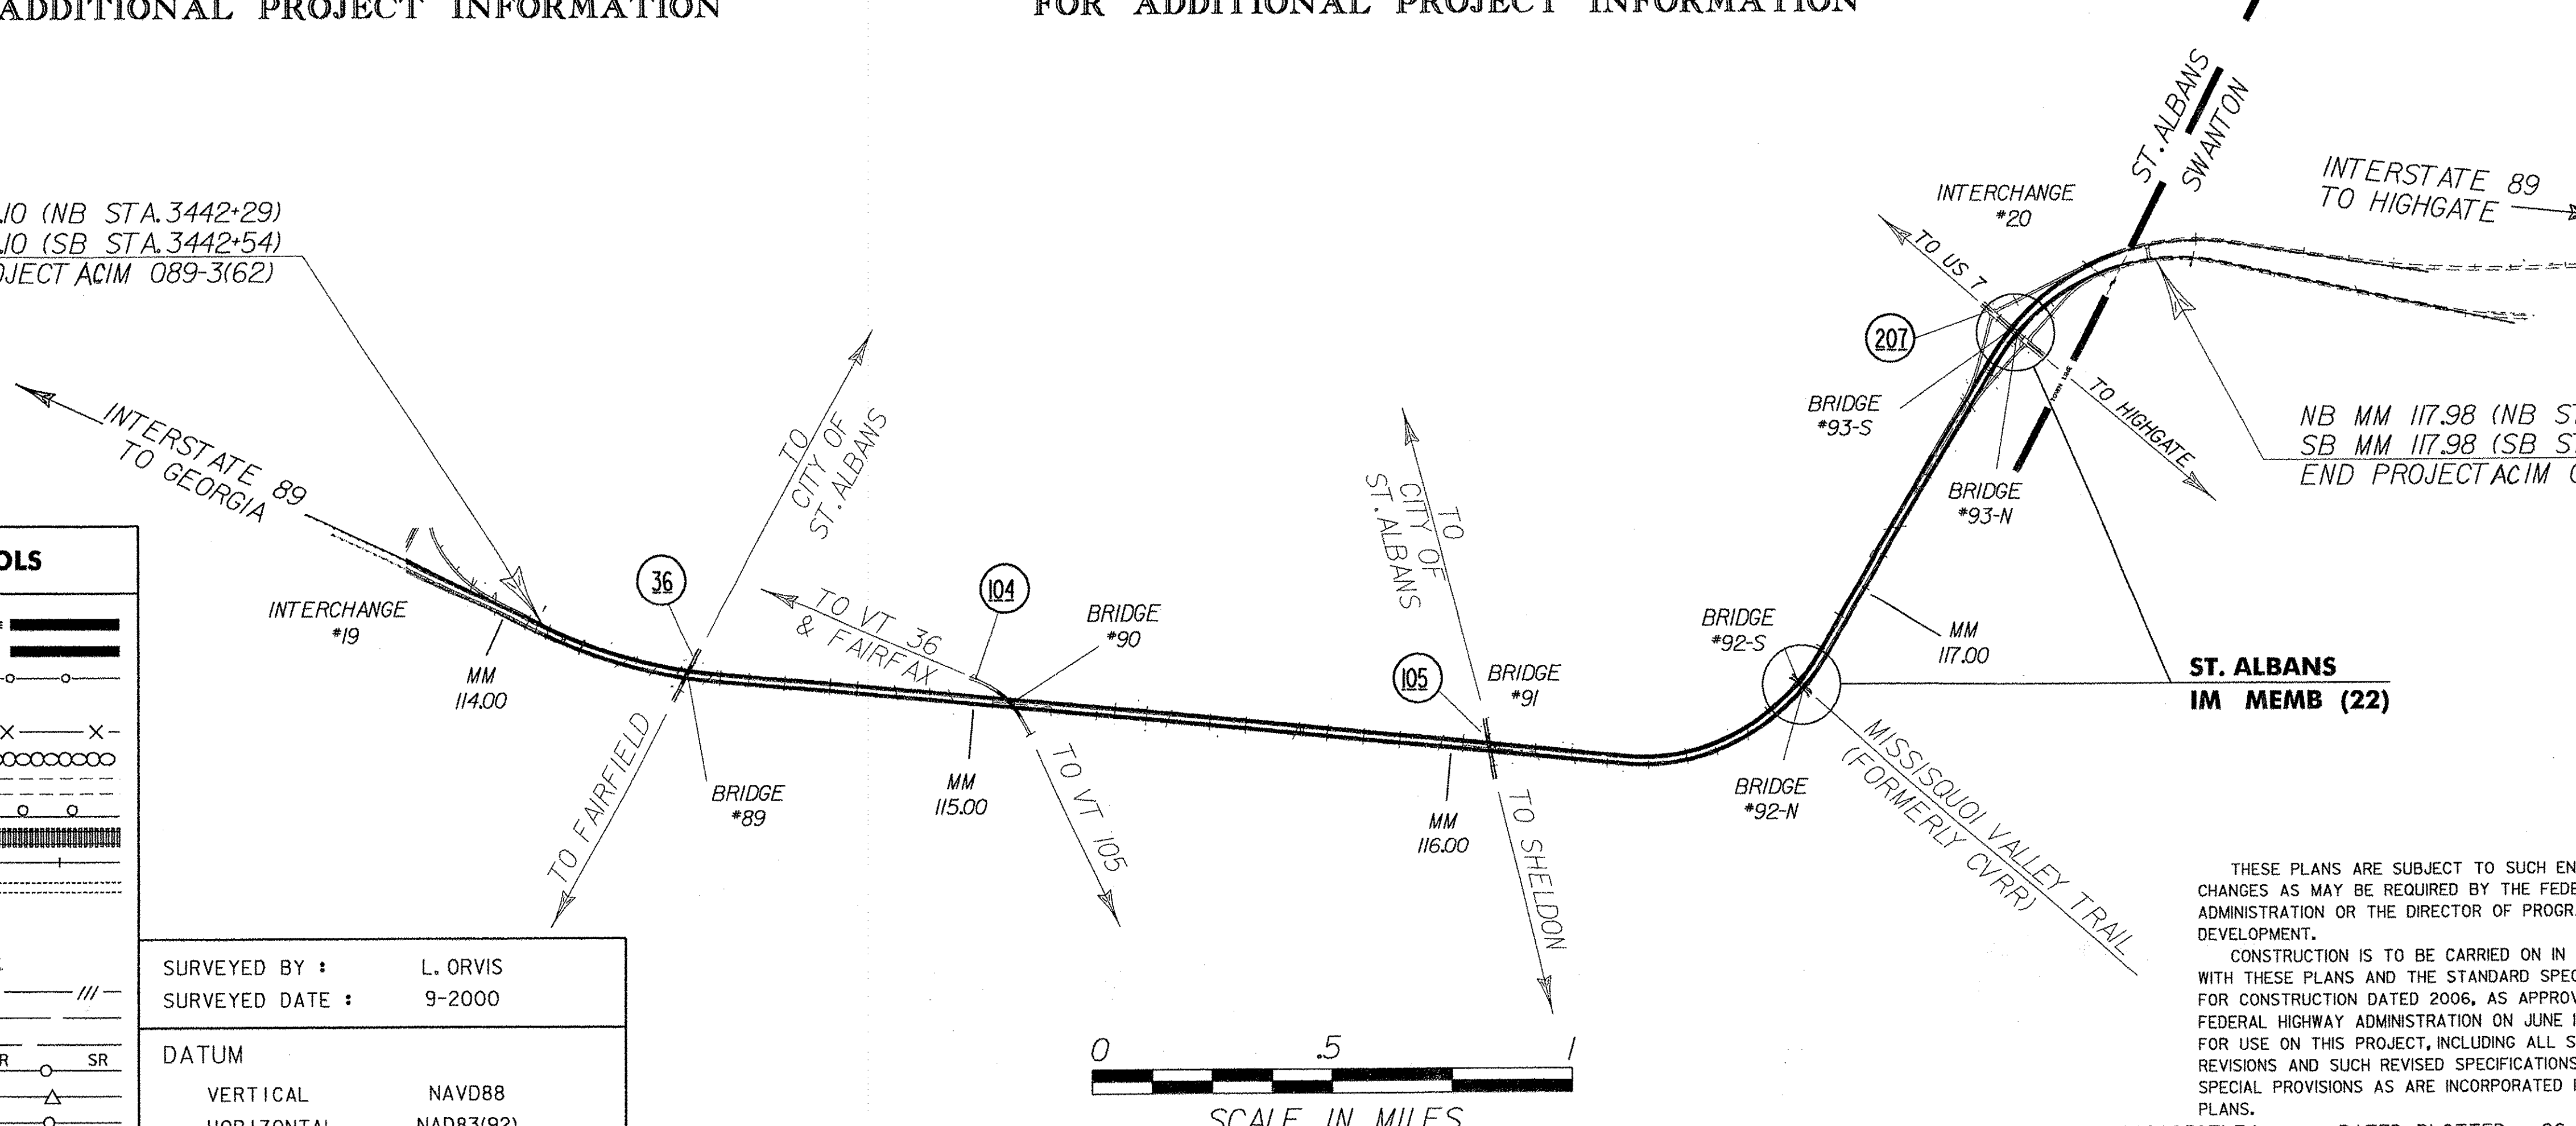

CONVENTIONAL SYMBOLS	
COUNTY LINE	
TOWN LINE	
LIMITS OF ACCESS	
POINT OF ACCESS	
FENCE LINE	
STONE WALL	
TRAVELED WAY	
GUARD RAIL	
RAILROAD	
SURVEY LINE	
CULVERT	
POWER POLE	
TELEPHONE POLE	
TREES	
CONTROL OF ACCESS	
PROPERTY LINE	
R.O.W. TAKING LINE	
SLOPE RIGHTS	
TOP OF CUT	
TOE OF SLOPE	

SURVEYED BY : L. ORVIS
SURVEYED DATE : 9-2000

DATUM
VERTICAL NAVD88
HORIZONTAL NAD83(92)

THESE PLANS ARE SUBJECT TO SUCH ENGINEERING CHANGES AS MAY BE REQUIRED BY THE FEDERAL HIGHWAY ADMINISTRATION OR THE DIRECTOR OF PROGRAM DEVELOPMENT.

CONSTRUCTION IS TO BE CARRIED ON IN ACCORDANCE WITH THESE PLANS AND THE STANDARD SPECIFICATIONS FOR CONSTRUCTION DATED 2006, AS APPROVED BY THE FEDERAL HIGHWAY ADMINISTRATION ON JUNE 15, 2006 FOR USE ON THIS PROJECT, INCLUDING ALL SUBSEQUENT REVISIONS AND SUCH REVISED SPECIFICATIONS AND SPECIAL PROVISIONS AS ARE INCORPORATED IN THESE PLANS.

D96A058TLE.I DATED PLOTTED: 26-AUG-2009

DEPARTMENT OF TRANSPORTATION FEDERAL HIGHWAY ADMINISTRATOR	APPROVED <i>Mark D. Richter</i> DATE 9-22-09
DIRECTOR OF PROGRAM DEVELOPMENT	APPROVED <i>John P. Day</i> DATE 8/26/09
PROJECT MANAGER :	KEN ROBIE
PROJECT NAME AND NUMBER :	ST. ALBANS - SWANTON ACIM 089-3(62) ST. ALBANS IM MEMB(22)
SHEET 1 OF 117 SHEETS	