


REMOVAL OF EXISTING FENCE  
 NB 3457+64 ~ NB 3489+73 RT  
 SB 3458+67 ~ SB 3491+93 LT

WOVEN WIRE FENCE, W/STEEL POSTS  
 69+00 NB 3457+64 ~ NB 3489+73 RT 84+00  
 69+00 SB 3458+67 ~ SB 3491+93 LT 84+00


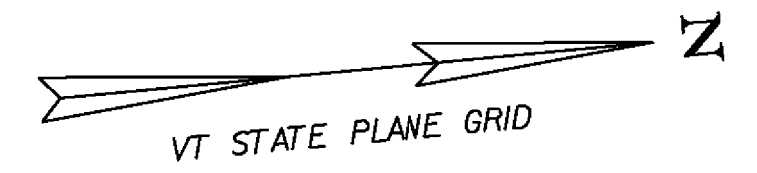


MATCH LINE SB STA. 3469+00

MATCH LINE SB STA. 3484+00

MATCH LINE NB STA. 3469+00

MATCH LINE NB STA. 3484+00

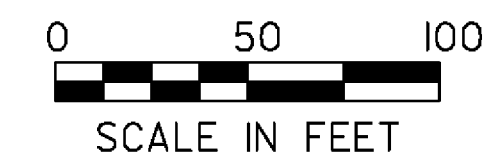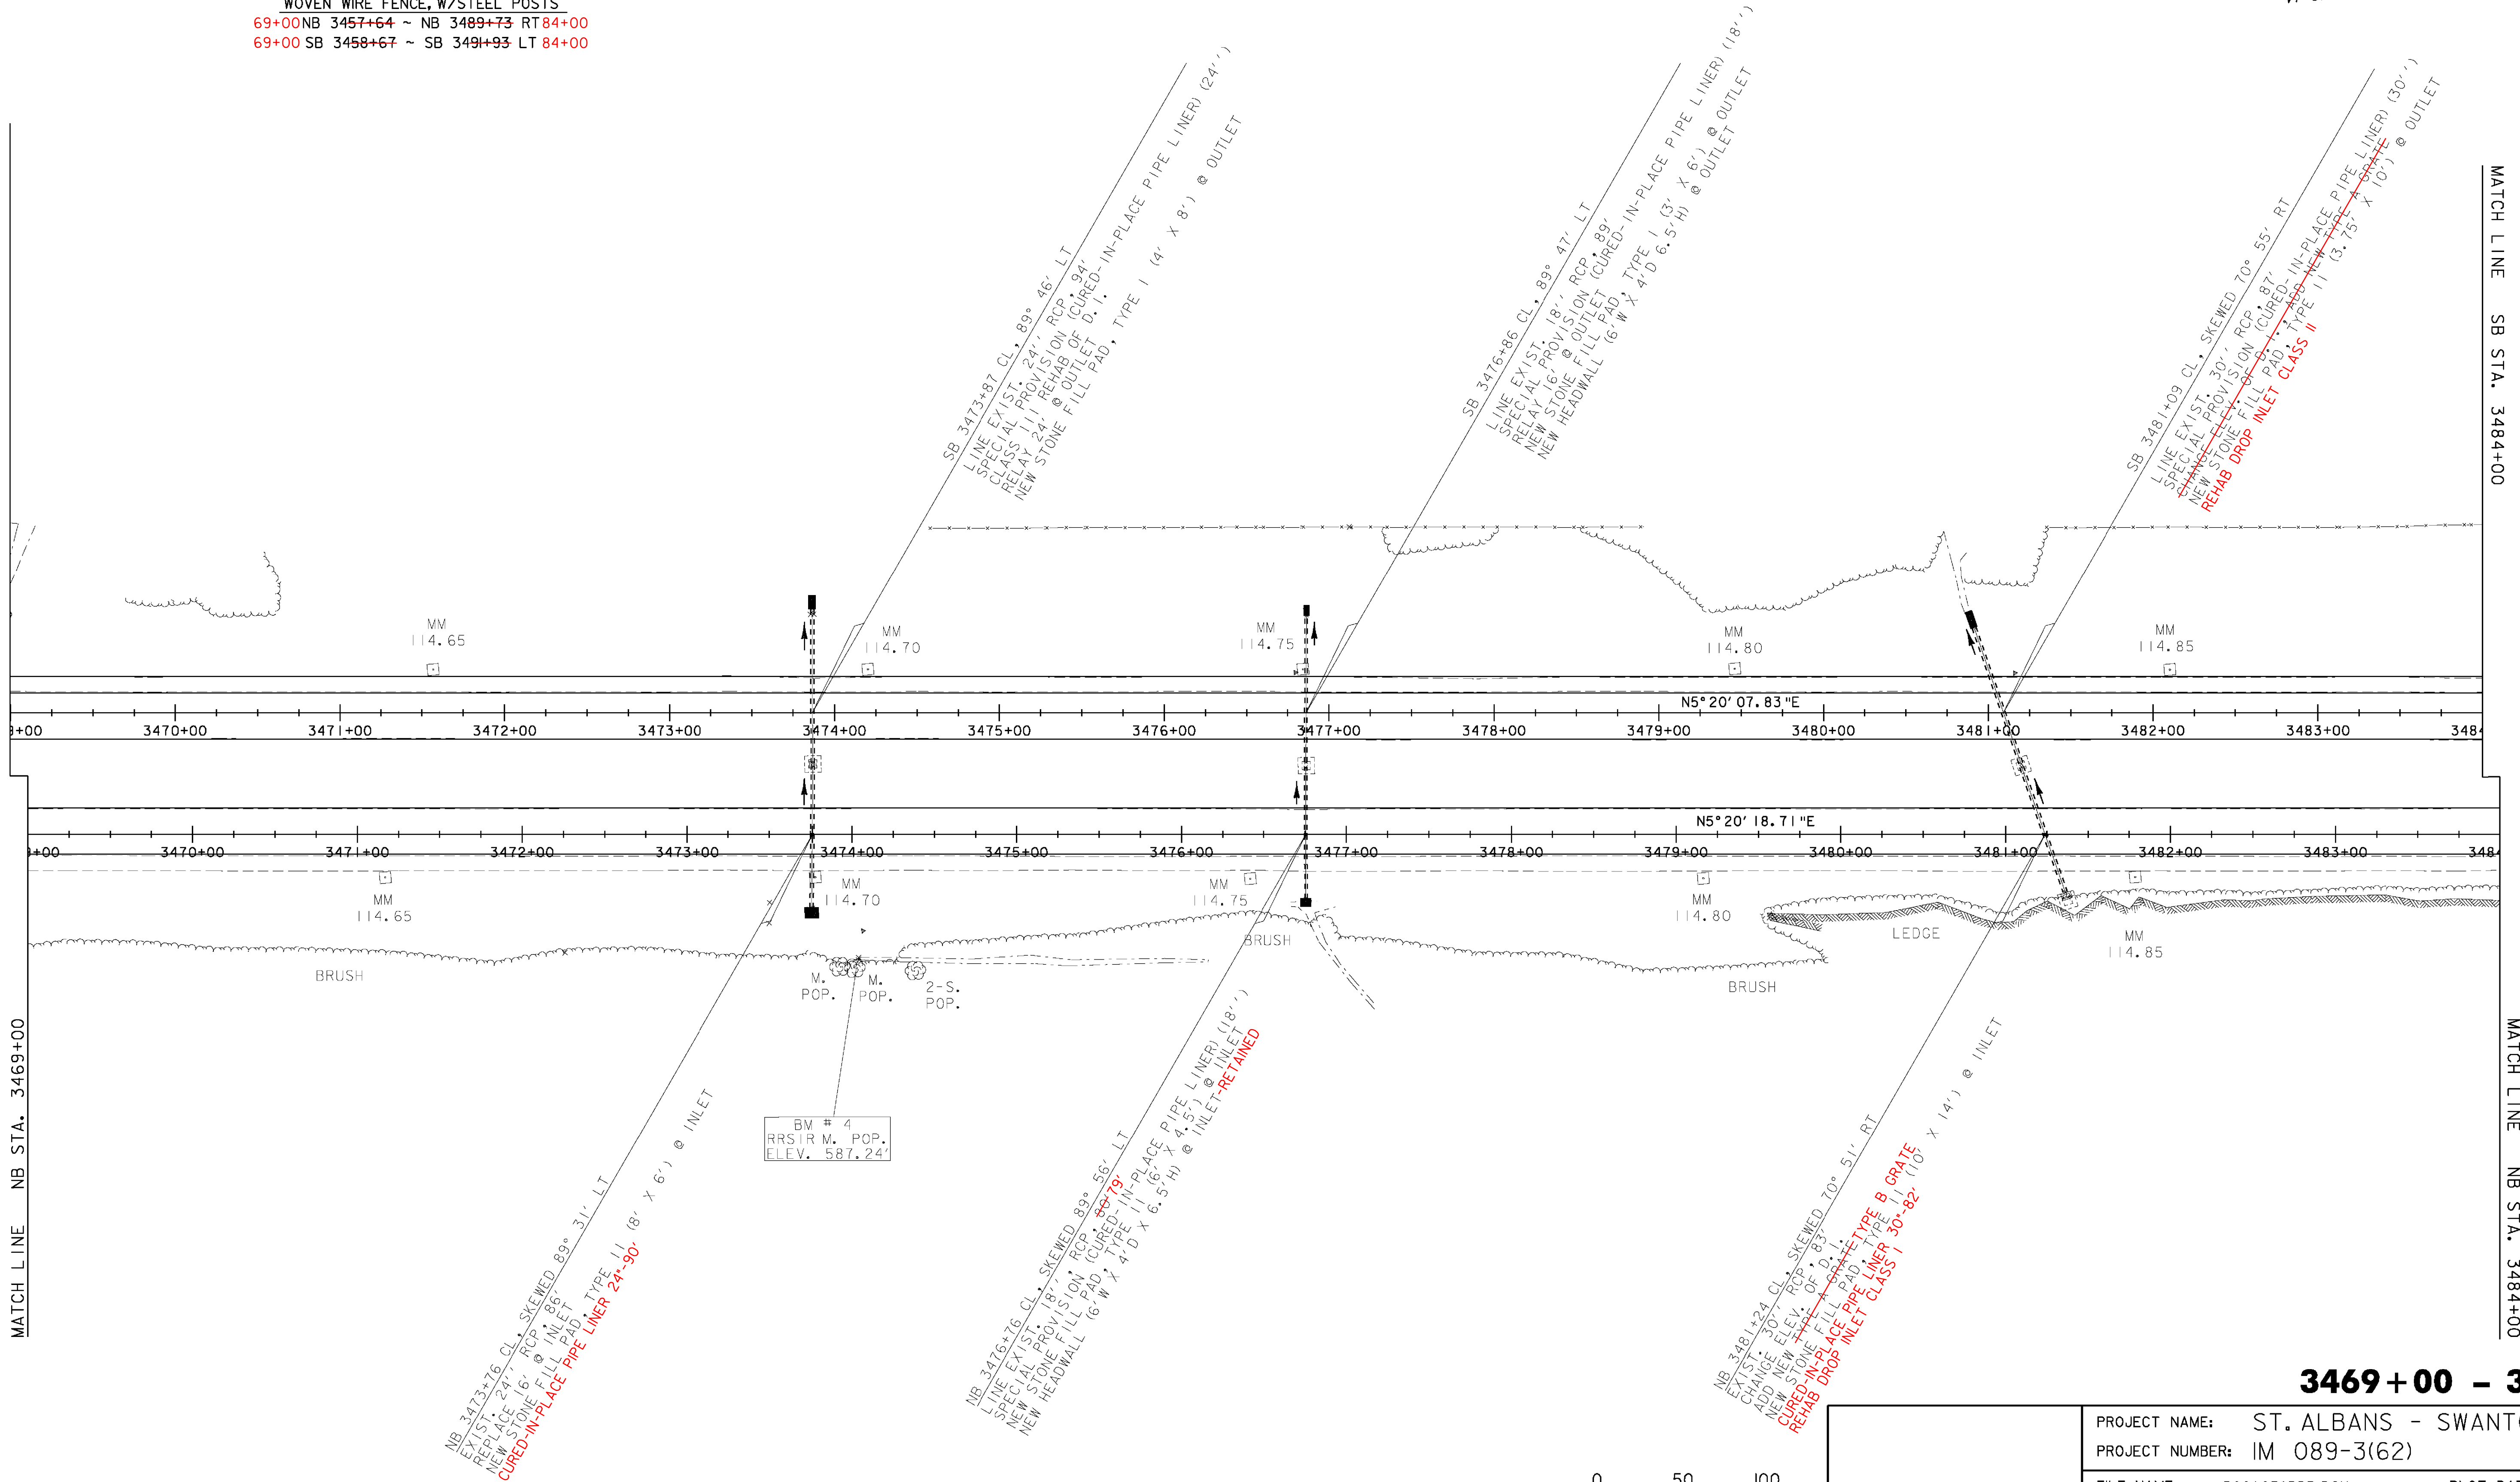

**LAYOUT SHEET #4**

**3469+00 - 3484+00**

PROJECT NAME: ST. ALBANS - SWANTON  
 PROJECT NUMBER: IM 089-3(62)

FILE NAME: D96A058BDR.DGN  
 PROJECT LEADER: K. ROBBIE  
 DESIGNED BY: P. BEYOR  
 D96A058L03.J

PLOT DATE: 26-AUG-2009  
 DRAWN BY: P. BEYOR  
 CHECKED BY: A. BOMBARDIER  
 SHEET 25 OF 117