


REMOVAL OF EXISTING FENCE
 NB 3495+11 ~ NB 3546+82 RT
 SB 3492+51 ~ SB 3546+22 LT

CHAIN LINK FENCE, 6 FEET
 3502+37 SB 3492+51 ~ SB 3514+00 LT
 NB 3495+11 ~ NB 3508+27 RT
 99+00

WOVEN WIRE FENCE, W/STEEL POSTS
 NB 3508+27 ~ NB 3546+82 RT
 SB 3499+00 ~ SB 3502+37 LT

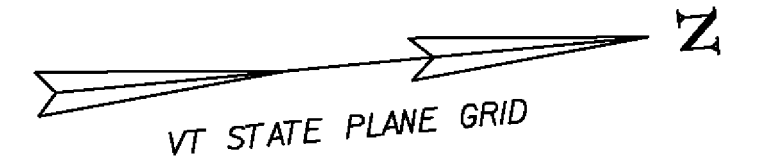


MATCH LINE SB STA. 3499+00

MATCH LINE SB STA. 3514+00


MATCH LINE SB STA. 3499+00

MATCH LINE NB STA. 3514+00

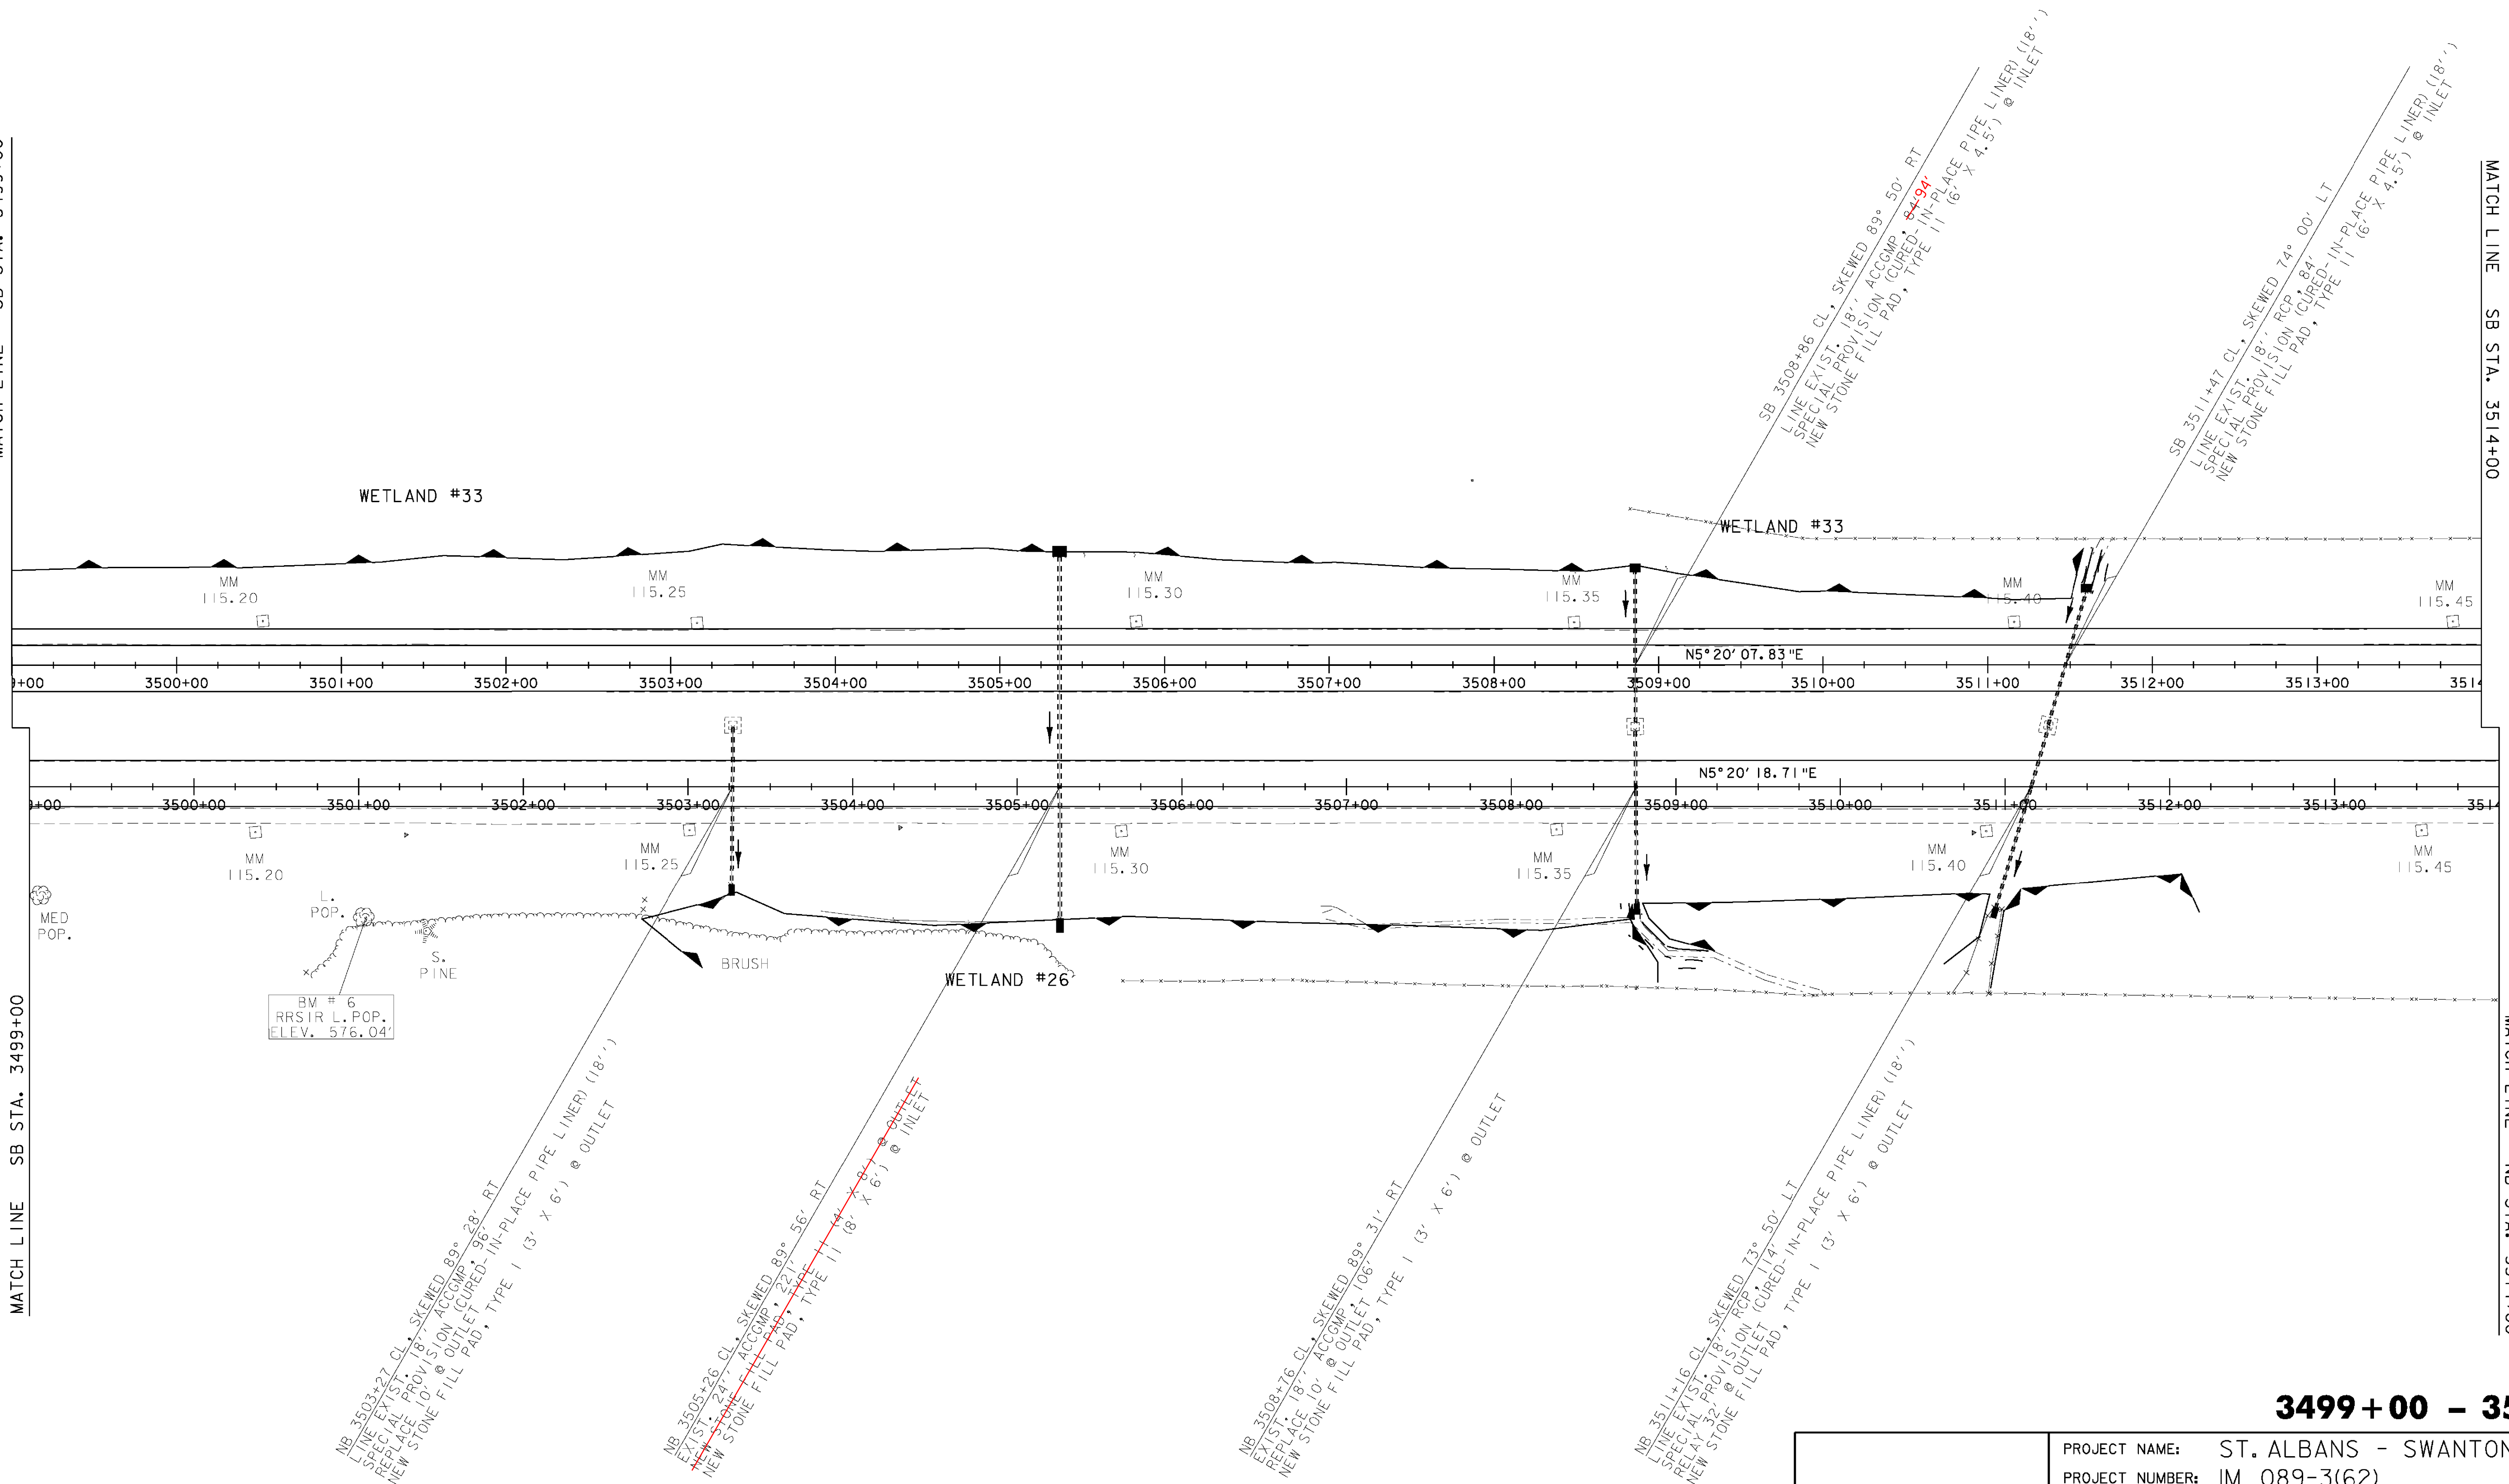

BM # 6
 RRSIR L. POP.
 ELEV. 576.04'

3499+00 - 3514+00

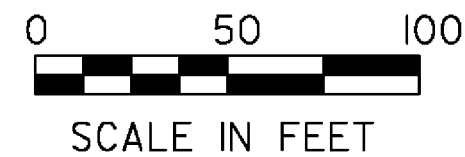

LAYOUT SHEET #6

PROJECT NAME:	ST. ALBANS - SWANTON	
PROJECT NUMBER:	IM 089-3(62)	
FILE NAME:	D96A058BDR.DGN	PLOT DATE: 26-AUG-2009
PROJECT LEADER:	K. ROBBIE	DRAWN BY: P. BEYOR
DESIGNED BY:	P. BEYOR	CHECKED BY: A. BOMBARDIER
D96A058L05.I		SHEET 27 OF 117