

REMOVAL OF EXISTING FENCE
 NB 3495+11 ~ NB 3546+82 RT
 SB 3492+51 ~ SB 3546+22 LT


WOVEN WIRE FENCE, W/STEEL POSTS
 SB 3514+00 ~ SB 3540+38 LT 29+00
 NB 3508+27 ~ NB 3546+82 RT
 14+00 29+00

MATCH LINE SB STA. 3514+00

MATCH LINE NB STA. 3514+00

MATCH LINE SB STA. 3529+00

MATCH LINE NB STA. 3529+00

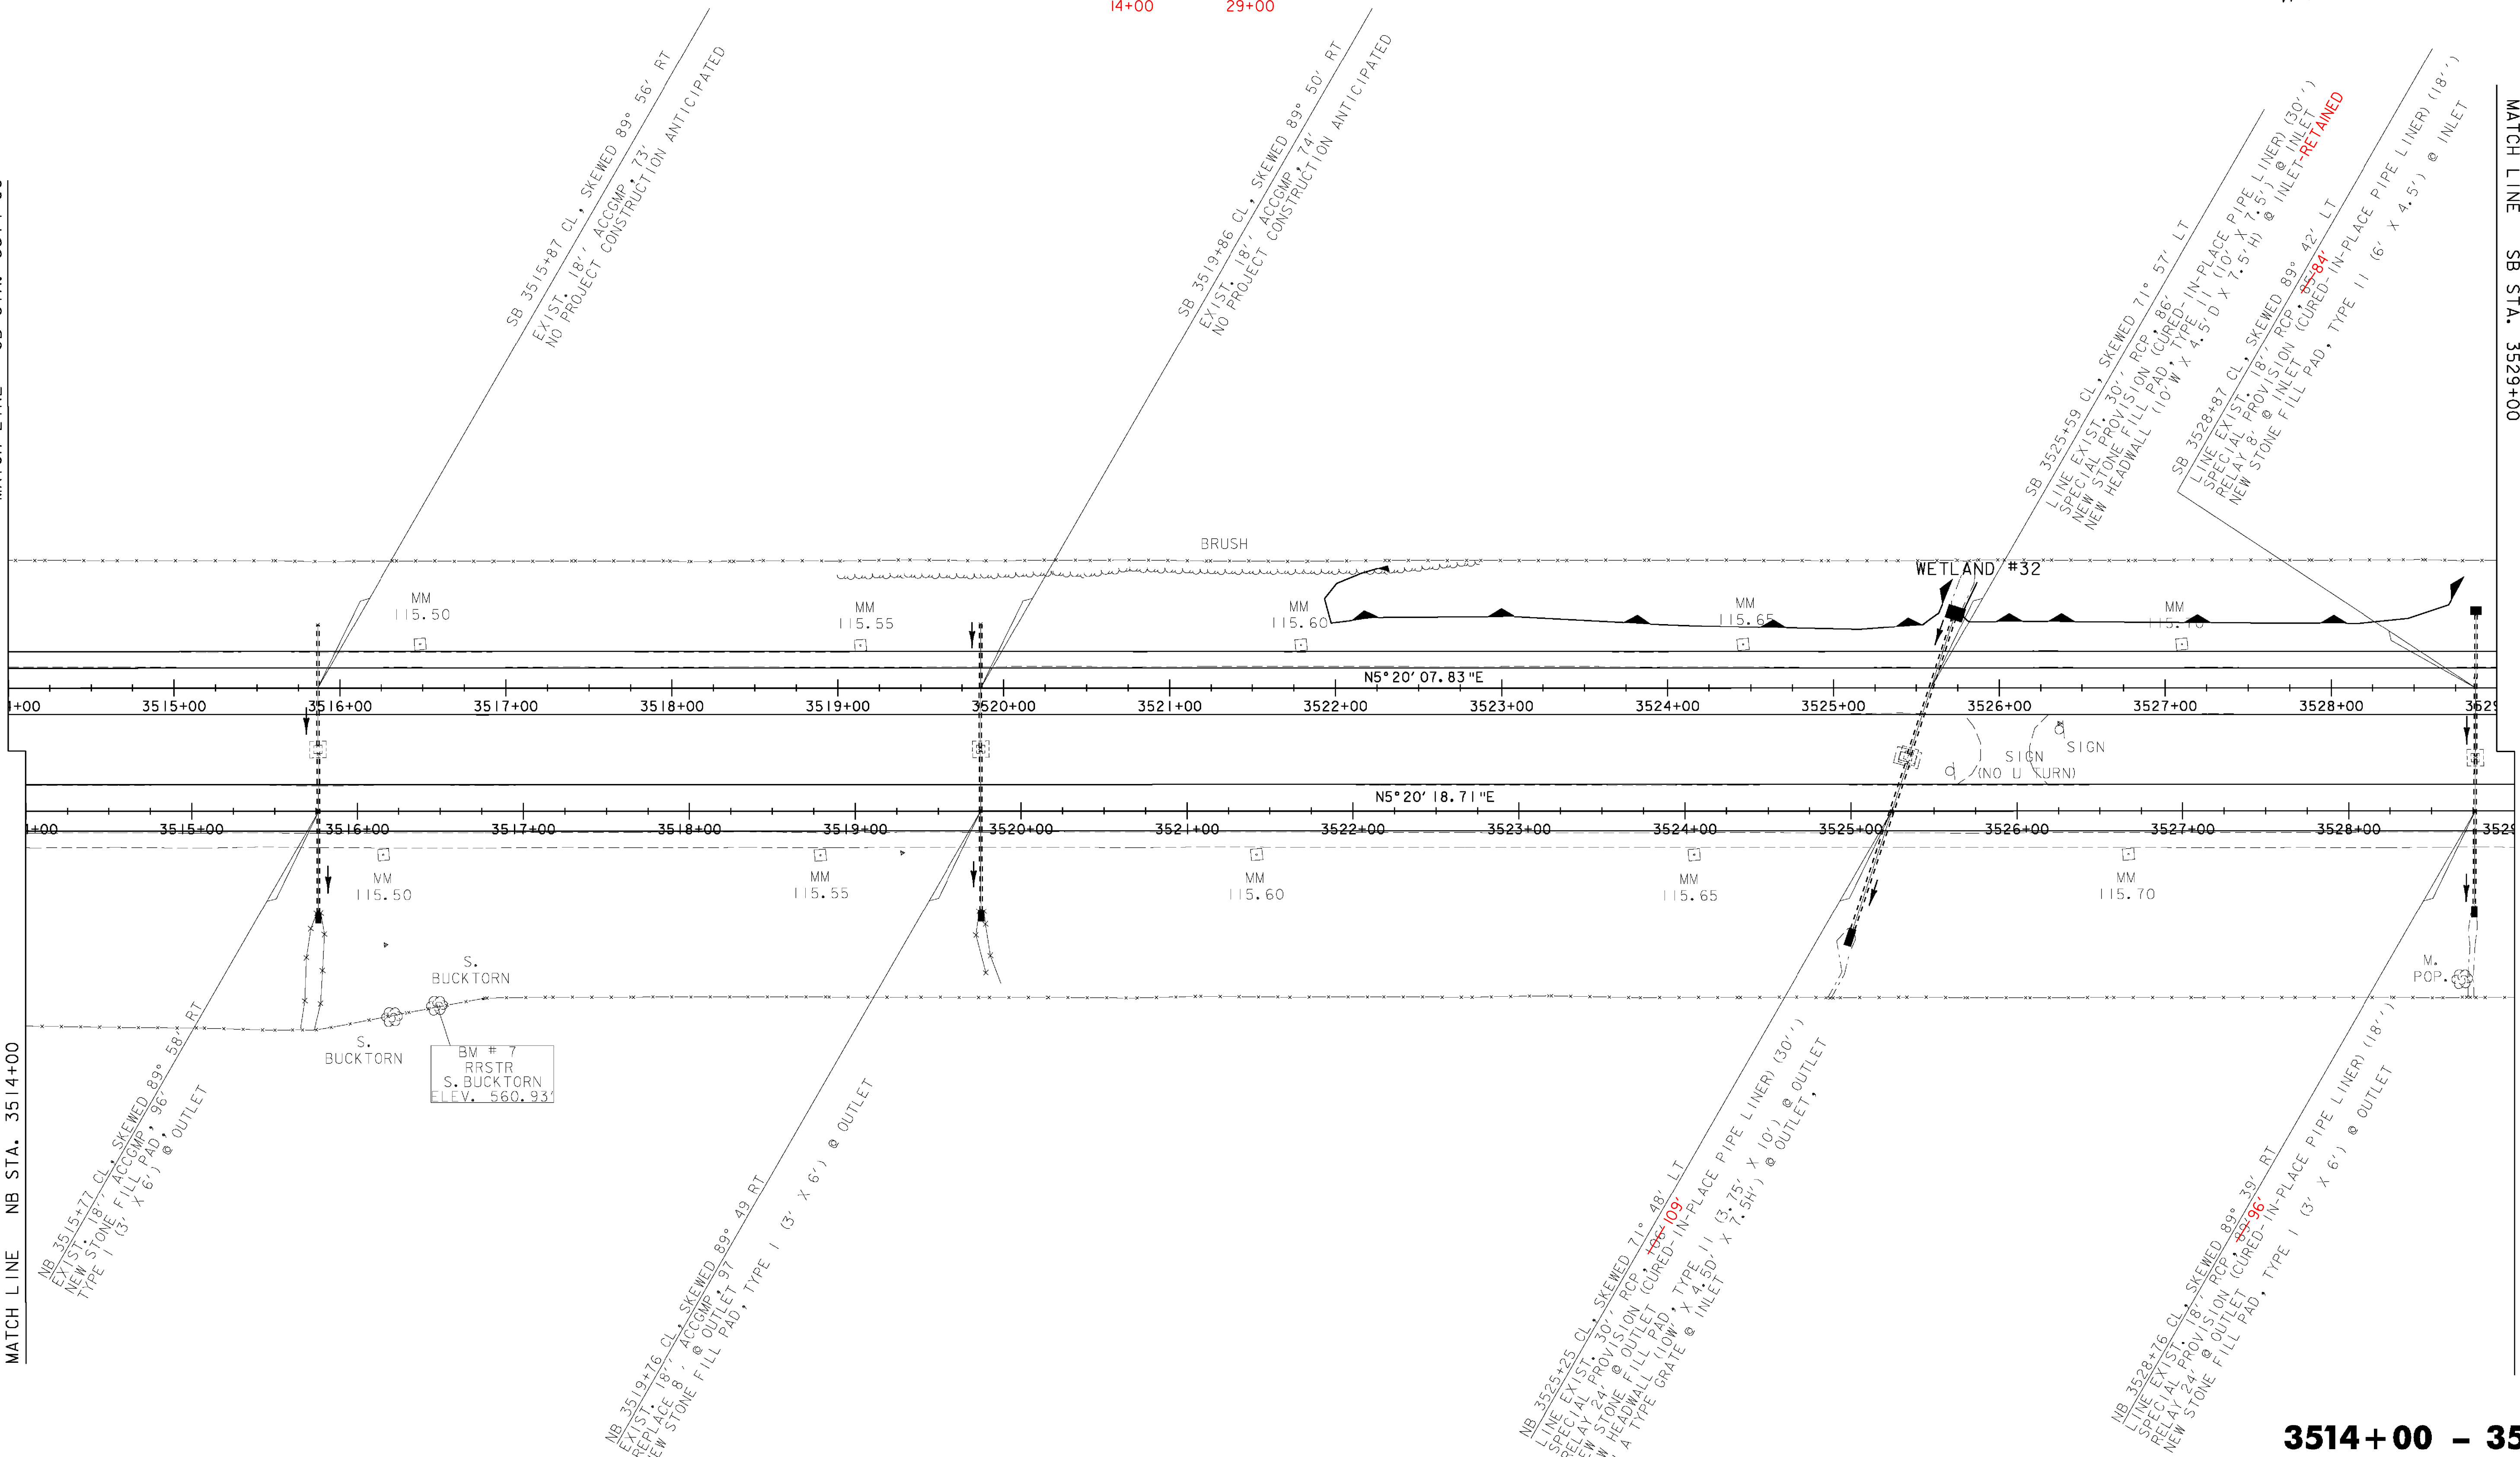


S. BUCKTORN
 S. BUCKTORN
 BM # 7
 RRSTR
 S. BUCKTORN
 ELEV. 560.93

SIGN
 SIGN
 (NO U TURN)

WETLAND #32

BRUSH

3514+00 - 3529+00

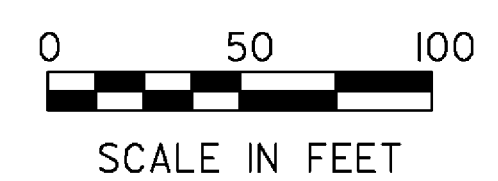

LAYOUT SHEET #7

PROJECT NAME:	ST. ALBANS - SWANTON	
PROJECT NUMBER:	IM 089-3(62)	
FILE NAME:	D96A058BDR.DGN	PLOT DATE: 26-AUG-2009
PROJECT LEADER:	K. ROBBIE	DRAWN BY: P. BEYOR
DESIGNED BY:	P. BEYOR	CHECKED BY: A. BOMBARDIER
D96A058L06.J		SHEET 28 OF 117