

REMOVAL OF EXISTING FENCE
 NB 3547+20 ~ NB 3583+18 RT
 SB 3546+61 ~ SB 3582+77 LT



STEEL BEAM GUARDRAIL, GALVANIZED W/8' POSTS
 NB 3562+10 ~ NB 3582+92 RT
 NB 3561+92 ~ NB 3573+00 RT

CHAIN-LINK FENCE, 6 FEET
 SB 3546+61 ~ SB 3582+77 LT
 3559+00 3573+00

MANUFACTURED TERMINAL SECTION, FLARED
 NB 3561+72.5 ~ NB 3562+10 RT
 NB 3561+54.5 ~ NB 3561+92 RT

WOVEN WIRE FENCE, W/STEEL POSTS
 NB 3555+80 ~ NB 3579+56 RT
 3559+00 3573+00

REMOVAL AND DISPOSAL OF GUARDRAIL
 NB 3561+71 ~ NB 3582+92 RT
 NB 3561+92 ~ NB 3573+00 RT

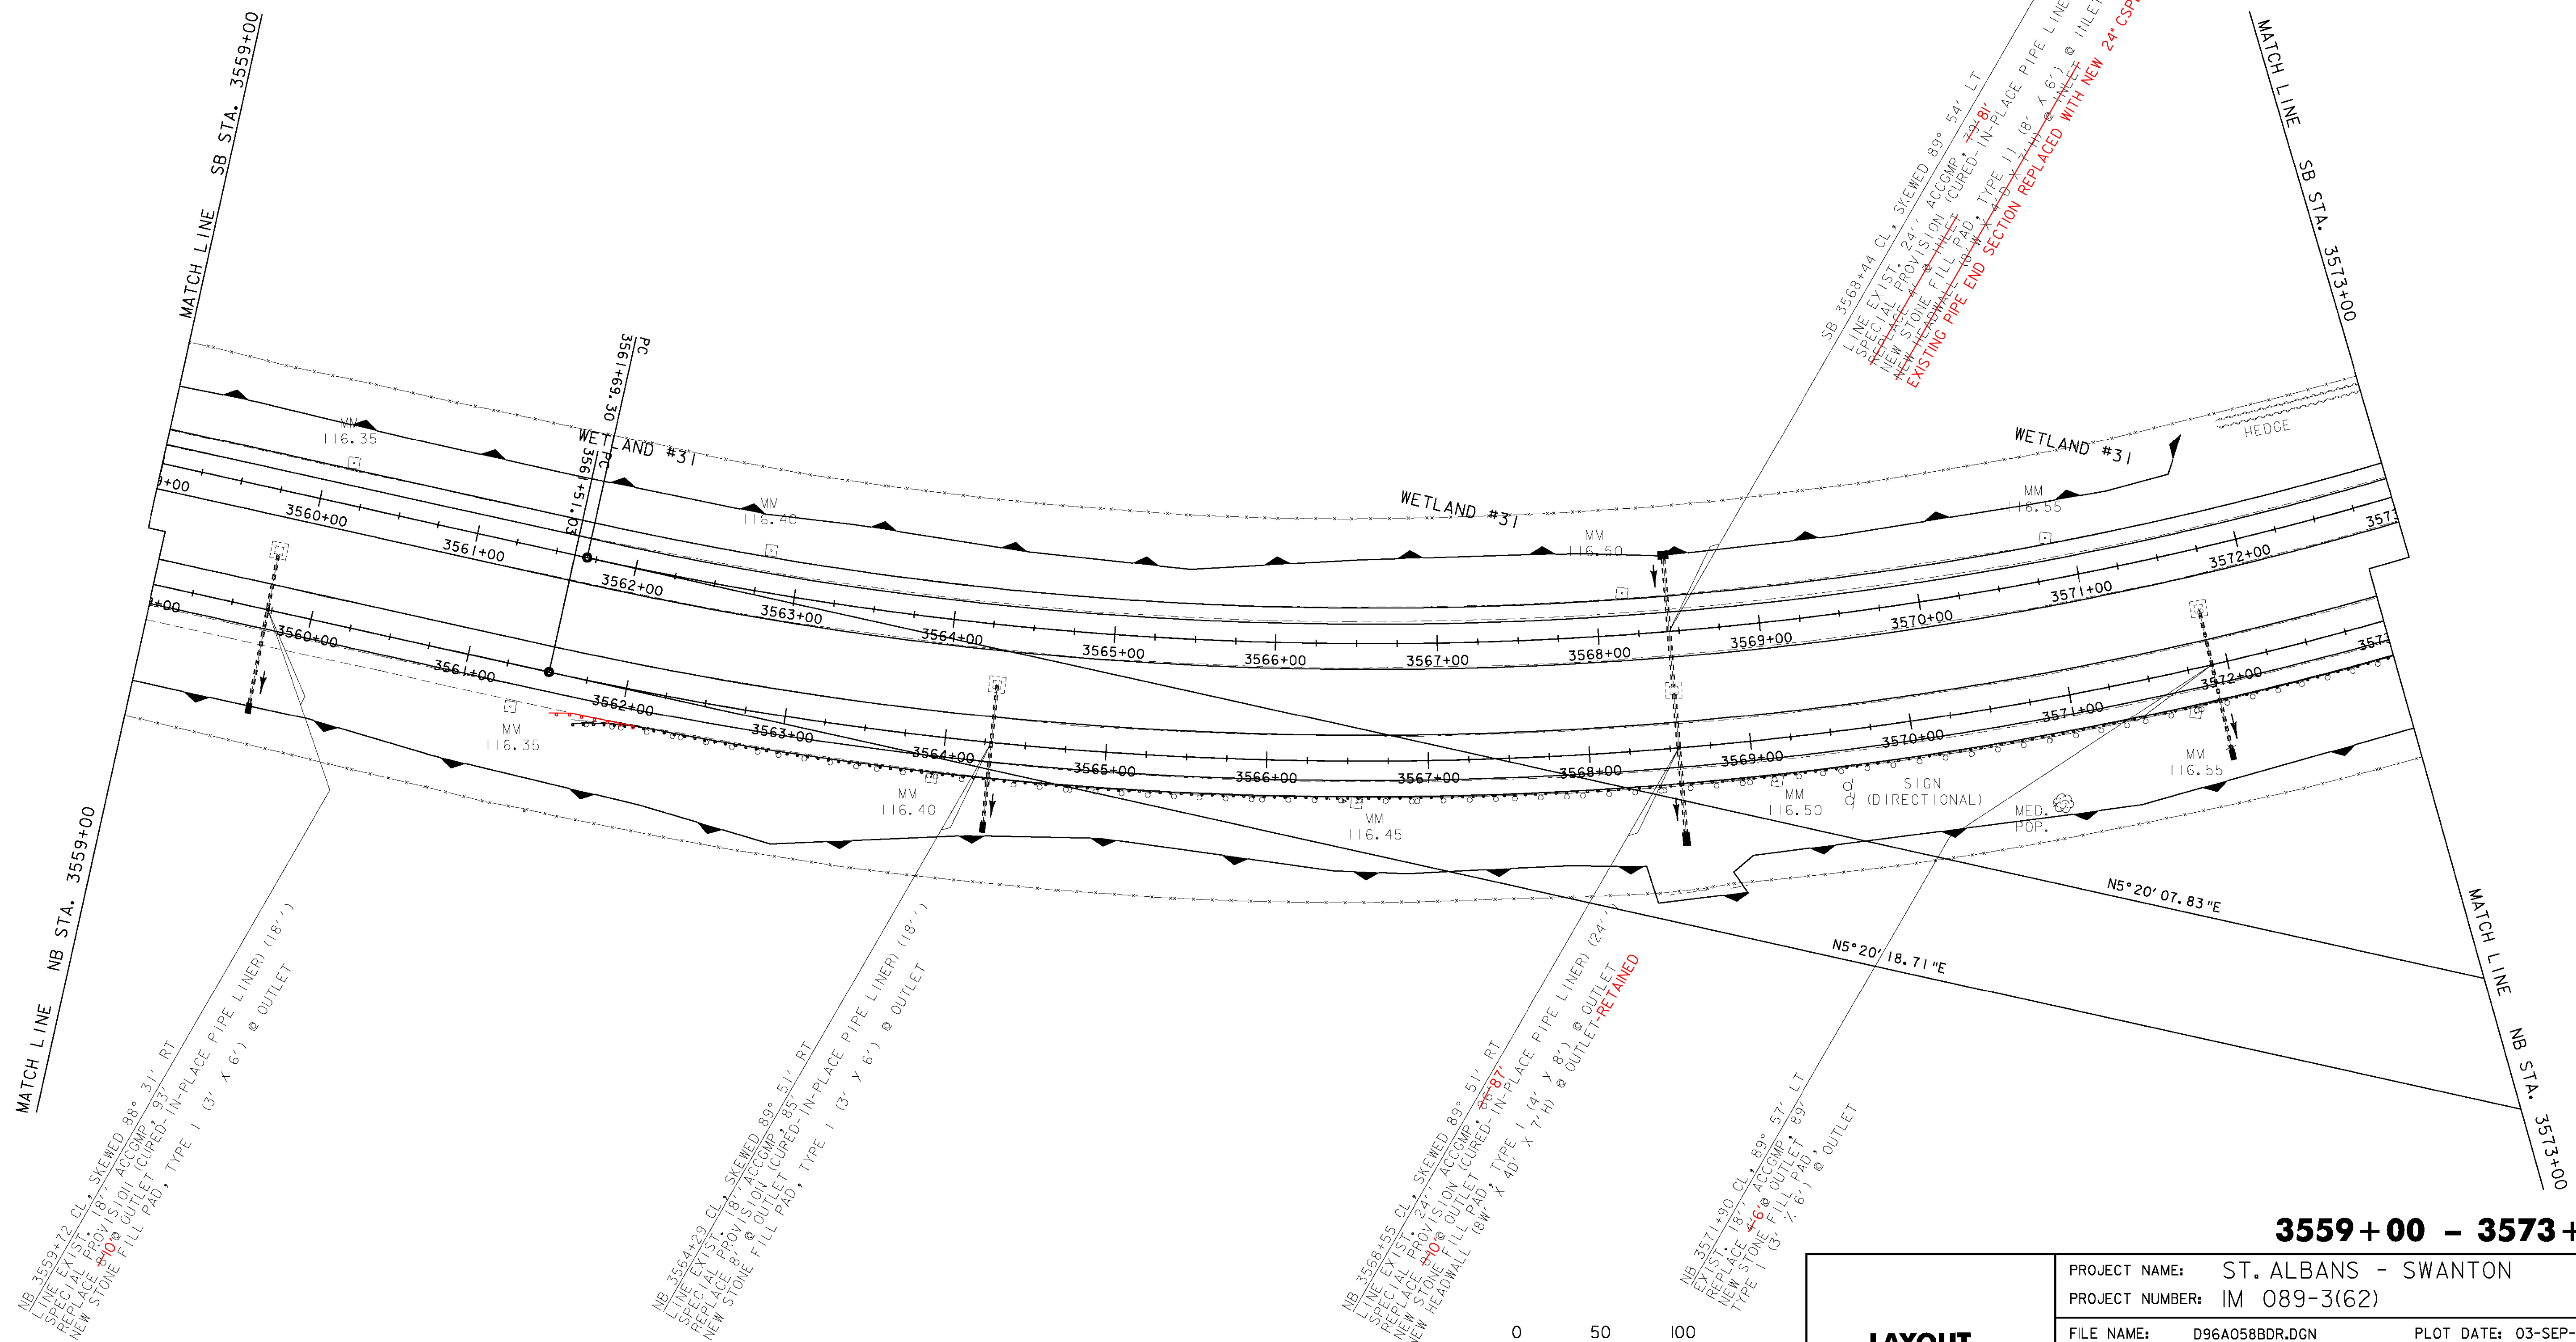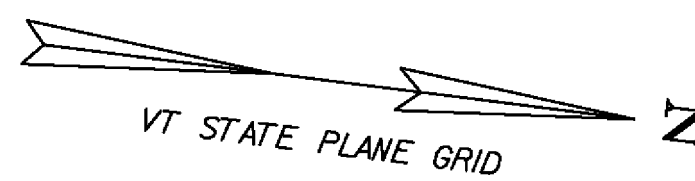


MATCH LINE NB STA. 3559+00
 NB 3559+72 CL, SKEWED 88° 31' RT
 SPECIAL PROVISION ACCOMP. 93'
 REPLACE 18" @ OUTLET CURED- 18"
 NEW STONE FILL PAD, TYPE I (3' X 6') @ OUTLET

NB 3564+29 CL, SKEWED 89° 51' RT
 SPECIAL PROVISION ACCOMP. 85'
 REPLACE 18" @ OUTLET CURED- 18"
 NEW STONE FILL PAD, TYPE I (3' X 6') @ OUTLET

NB 3568+55 CL, SKEWED 89° 51' RT
 SPECIAL PROVISION ACCOMP. 87'
 REPLACE 18" @ OUTLET CURED- 18"
 NEW STONE FILL PAD, TYPE I (3' X 6') @ OUTLET

NB 3571+80 CL, SKEWED 89° 57' LT
 SPECIAL PROVISION ACCOMP. 89'
 REPLACE 18" @ OUTLET CURED- 18"
 NEW STONE FILL PAD, TYPE I (3' X 6') @ OUTLET

SB 3568+44 CL, SKEWED 89° 54' LT
 SPECIAL PROVISION ACCOMP. 88'
 REPLACE 18" @ OUTLET CURED- 18"
 NEW STONE FILL PAD, TYPE I (3' X 6') @ INLET
 EXISTING PIPE END SECTION REPLACED WITH NEW 24" CSPES

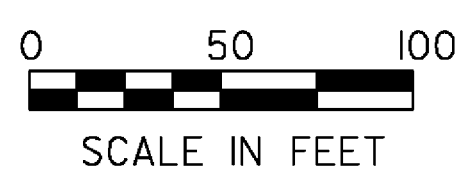

3559+00 - 3573+00

LAYOUT SHEET #10	PROJECT NAME: ST. ALBANS - SWANTON	PLOT DATE: 03-SEP-2009
	PROJECT NUMBER: IM 089-3(62)	DRAWN BY: P. BEYOR
	DESIGNED BY: P. BEYOR	CHECKED BY: A. BOMBARDIER
	D96A058L09.J	SHEET 31 OF 117