

REMOVAL OF EXISTING FENCE
 NB 3584+10 ~ NB 3620+51 RT
 SB 3583+78 ~ SB 3620+92 LT

REMOVAL AND DISPOSAL OF GUARDRAIL
 NB 3586+00 ~ NB 3584+62 ~ NB 3604+81 RT ~ NB 3601+00 RT
 SB 3586+00 ~ SB 3584+06 ~ SB 3604+35 LT ~ SB 3601+00 LT
 SB 3586+00 ~ SB 3584+07 ~ SB 3586+16 RT ~ SB 3586+66 RT



CHAIN-LINK FENCE, 6 FEET
 3586+00 SB 3583+77 ~ SB 3586+95 LT
 3586+00 NB 3584+10 ~ NB 3587+38 RT

STEEL BEAM GUARDRAIL, GALVANIZED W/8' POSTS
 NB 3586+00 ~ NB 3584+62 ~ NB 3604+74.5 RT ~ NB 3601+00 RT
 SB 3586+00 ~ SB 3584+06 ~ SB 3603+93.5 LT ~ SB 3601+00 LT
 SB 3584+07 ~ SB 3586+32 RT

WOVEN WIRE FENCE, W/STATE
 SB 3586+95 ~ SB 3620+92 LT 3601+00
 NB 3587+38 ~ NB 3608+79 RT 3601+00

MANUFACTURED TERMINAL SECTION, FLARED
 SB 3586+32 ~ SB 3586+69.5 RT

STEEL BEAM GUARDRAIL, GALVANIZED
 SB 3586+00 ~ SB 3586+32 RT

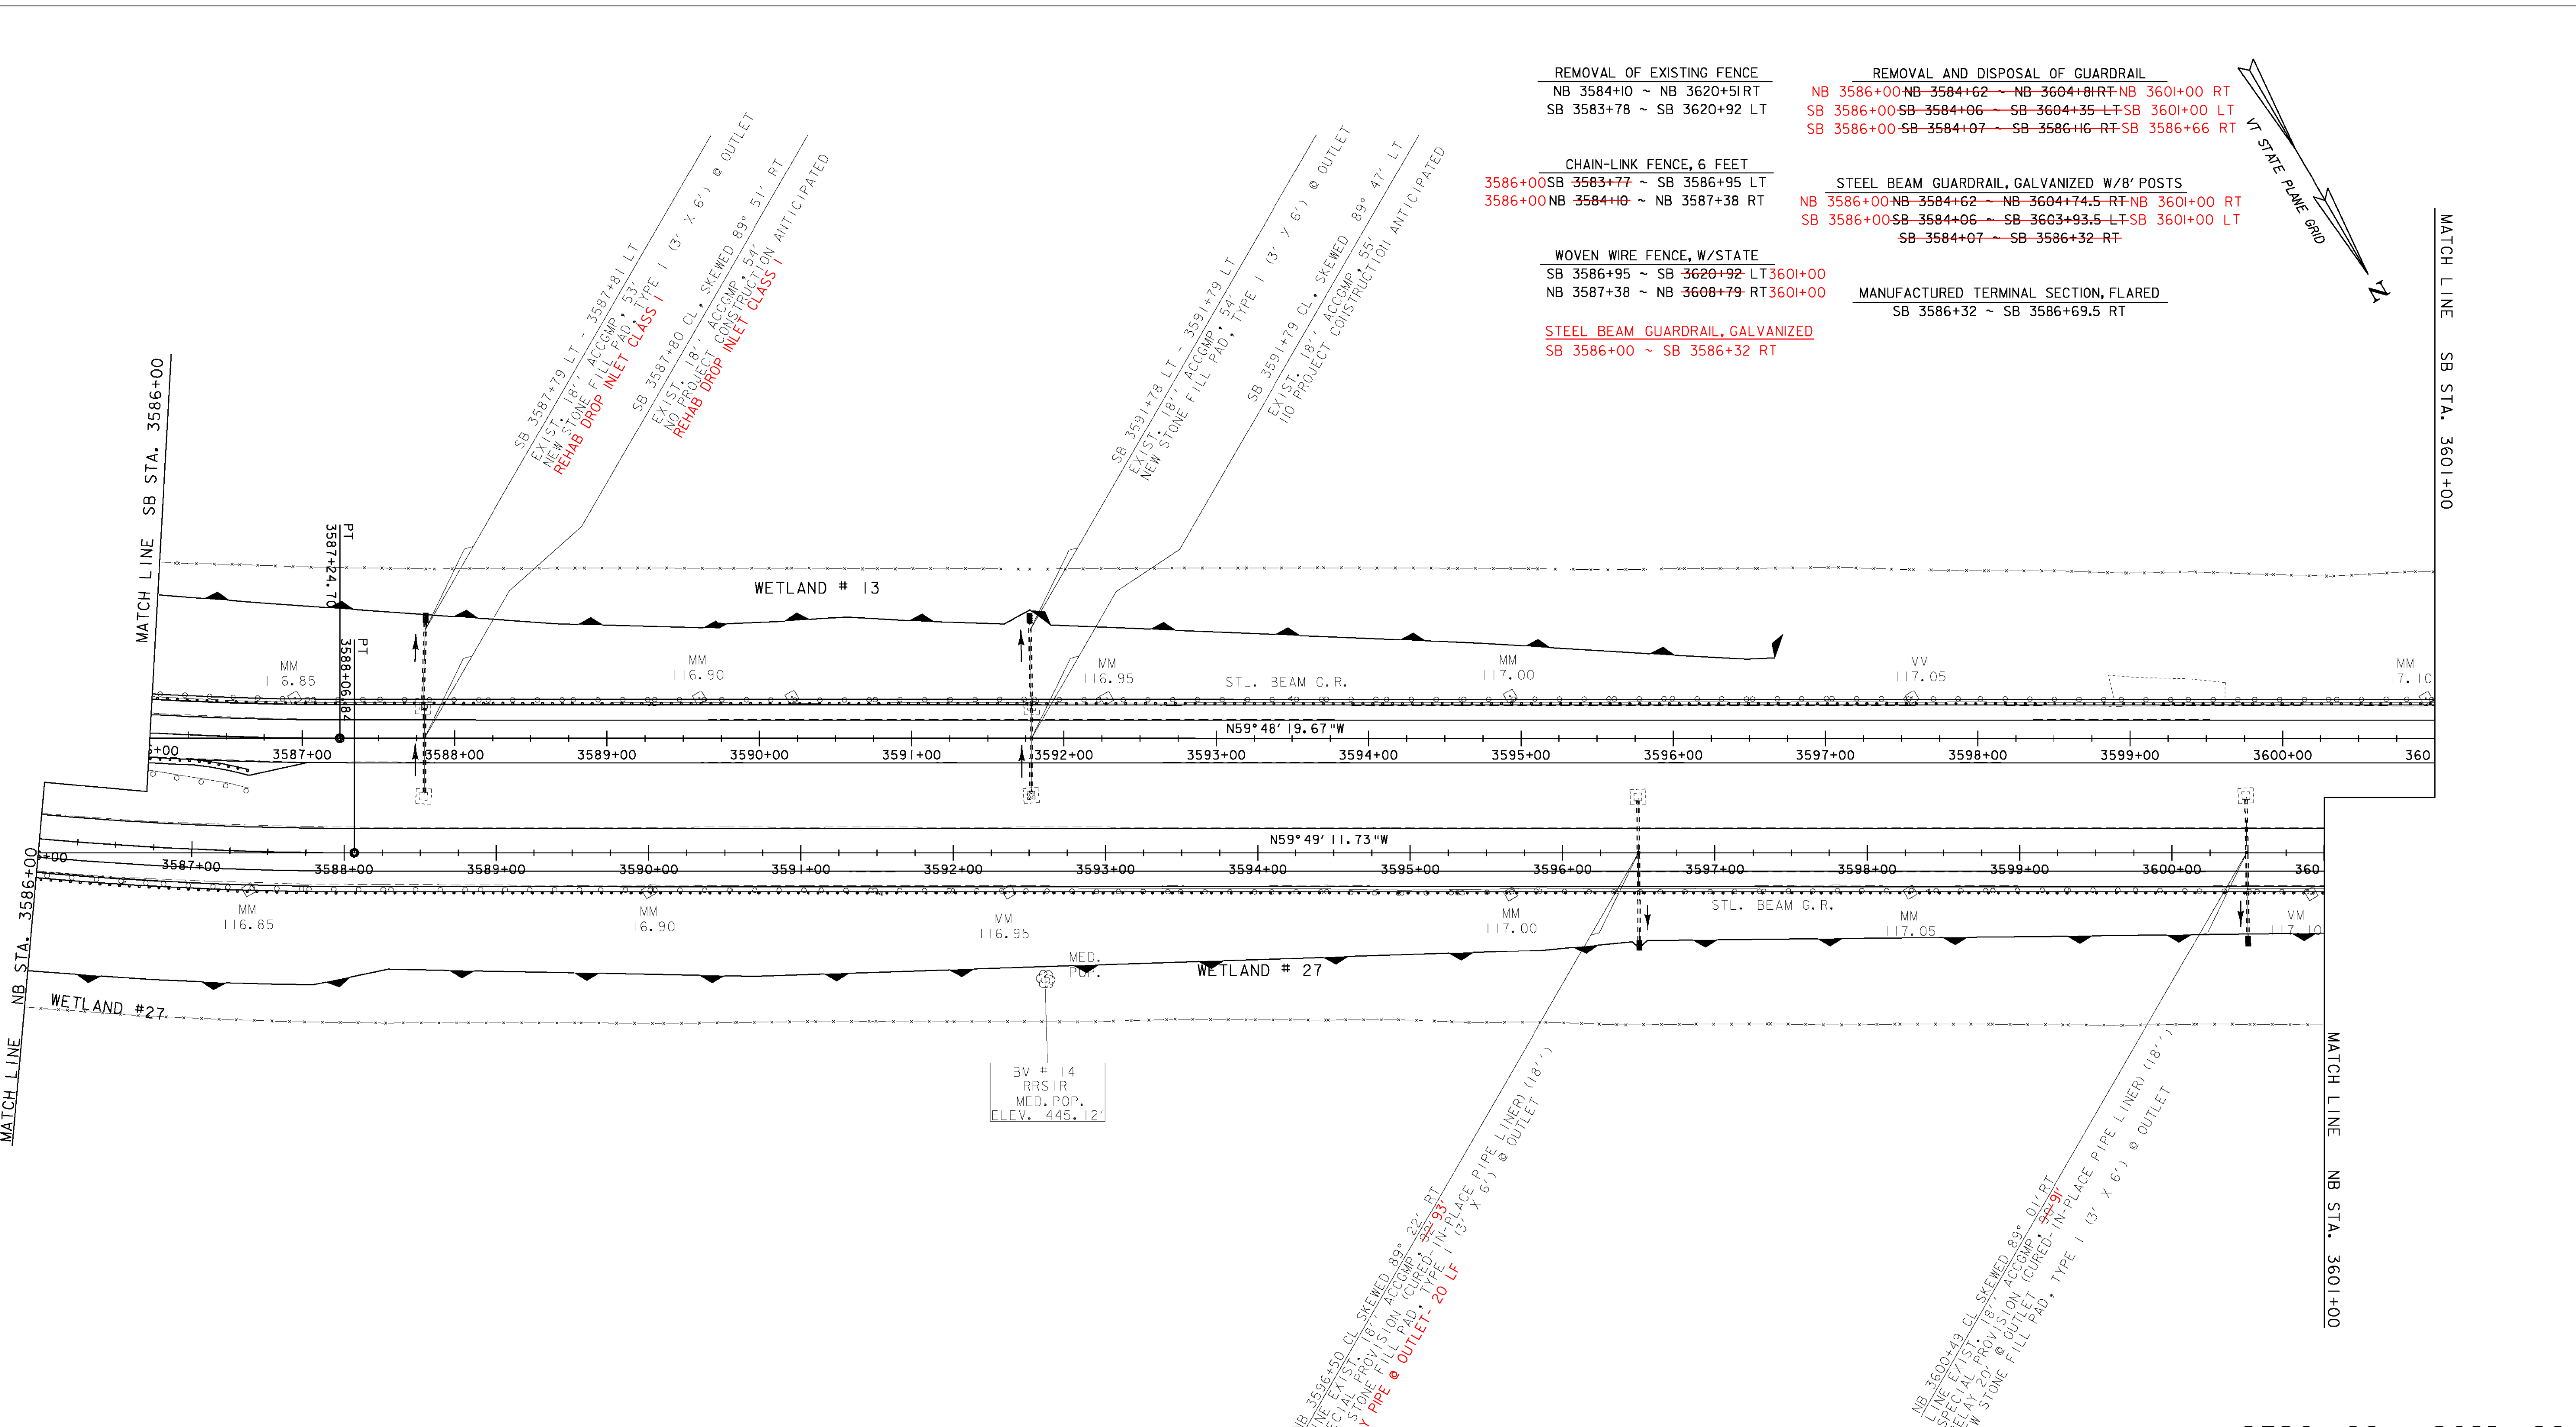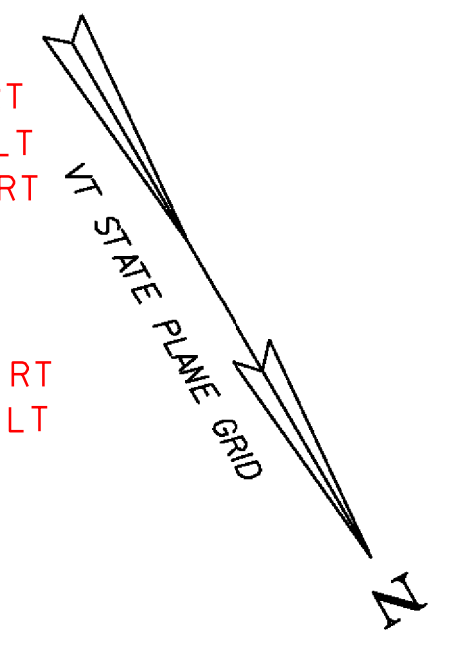


BM # 14
 RRSIR
 MED. POP.
 ELEV. 445.12'

NB 3596+40 CL SKEWED 89° 22' RT
 SPEC. EX. 151' 187' ACCUM. 22' RT
 NEW STONE FILL PAD, CURED, 3' X 6'
 RELAY PIPE @ OUTLET - 20 LF
 TYPE I (3' X 6') @ OUTLET (18')

NB 3600+49 CL SKEWED 89° 01' RT
 SPEC. EX. 151' 187' ACCUM. 22' RT
 NEW STONE FILL PAD, CURED, 3' X 6'
 RELAY PIPE @ OUTLET - 20 LF
 TYPE I (3' X 6') @ OUTLET (18')

3586+00 - 3601+00

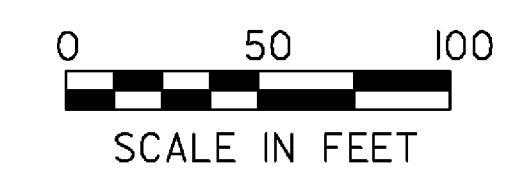

LAYOUT SHEET #12	PROJECT NAME: ST. ALBANS - SWANTON	PLOT DATE: 03-SEP-2009
	PROJECT NUMBER: IM 089-3(62)	DRAWN BY: P. BEYOR
	DESIGNED BY: P. BEYOR	CHECKED BY: A. BOMBARDIER
	D96A05LIIJ	SHEET 33 OF 117