


# GUARDRAIL LOCATIONS


LOCATION:  
 VT 36 OVER INTERSTATE 89  
 NB MM 114.39  
 SB MM 114.40

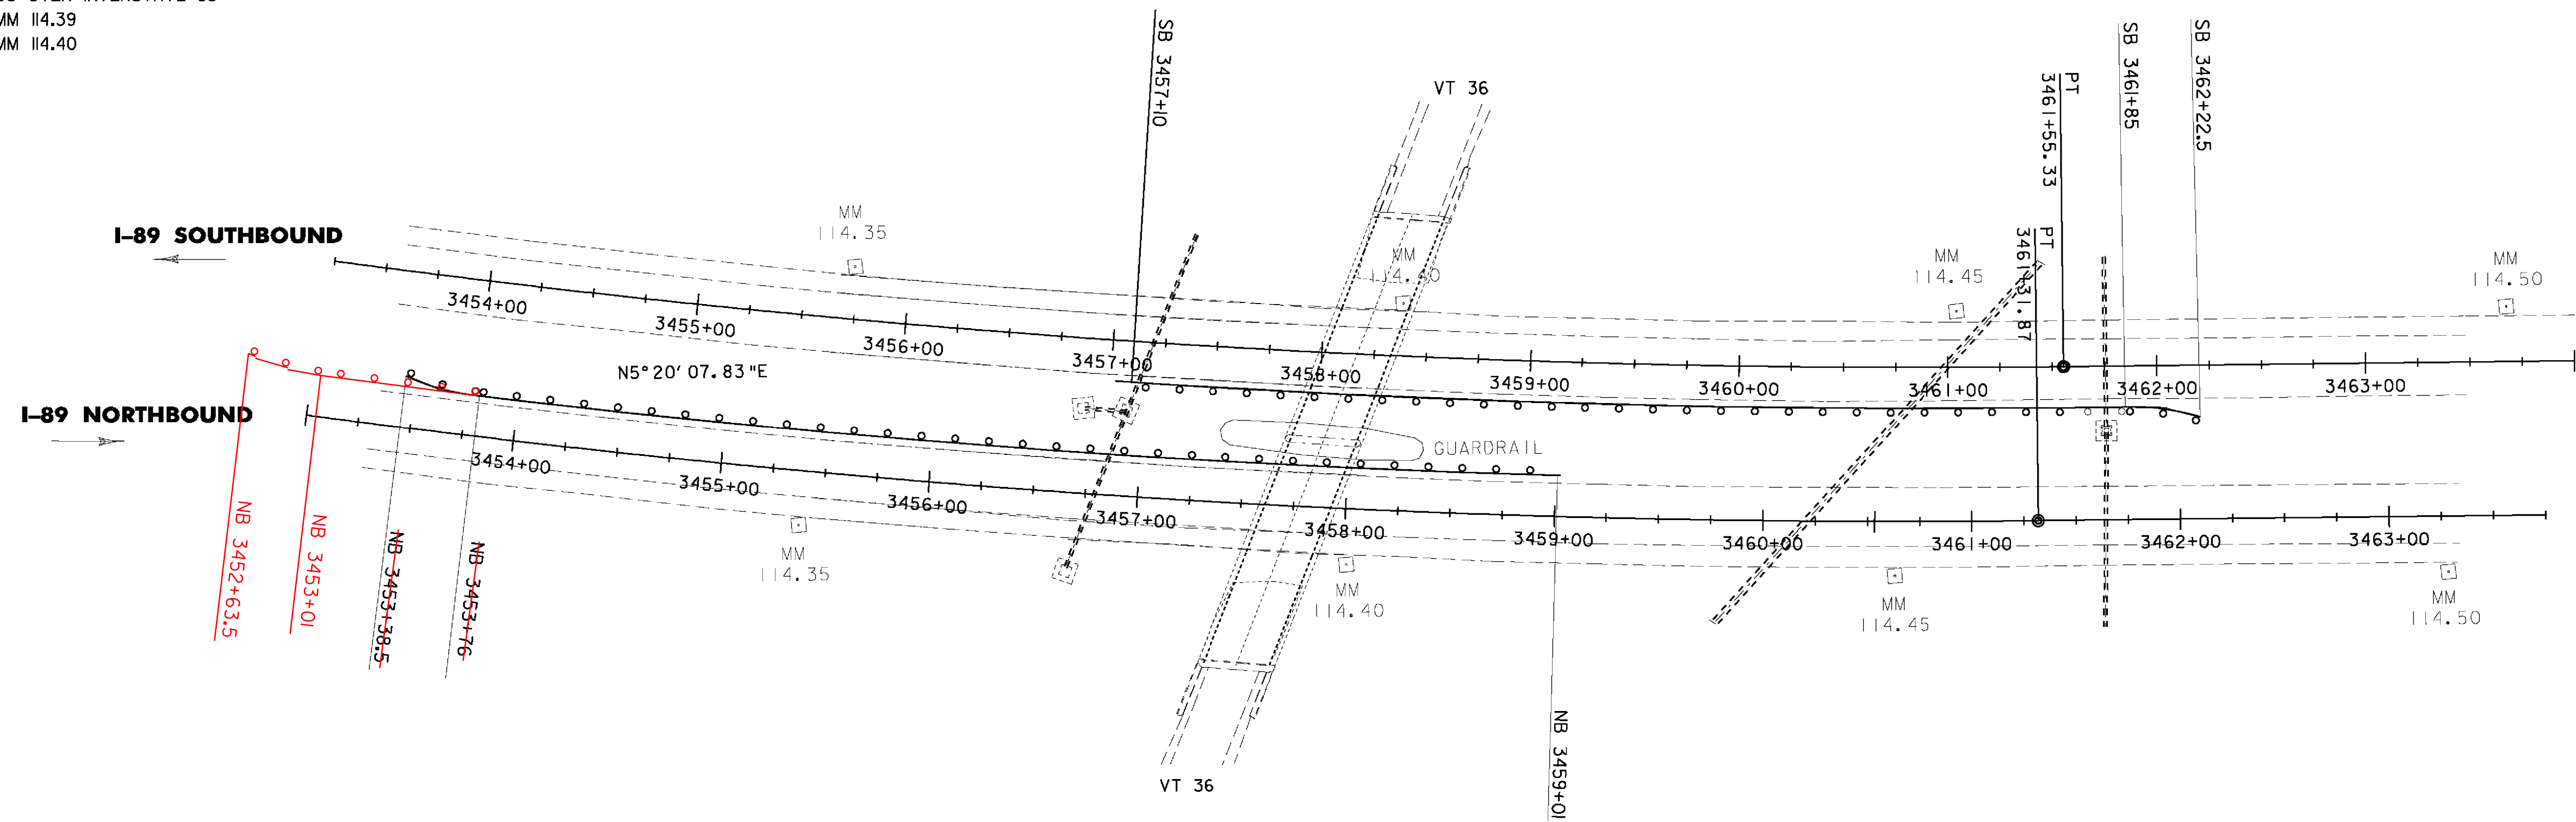

- 62I.20 STEEL BEAM GUARDRAIL, GALVANIZED
- 3453+0I NB 3453+76 LT ~ NB 3459+0I LT
- SB 3457+0I RT ~ SB 3461+85 RT
- 62I.50 MANUFACTURED TERMINAL SECTION, FLARED
- NB 3453+38.5 LT ~ NB 3453+76 LT
- SB 3461+85 RT ~ SB 3462+22.5 RT
- NB 3452+63.5 LT ~ NB 3453+0I LT
- 62I.60 ANCHOR FOR STEEL BEAM RAIL
- NB 3459+0I LT
- SB 3457+0I RT
- 62I.80 REMOVAL AND DISPOSAL OF GUARDRAIL
- NB 3457+38 LT ~ 3458+36 LT
- SB 3457+54 RT ~ 3458+5I RT

# GUARDRAIL LOCATIONS

LOCATION:  
 VT 104 OVER INTERSTATE 89  
 NB MM 115.09  
 SB MM 115.06

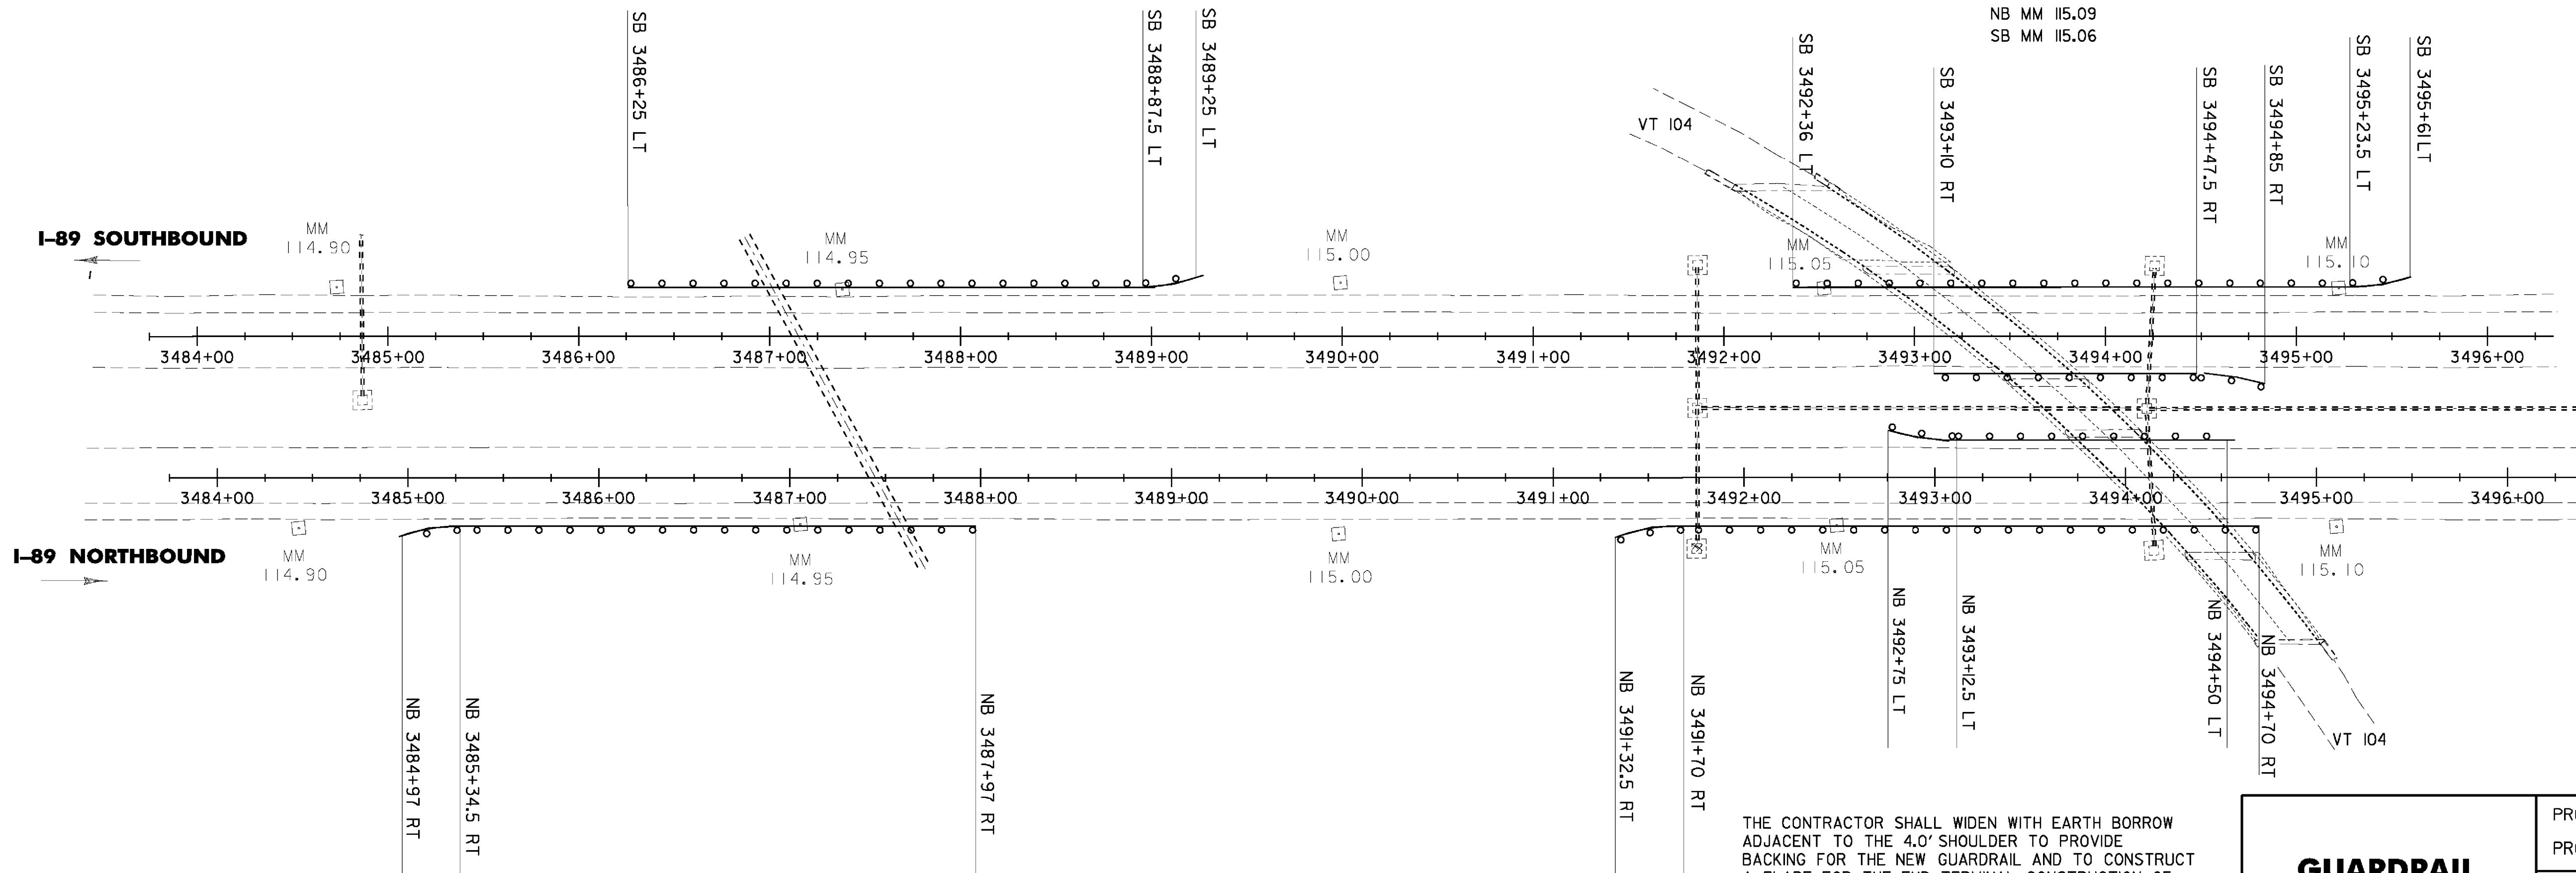

- 62I.20 STEEL BEAM GUARDRAIL, GALVANIZED
- NB 3485+34.5 RT ~ NB 3487+97 RT
- NB 3491+70 RT ~ NB 3494+70 RT
- NB 3493+12.5 LT ~ NB 3494+50 LT
- SB 3486+25 LT ~ SB 3488+87.5 LT
- SB 3492+36 LT ~ SB 3495+23.5 LT
- SB 3493+0I RT ~ SB 3494+47.5 RT
- 62I.50 MANUFACTURED TERMINAL SECTION, FLARED
- NB 3484+97 RT ~ NB 3485+34.5 RT
- NB 3491+32.5 RT ~ NB 3491+70 RT
- NB 3492+75 LT ~ NB 3493+12.5 LT
- SB 3488+87.5 LT ~ SB 3489+25 LT
- SB 3495+23.5 LT ~ SB 3495+6I LT
- SB 3494+47.5 RT ~ SB 3494+85 RT
- 62I.60 ANCHOR FOR STEEL BEAM RAIL
- NB 3487+97 RT
- NB 3494+70 RT
- NB 3494+50 LT
- SB 3486+25 LT
- SB 3492+36 LT
- SB 3493+0I RT
- 62I.80 REMOVAL AND DISPOSAL OF GUARDRAIL
- 3484+97 NB 3484+94 RT ~ NB 3487+97 RT
- 3491+32.5 NB 3491+3I RT ~ NB 3494+70 RT
- 3492+75 NB 3492+74 LT ~ NB 3494+53 LT 3494+50
- 3486+25 SB 3486+26 LT ~ SB 3489+25 LT
- 3492+36 SB 3492+37 LT ~ SB 3495+6I LT
- SB 3493+0I RT ~ SB 3494+85 RT

THE CONTRACTOR SHALL WIDEN WITH EARTH BORROW ADJACENT TO THE 4.0' SHOULDER TO PROVIDE BACKING FOR THE NEW GUARDRAIL AND TO CONSTRUCT A FLARE FOR THE END TERMINAL. CONSTRUCTION OF THE WIDENING AND TERMINAL FLARE SHALL BE COMPLETED IN ACCORDANCE WITH STANDARD G-19.

**DETAILS ARE NOT TO SCALE**

## GUARDRAIL TREATMENT DETAIL SHEET 1

PROJECT NAME: ST. ALBANS - SWANTON  
 PROJECT NUMBER: IM 089-3(62)

FILE NAME: D96A058FRM.DGN PLOT DATE: 26-AUG-2009  
 PROJECT LEADER: K. ROBBIE DRAWN BY: P. BEYOR  
 DESIGNED BY: P. BEYOR CHECKED BY: S. MENARD  
 PLOT FILE: D96A058GRTI.I SHEET 38 OF 117