


GUARDRAIL LOCATIONS

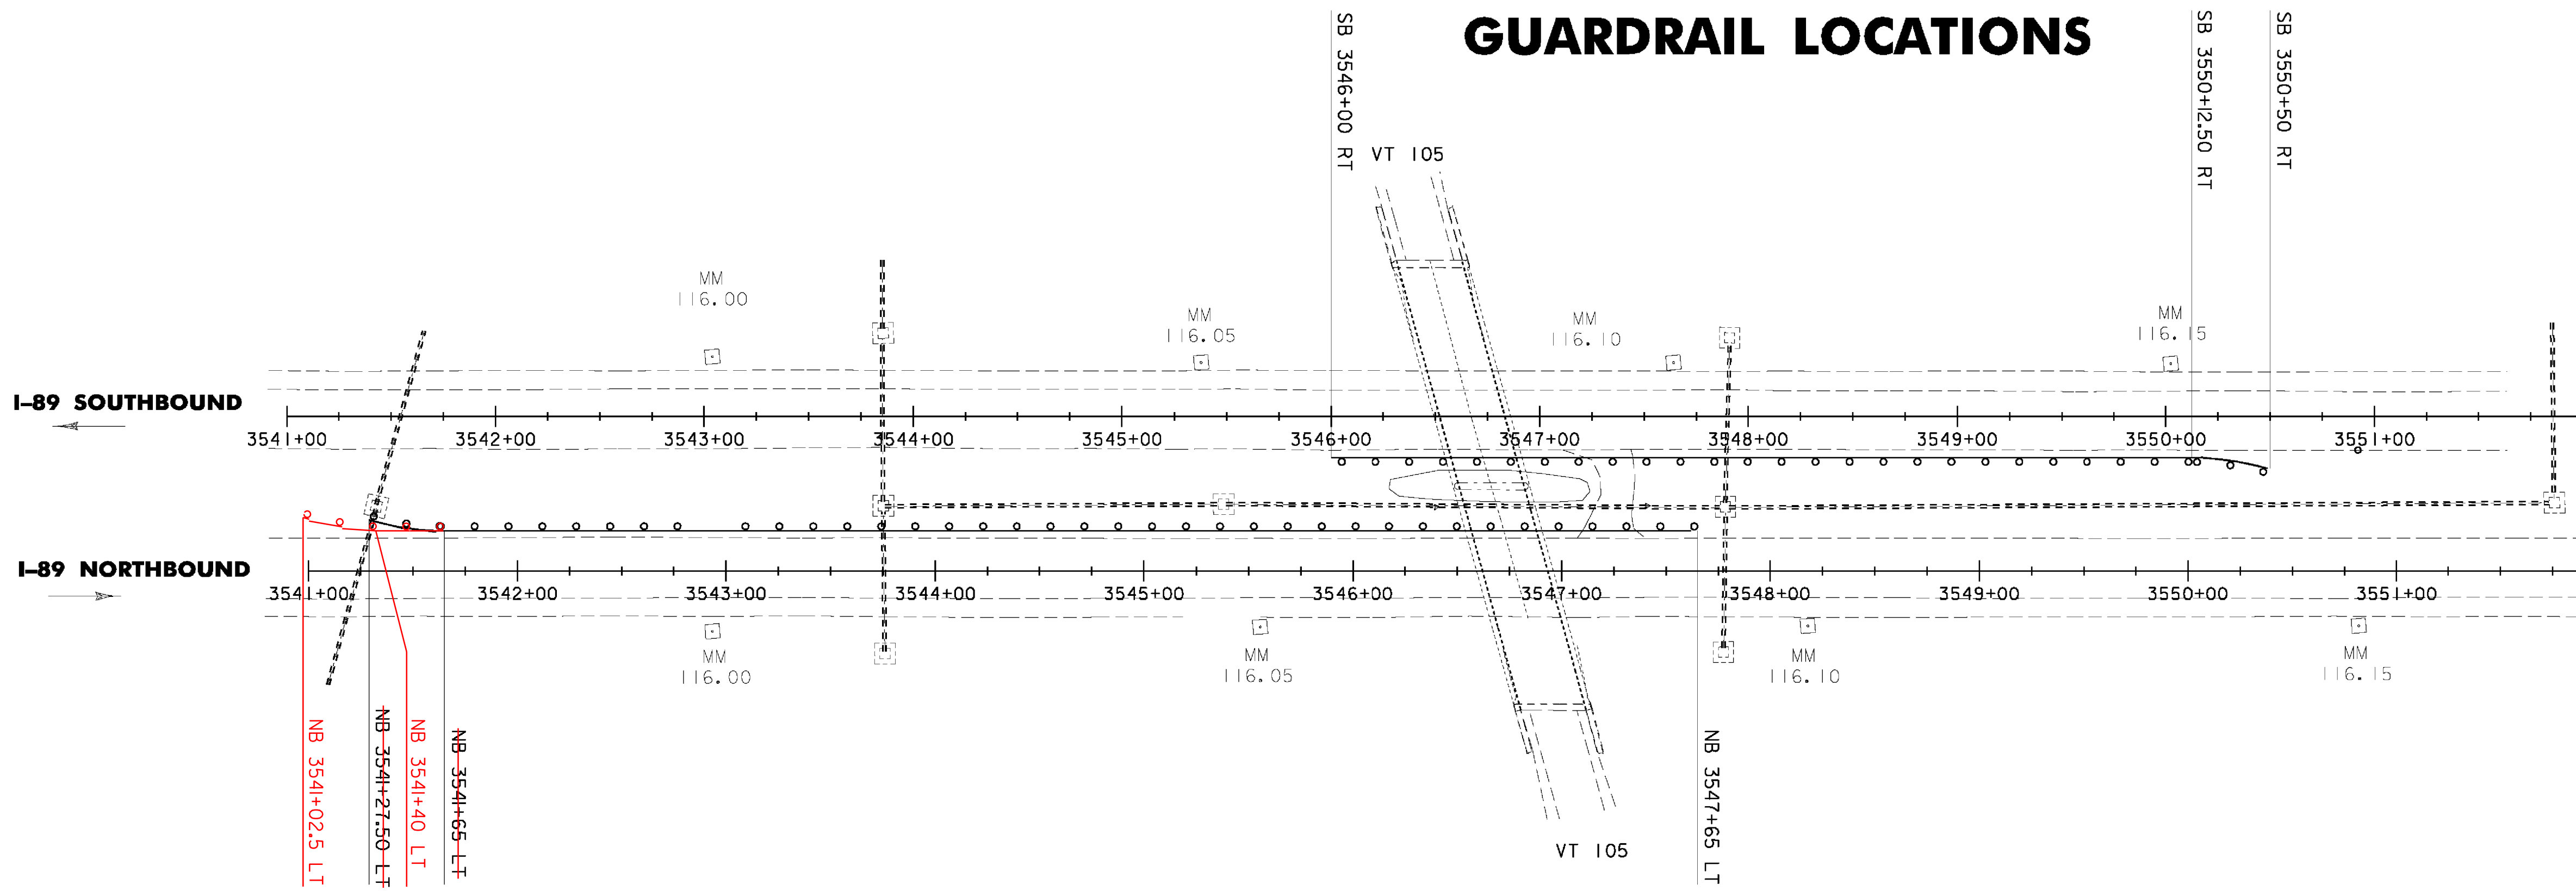


- 621.20 STEEL BEAM GUARDRAIL, GALVANIZED
- 3541+40 NB 3541+65 LT ~ NB 3547+65 LT
- SB 3546+00 RT ~ SB 3550+12.50 RT

- 621.50 MANUFACTURED TERMINAL SECTION, FLARED
- NB 3541+27.50 LT ~ NB 3541+65 LT
- SB 3550+12.50 RT ~ SB 3550+50 RT
- NB 3541+02.5 LT ~ NB 3541+40 LT

- 621.60 ANCHOR FOR STEEL BEAM RAIL
- NB 3547+65 LT
- SB 3546+00 RT

- 621.80 REMOVAL AND DISPOSAL OF GUARDRAIL
- NB 3546+17 LT ~ NB 3547+14 LT 3547+24
- SB 3546+28 RT ~ SB 3547+24 RT
- 3546+17

GUARDRAIL LOCATIONS

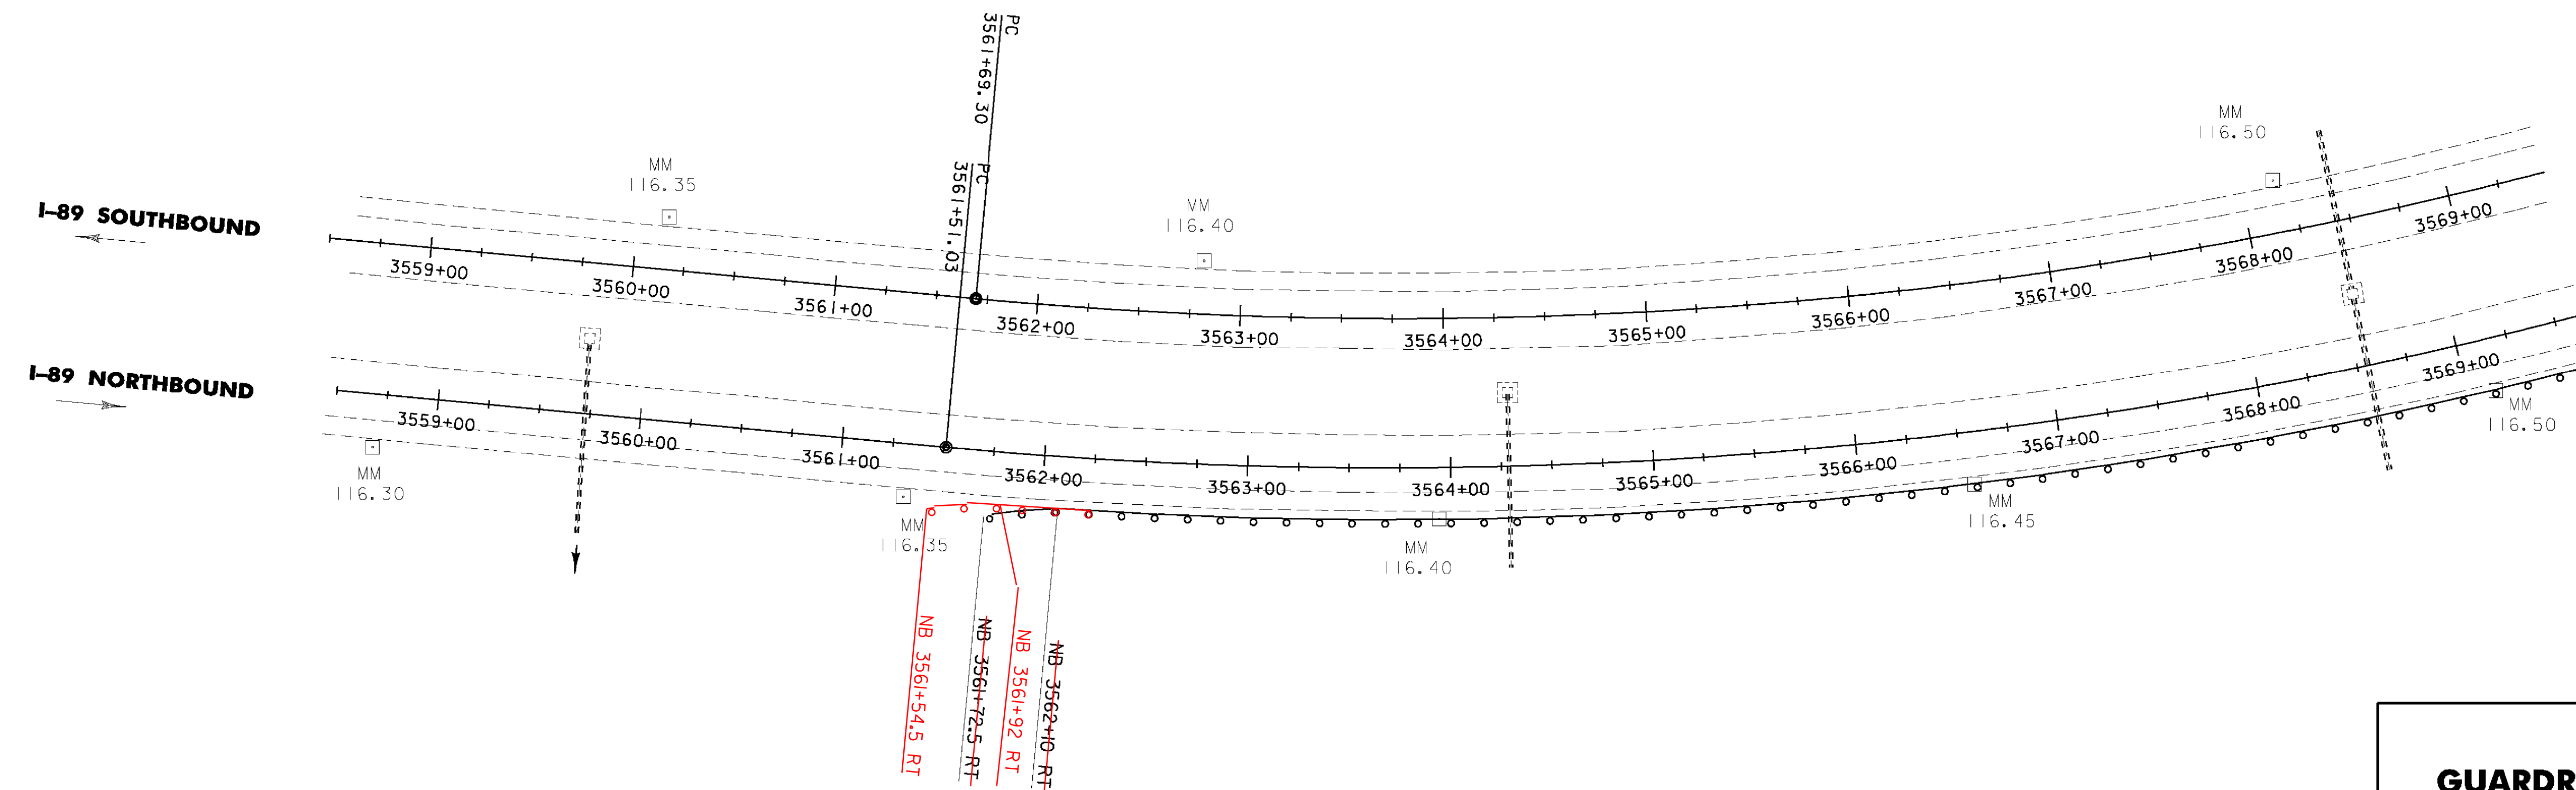

- 621.205 STEEL BEAM GUARDRAIL, GALVANIZED W/ 8 FEET POSTS
- NB 3562+10 RT ~ NB 3562+92 RT
- NB 3561+92 RT ~ NB 3562+67 RT

- 621.50 MANUFACTURED TERMINAL SECTION, FLARED
- NB 3561+72.5 RT ~ NB 3562+10 RT
- NB 3561+54.5 RT ~ NB 3561+92 RT

- 621.80 REMOVAL AND DISPOSAL OF GUARDRAIL
- NB 3561+71 RT ~ NB 3562+92 RT
- NB 3561+92 RT ~ NB 3562+67 RT

DETAILS ARE NOT TO SCALE

GUARDRAIL TREATMENT DETAIL SHEET 2

PROJECT NAME: ST. ALBANS - SWANTON
PROJECT NUMBER: IM 089-3(62)

| | |
|---------------------------|------------------------|
| FILE NAME: D96A058FRM.DGN | PLOT DATE: 03-SEP-2009 |
| PROJECT LEADER: K. ROBBIE | DRAWN BY: P. BEYOR |
| DESIGNED BY: P. BEYOR | CHECKED BY: S. MENARD |
| PLOT FILE: D96A058GRT2.1 | SHEET 39 OF 117 |