



# GUARDRAIL LOCATIONS

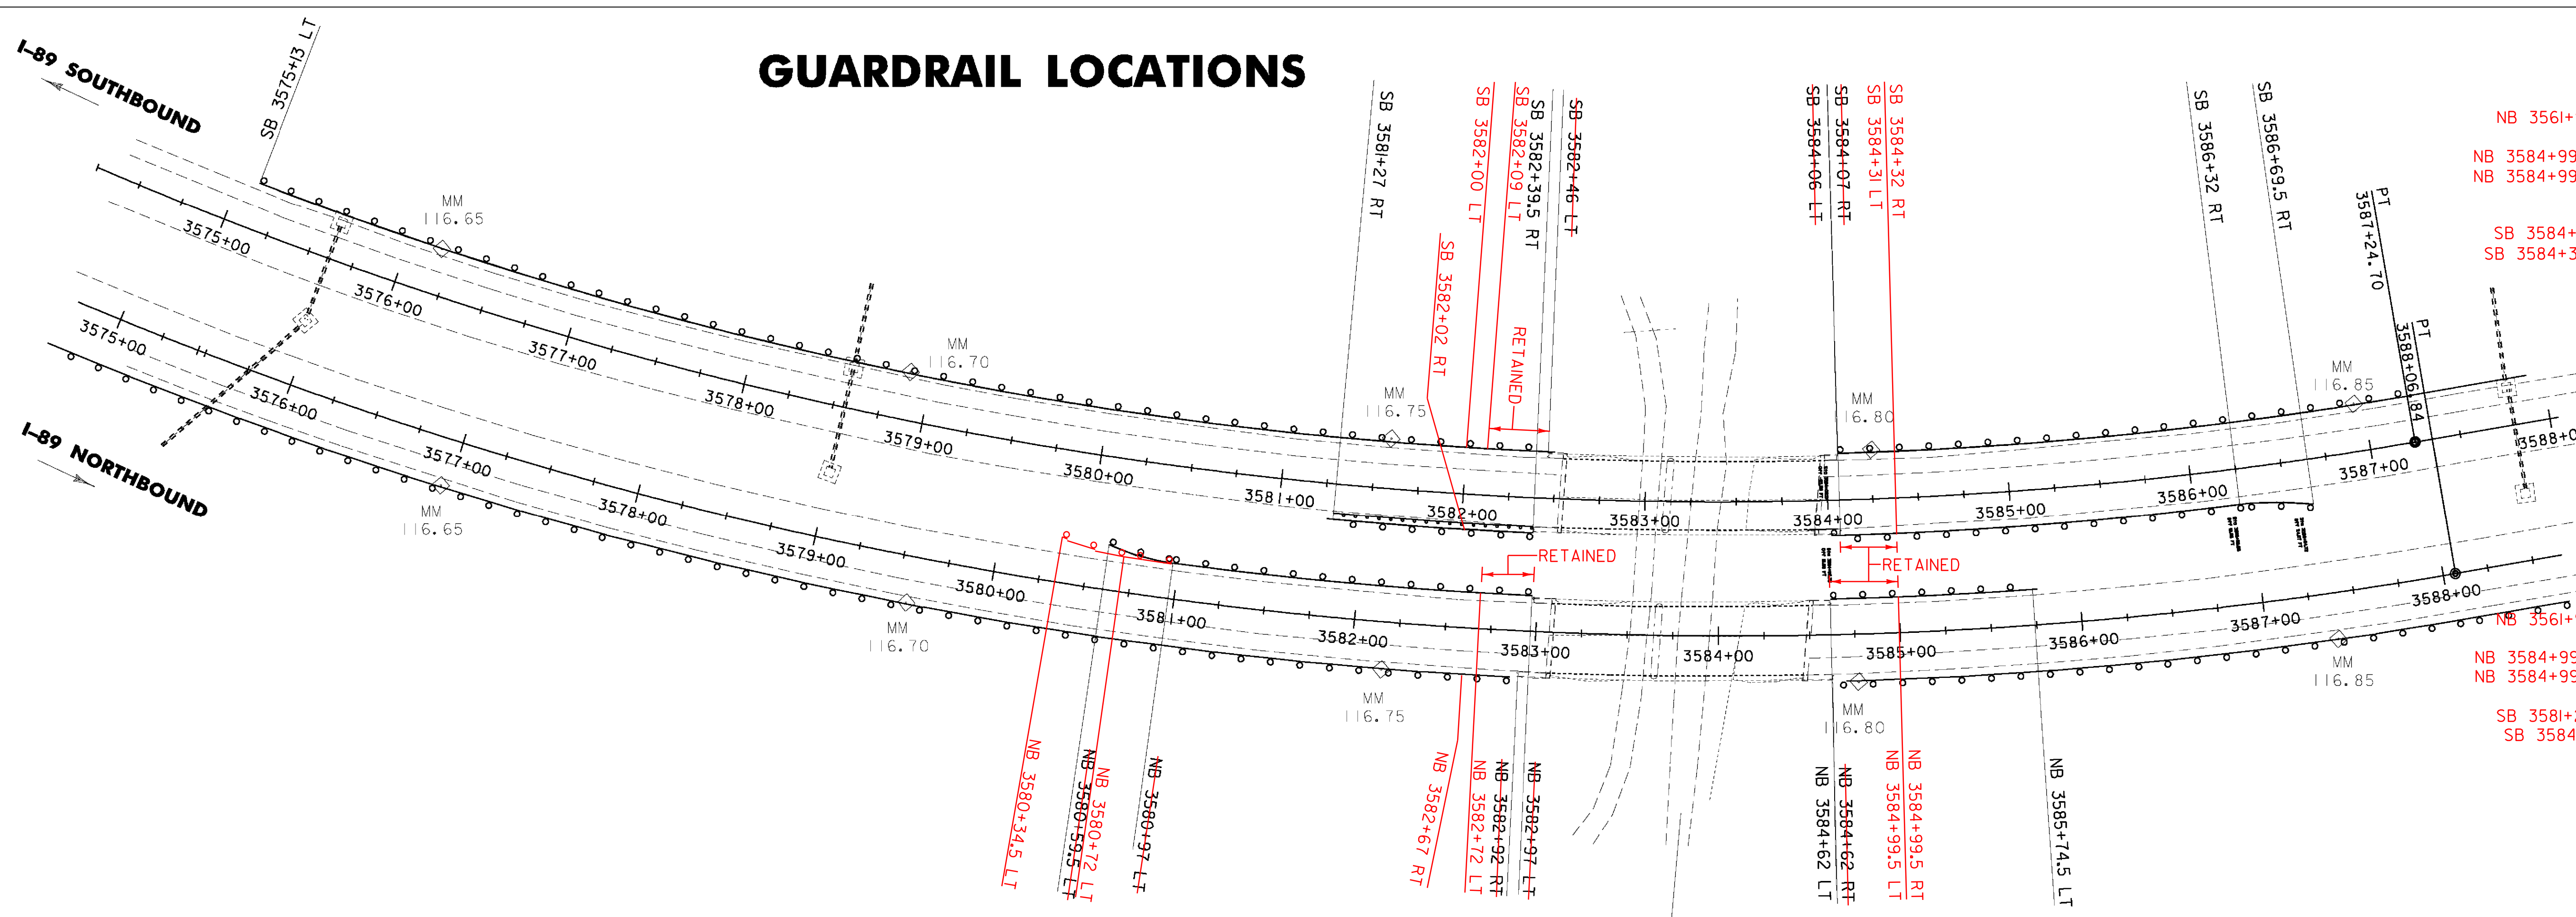

- 621.205 - STEEL BEAM GUARDRAIL, GALVANIZED W/8 FEET POSTS
  - SB 3584+31 LT
  - SB 3584+07 RT
  - SB 3584+06 LT
  - SB 3584+32 RT
  - SB 3584+31 LT
  - SB 3584+07 RT
  - SB 3584+06 LT
  - SB 3584+32 RT
- 621.50 MANUFACTURED TERMINAL SECTION, FLARED
  - SB 3580+59.5 LT
  - SB 3580+32 RT
  - SB 3580+34.5 LT
- 621.60 ANCHOR FOR STEEL BEAM RAIL
  - NB 3585+74.5 LT
  - SB 3575+13 LT
  - SB 3581+27 RT
  - SB 3584+99.5 RT
  - NB 3582+72 LT
  - SB 3582+00 LT
  - SB 3582+02 RT
  - SB 3584+31 LT
  - SB 3582+67 RT
  - NB 3585+74.5 LT
- 621.80 REMOVAL AND DISPOSAL OF GUARDRAIL
  - NB 3561+92 RT
  - NB 3580+59 LT
  - NB 3584+99.5 RT
  - SB 3575+13 LT
  - SB 3581+27 RT
  - SB 3584+31 LT
  - NB 3561+92 RT
  - NB 3580+59 LT
  - NB 3584+99.5 RT
  - SB 3575+13 LT
  - SB 3581+27 RT
  - SB 3584+31 LT
- 621.20 STEEL BEAM GUARDRAIL, GALVANIZED
  - NB 3580+72 LT
  - SB 3584+32 RT

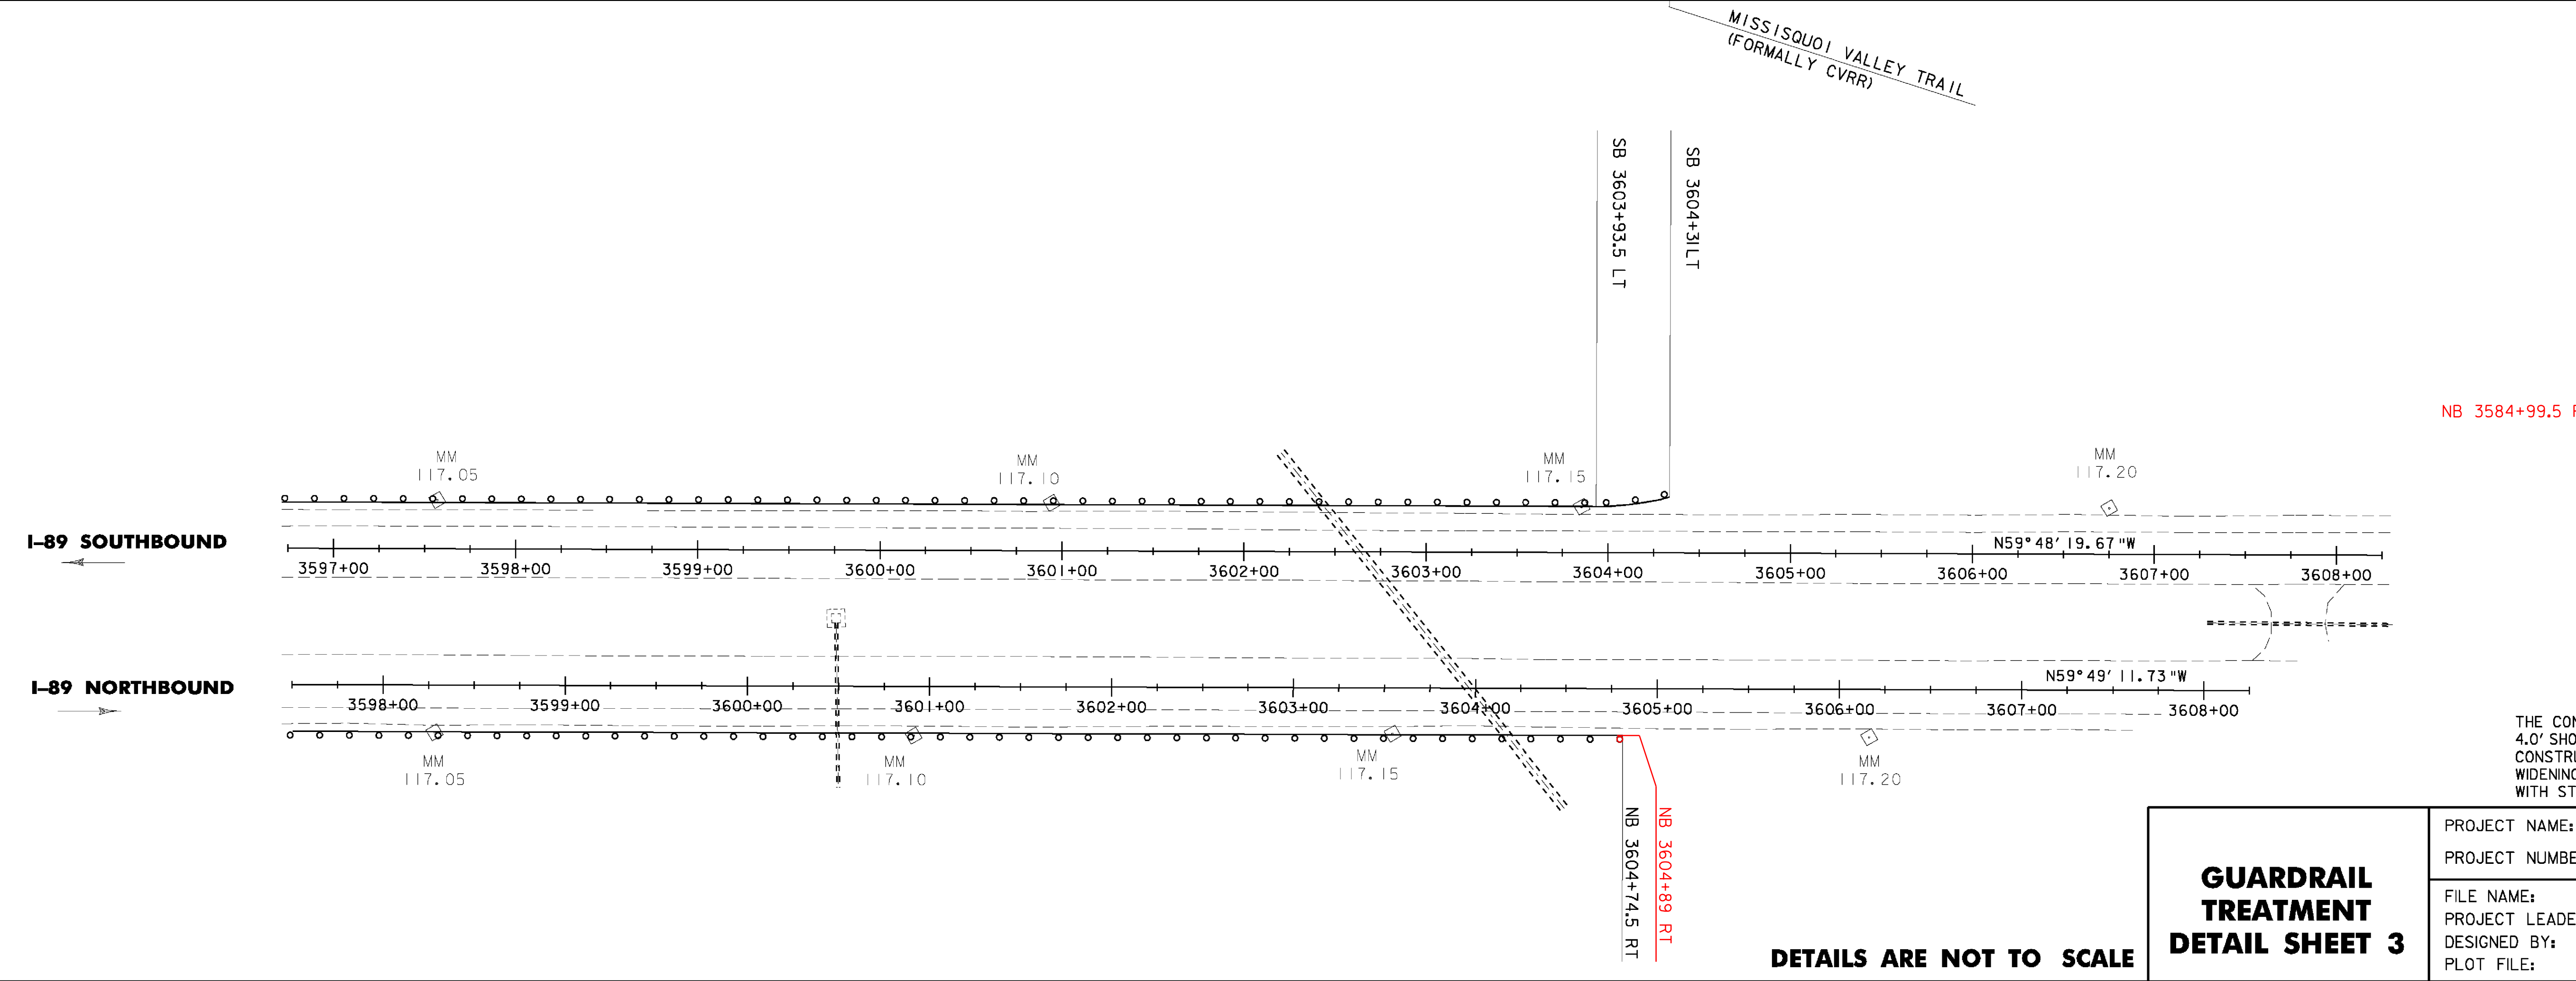

- 621.205 - STEEL BEAM GUARDRAIL, GALVANIZED W/8 FEET POSTS
  - SB 3584+62 RT
  - SB 3584+06 LT
- 621.50 MANUFACTURED TERMINAL SECTION, FLARED
  - SB 3603+93.5 LT
  - SB 3604+31 LT
- 621.60 ANCHOR FOR STEEL BEAM RAIL
  - NB 3604+74.5 RT
  - 3604+89.0
- 621.80 REMOVAL AND DISPOSAL OF GUARDRAIL
  - NB 3584+99.5 RT
  - SB 3584+06 LT
  - NB 3584+62 RT
  - NB 3604+81 RT
  - SB 3604+89 RT
  - SB 3584+06 LT
  - SB 3604+35 LT
  - SB 3604+31 LT

THE CONTRACTOR SHALL WIDEN WITH EARTH BORROW ADJACENT TO THE 4.0' SHOULDER TO PROVIDE BACKING FOR THE NEW GUARDRAIL AND TO CONSTRUCT A FLARE FOR THE END TERMINAL. CONSTRUCTION OF THE WIDENING AND TERMINAL FLARE SHALL BE COMPLETED IN ACCORDANCE WITH STANDARD G-19.

|   |                                    |
|---|------------------------------------|
| <b>GUARDRAIL TREATMENT<br/>DETAIL SHEET 3</b> | PROJECT NAME: ST. ALBANS - SWANTON |
|   | PROJECT NUMBER: IM 089-3(62)       |
|   | FILE NAME: D96A058FRM.DGN          |
|   | PLOT DATE: 03-SEP-2009             |
| PROJECT LEADER: K. ROBBIE                     | DRAWN BY: P. BEYOR                 |
| DESIGNED BY: P. BEYOR                         | CHECKED BY: S. MENARD              |
| PLOT FILE: D96A058GRT3.1                      | SHEET 40 OF 117                    |

DETAILS ARE NOT TO SCALE