


GUARDRAIL LOCATIONS

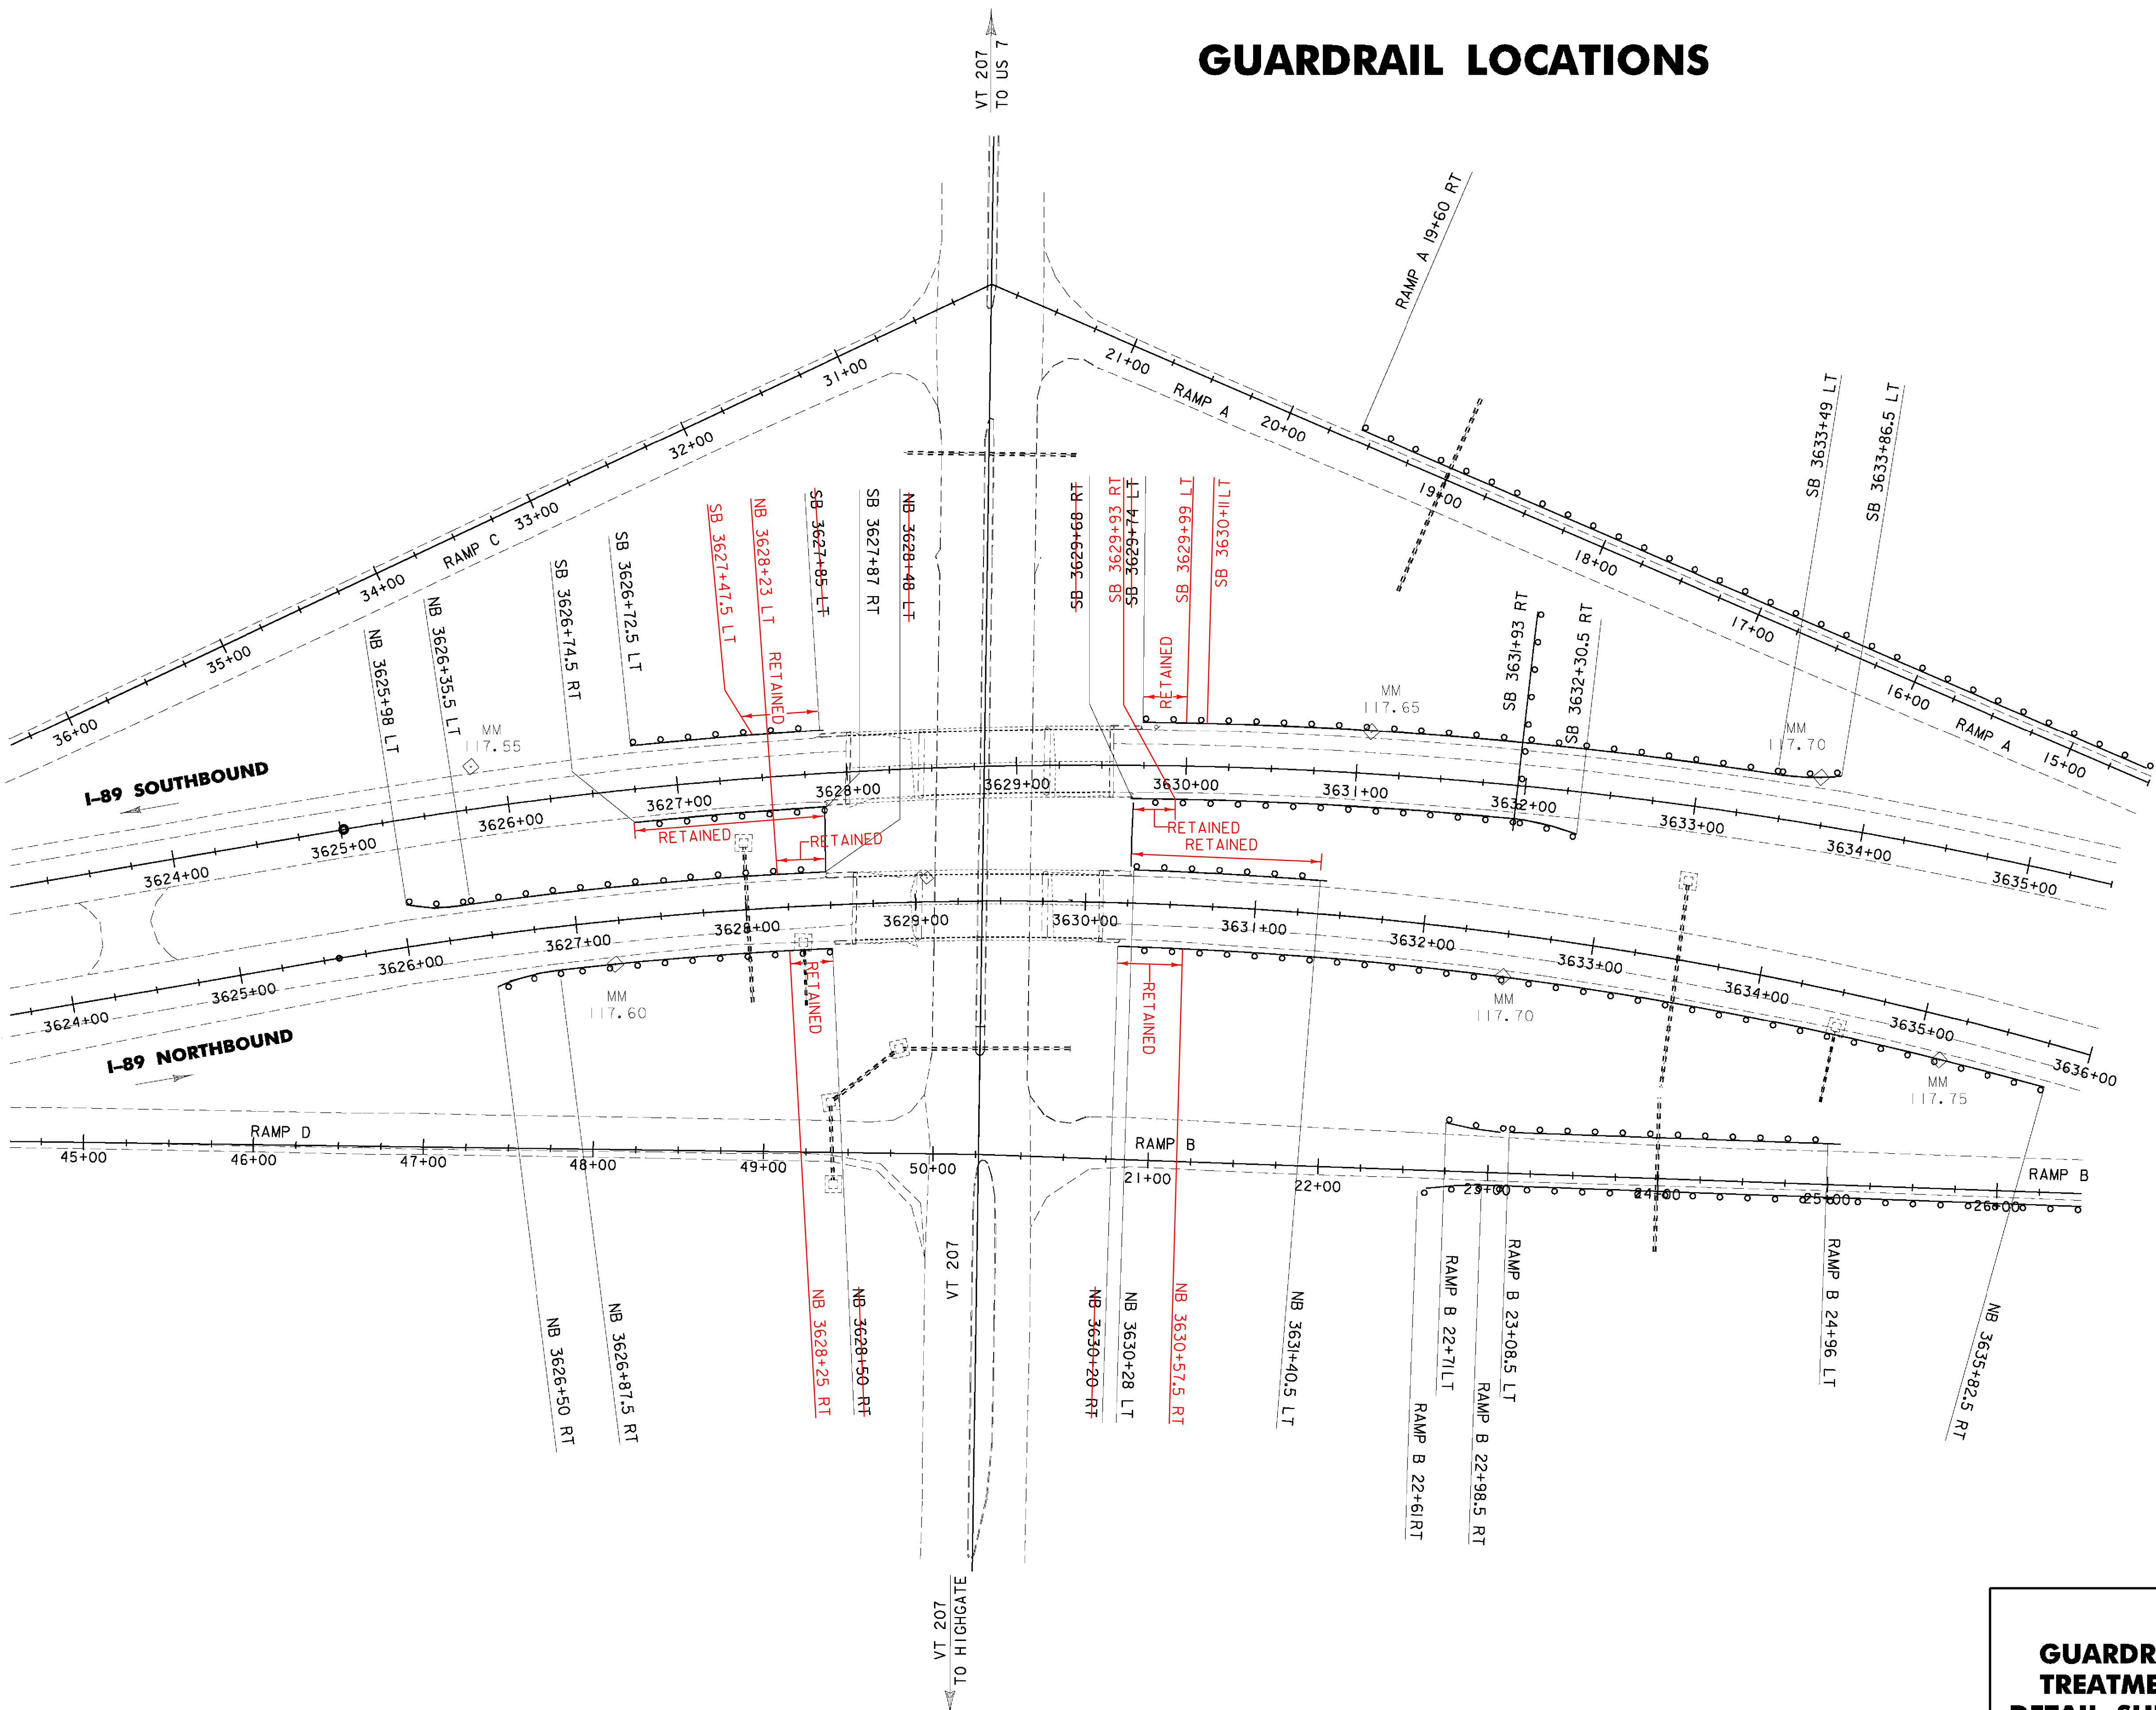

62I.20 STEEL BEAM GUARDRAIL, GALVANIZED

~~NB 3626+35.5 LT ~ NB 3628+48 LT NB 3628+23 LT~~
~~NB 3626+87.5 RT ~ NB 3628+50 RT NB 3628+25 RT~~
~~NB 3630+20 RT ~ NB 3635+82.5 RT~~
 NB 3630+28 LT ~ NB 3631+40.5 LT **RETAINED**
 SB 3626+74.5 RT ~ SB 3627+87 RT **RETAINED**
 SB 3626+72.5 LT ~ ~~SB 3627+85 LT SB 3627+47.5 LT~~
 SB 3629+93 RT ~~SB 3629+68 RT~~ ~ SB 3631+93 RT
 SB 3629+99 LT ~~SB 3629+74 LT~~ ~ SB 3633+49 LT
 RAMP A 19+60 RT ~ SB 3641+57.5 LT
 RAMP B 22+98.5 RT ~ NB 3644+40 RT
 RAMP B 23+08.5 LT ~ RAMP B 24+96 LT

62I.50 MANUFACTURED TERMINAL SECTION, FLARED

NB 3625+98 LT ~ NB 3626+35.5 LT
 NB 3626+50 RT ~ NB 3626+87.5 RT
 SB 3631+93 RT ~ SB 3632+30.5 RT
 SB 3633+49 LT ~ SB 3633+86.5 LT
 RAMP B 22+61 RT ~ RAMP B 22+98.5 RT
 RAMP B 22+71 LT ~ RAMP B 23+08.5 LT

62I.60 ANCHOR FOR STEEL BEAM RAIL

~~NB 3631+40.5 LT~~ SB 3630+11 LT
~~NB 3635+82.5 RT~~ SB 3627+47.5 LT
~~SB 3626+74.5 RT~~ SB 3629+93 RT
 SB 3626+72.5 LT NB 3630+57.5 RT
 RAMP A 19+60 RT
 RAMP B 24+96 LT

62I.80 REMOVAL AND DISPOSAL OF GUARDRAIL

NB 3625+98 LT ~~NB 3626+01 LT~~ ~ NB 3628+48 LT NB 3628+23 LT
 NB 3626+50 RT ~ NB 3628+50 RT NB 3628+25 RT
 NB 3630+44 RT ~~NB 3630+20 RT~~ ~ NB 3635+79 RT NB 3635+75 RT
~~NB 3630+28 LT~~ ~ ~~NB 3631+41 LT~~
 SB 3626+72.5 LT ~~SB 3626+73 RT~~ ~ ~~SB 3627+87 RT~~ SB 3627+47.5 LT
~~SB 3626+75 LT~~ ~ ~~SB 3627+83 LT~~
 SB 3629+92 RT ~~SB 3629+68 RT~~ ~ ~~SB 3632+34 RT~~ SB 3632+33 RT
 SB 3629+99 LT ~~SB 3629+74 LT~~ ~ ~~SB 3633+84 LT~~ SB 3633+86.5 RT
 RAMP A 19+60 RT ~ SB 3641+95 LT
 RAMP B 22+61 RT ~ NB 3644+40 RT
 RAMP B 22+71 LT ~ RAMP B 24+96 LT

62I.205 STEEL BEAM GUARDRAIL, GALVANIZED W/ 8 FOOT POSTS

NB 3630+57.5 RT ~ NB 3635+84.5 RT

THE CONTRACTOR SHALL WIDEN WITH EARTH BORROW ADJACENT TO THE 4.0' SHOULDER TO PROVIDE BACKING FOR THE NEW GUARDRAIL AND TO CONSTRUCT A FLARE FOR THE END TERMINAL. CONSTRUCTION OF THE WIDENING AND TERMINAL FLARE SHALL BE COMPLETED IN ACCORDANCE WITH STANDARD G-19.

GUARDRAIL TREATMENT DETAIL SHEET 4	PROJECT NAME: ST. ALBANS - SWANTON
	PROJECT NUMBER: IM 089-3(62)
	FILE NAME: D96A058FRM.DGN PLOT DATE: 03-SEP-2009
	PROJECT LEADER: K. ROBBIE DRAWN BY: P. BEYOR
DESIGNED BY: P. BEYOR CHECKED BY: S. MENARD	
PLOT FILE: D96A058GRT4.1 SHEET 41 OF 117	

DETAILS ARE NOT TO SCALE