


NB 3491+76 CL
 SKEW: 89° 56' LT

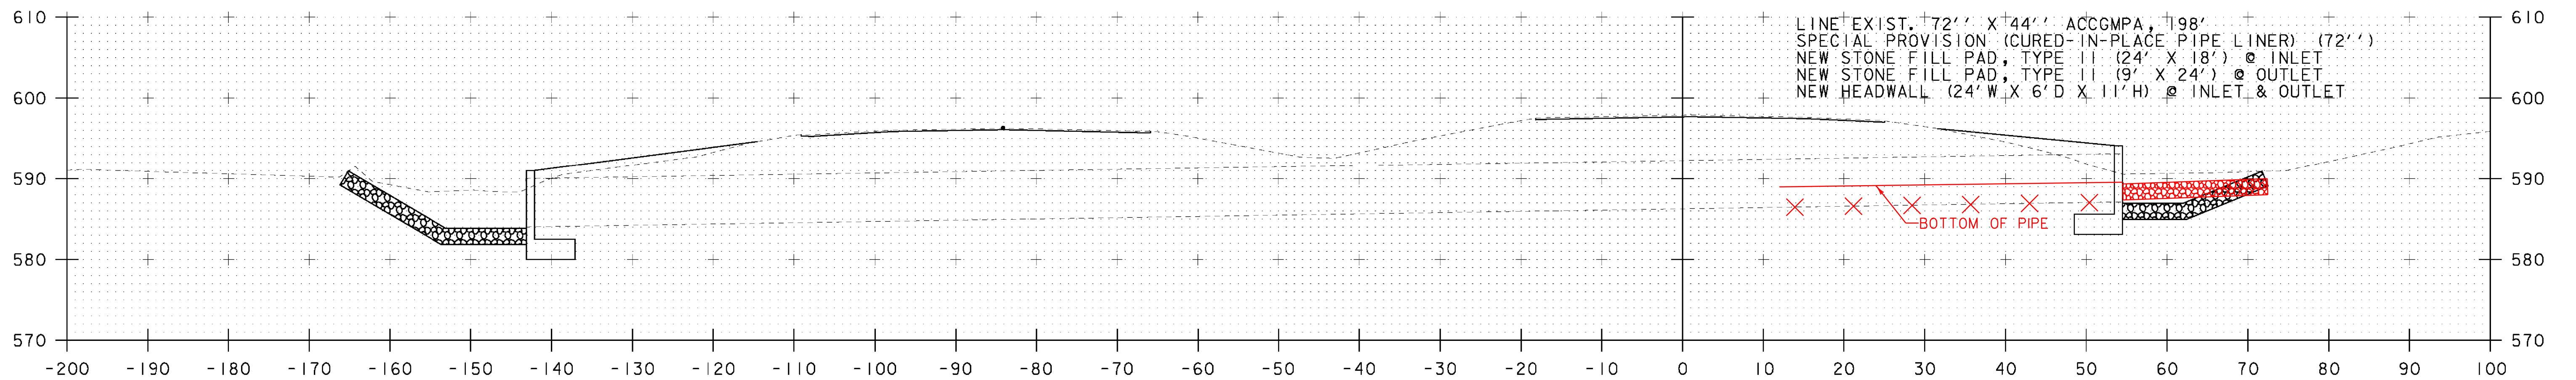

NB 3487+45 CL
 SKEW: 61° 31' RT

NB DRAINAGE CROSS SECTIONS #7

PROJECT NAME: ST. ALBANS - SWANTON
 PROJECT NUMBER: IM 089-3(62)

FILE NAME: D96A058NBXS.DGN PLOT DATE: 26-AUG-2009
 PROJECT LEADER: K. ROBBIE DRAWN BY: P. PELOQUIN
 DESIGNED BY: P. PELOQUIN CHECKED BY: S. MENARD
 D96A058NDS7.I SHEET 54 OF 117

STA. 3487+45 TO STA. 3491+76