



NB 3568+55 CL
SKEW: 89° 51' RT

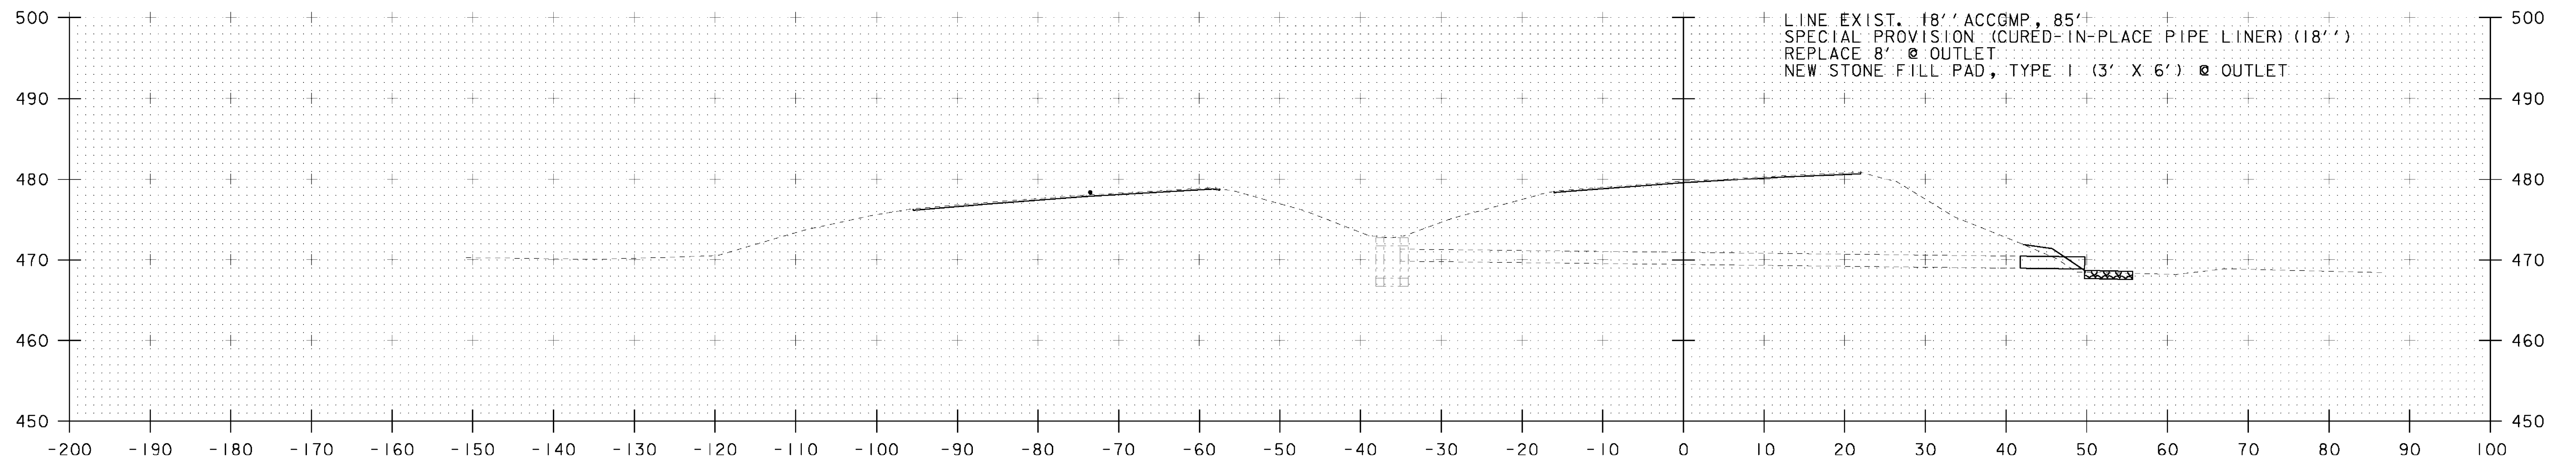

NB 3564+29 CL
SKEW: 89° 51' RT

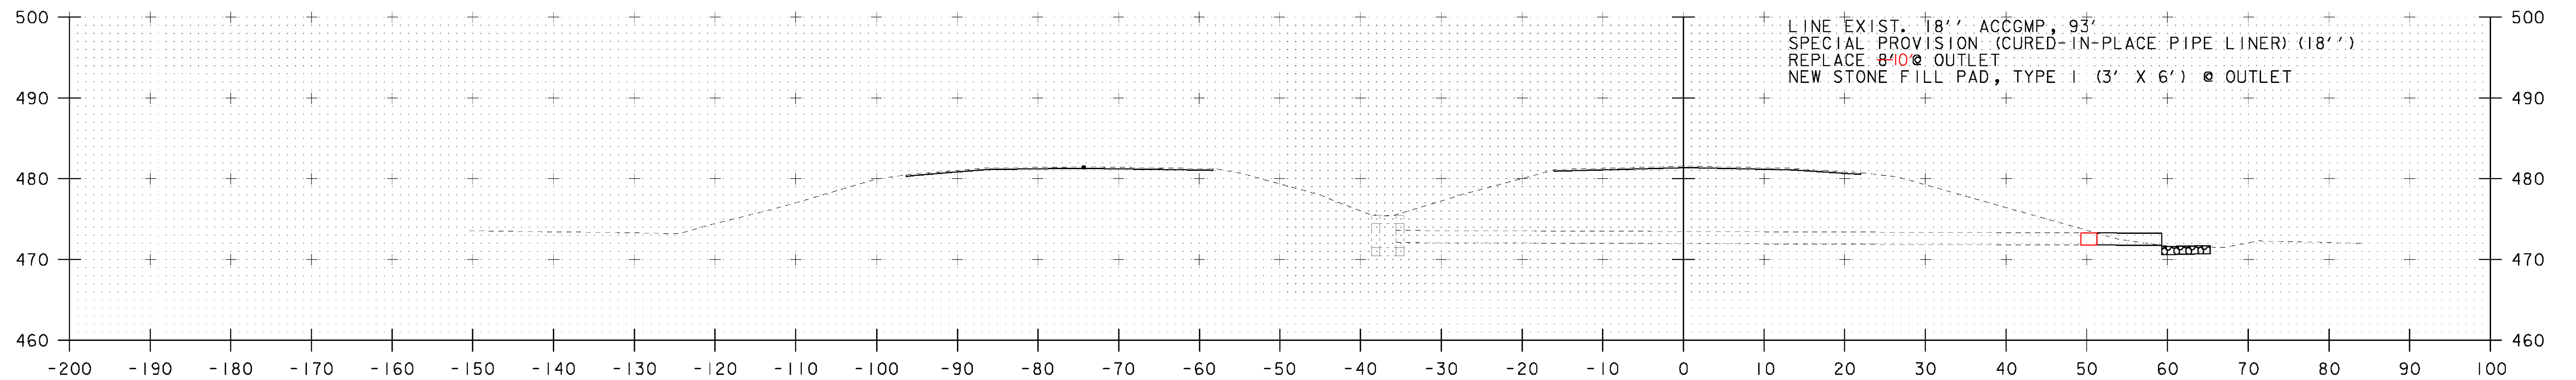

NB 3559+72 CL
SKEW: 88° 31' RT

NB DRAINAGE CROSS SECTIONS #15

STA. 3559+72 TO STA. 3568+55

PROJECT NAME: ST. ALBANS - SWANTON

PROJECT NUMBER: IM 089-3(62)

FILE NAME: D96A058NBXS.DGN

PLOT DATE: 26-AUG-2009

PROJECT LEADER: K. ROBBIE

DRAWN BY: P. PELOQUIN

DESIGNED BY: P. PELOQUIN

CHECKED BY: S. MENARD

D96A058NDXS15.J

SHEET 62 OF 117