


NB 3575+76 CL
 SKEW: 61° 07' LT

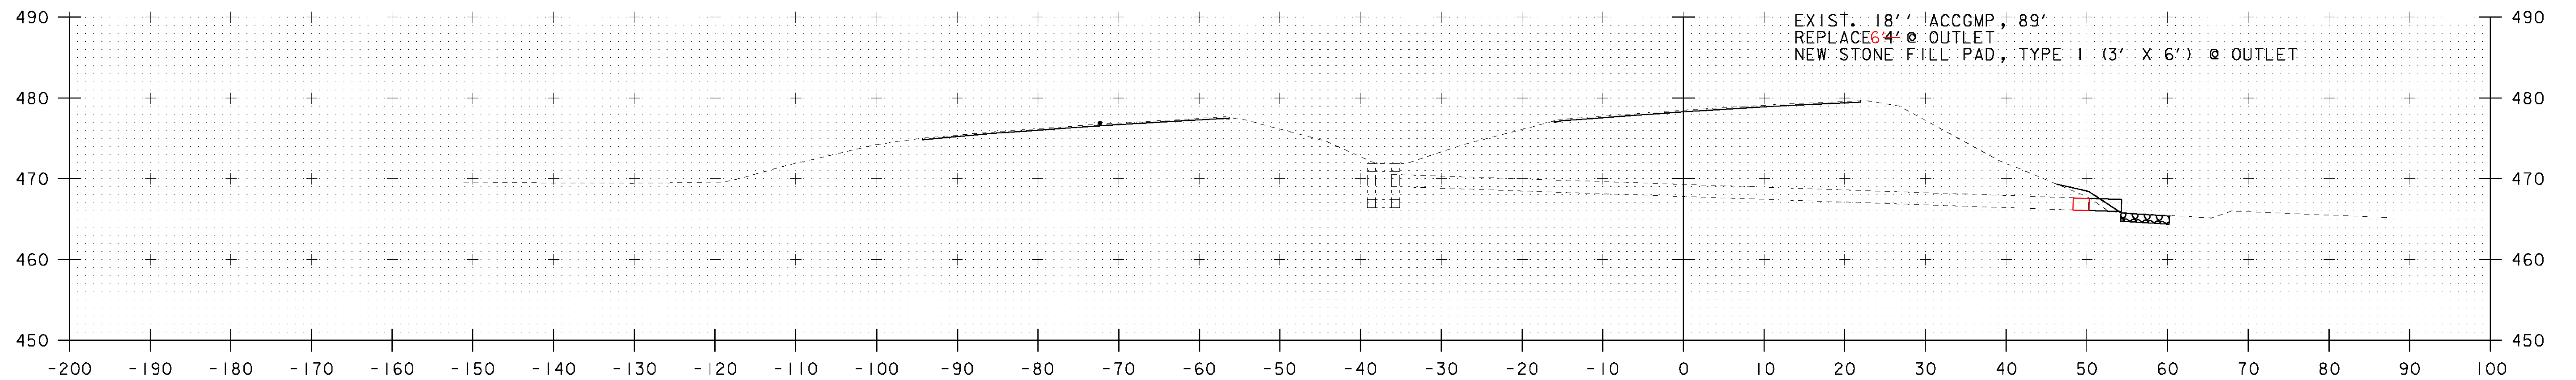

NB 3571+90 CL
 SKEW: 89° 57' LT

NB DRAINAGE CROSS SECTIONS #16

PROJECT NAME: ST. ALBANS - SWANTON
 PROJECT NUMBER: IM 089-3(62)

FILE NAME: D96A058NBXS.DGN PLOT DATE: 26-AUG-2009
 PROJECT LEADER: K. ROBBIE DRAWN BY: P. PELOQUIN
 DESIGNED BY: P. PELOQUIN CHECKED BY: S. MENARD
 D96A058NDXS16.I SHEET 63 OF 117

STA. 3571+90 TO STA. 3575+76