



EXIST. 18'' ACCGMP, 86'
NO PROJECT CONSTRUCTION ANTICIPATED

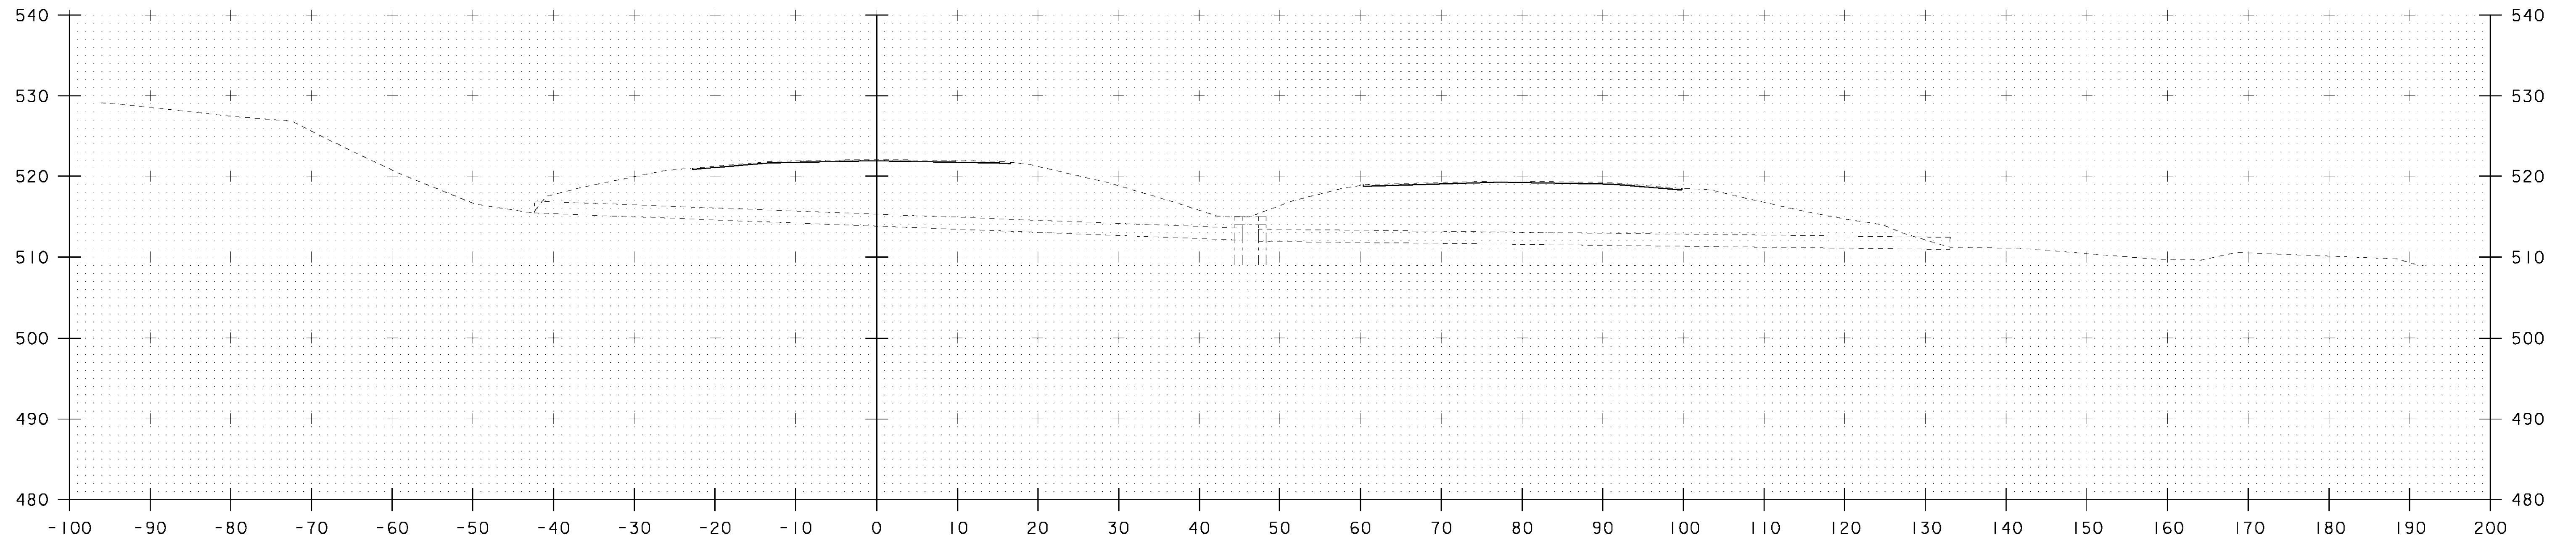

SB 3541+54 CL
SKEW: 74° 36' LT

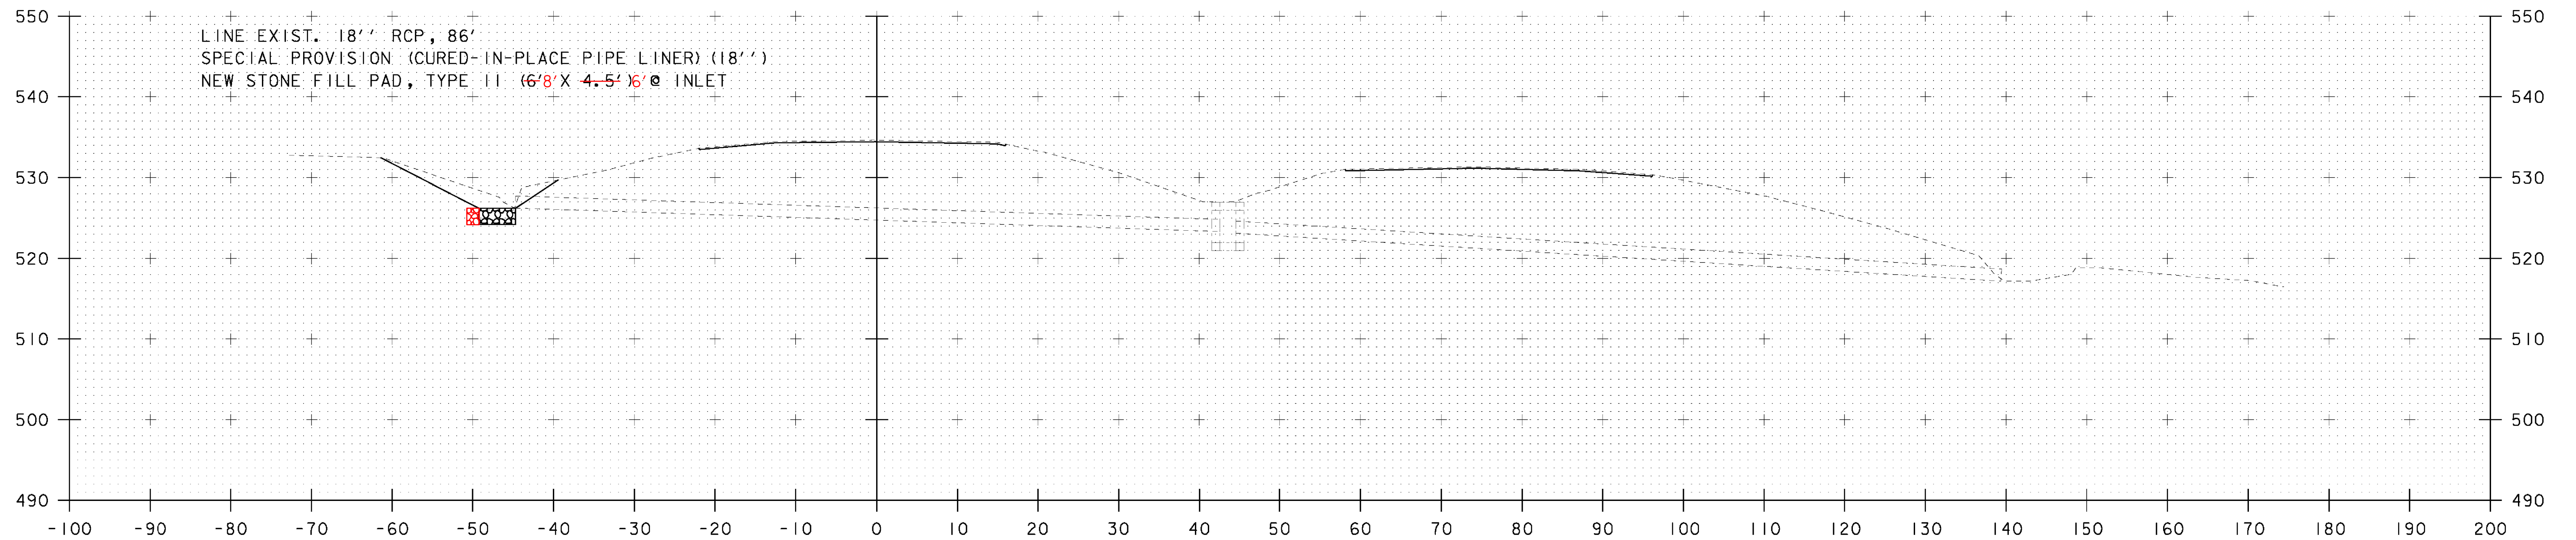

LINE EXIST. 18'' RCP, 86'
SPECIAL PROVISION (CURED-IN-PLACE PIPE LINER) (18'')
NEW STONE FILL PAD, TYPE II (6'8" X 4.5' X 6" @ INLET

SB 3536+87 CL
SKEW: 89° 19' RT

SB DRAINAGE CROSS SECTIONS #14

PROJECT NAME: ST. ALBANS - SWANTON
PROJECT NUMBER: IM 089-3(62)

FILE NAME: D96A058SBXS.DGN PLOT DATE: 26-AUG-2009
PROJECT LEADER: K. ROBIE DRAWN BY: P. PELOQUIN
DESIGNED BY: P. PELOQUIN CHECKED BY: S. MENARD
D96A058SDXS14.J SHEET 83 OF 117

STA. 3536+86 TO STA. 3541+54