
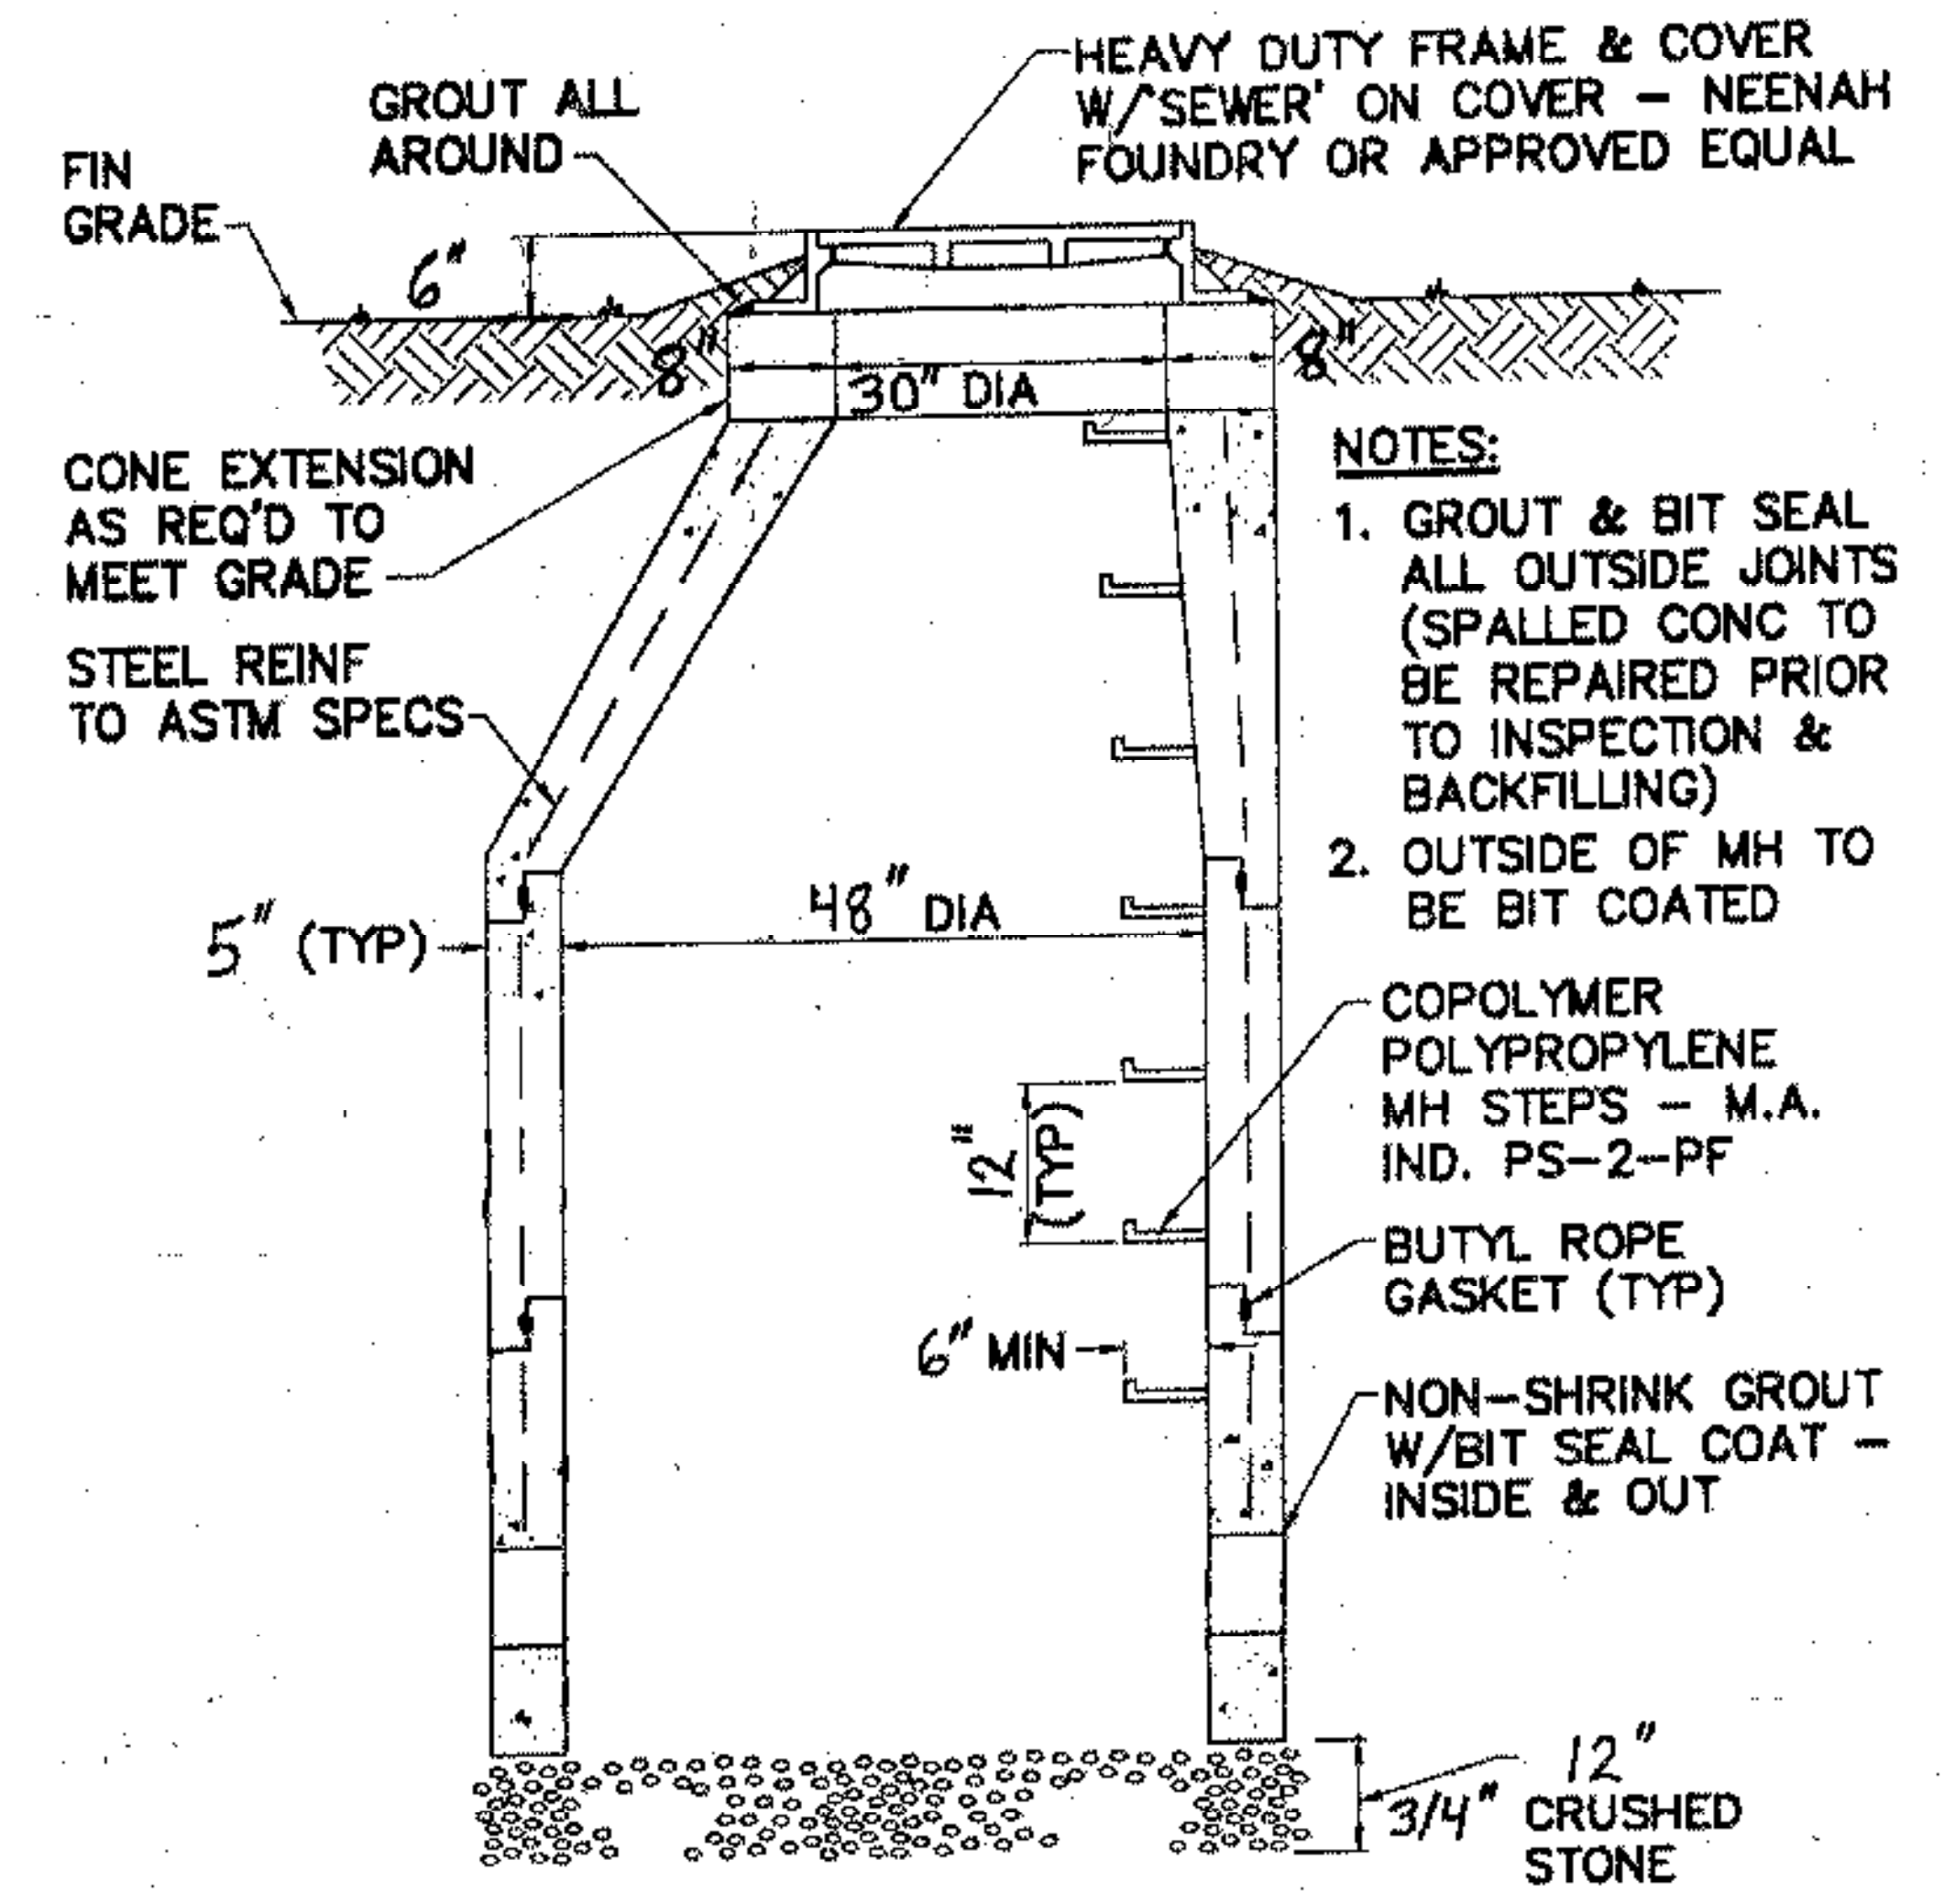


# SEWAGE MANHOLE AND SLEEVE DETAIL

# DELETED

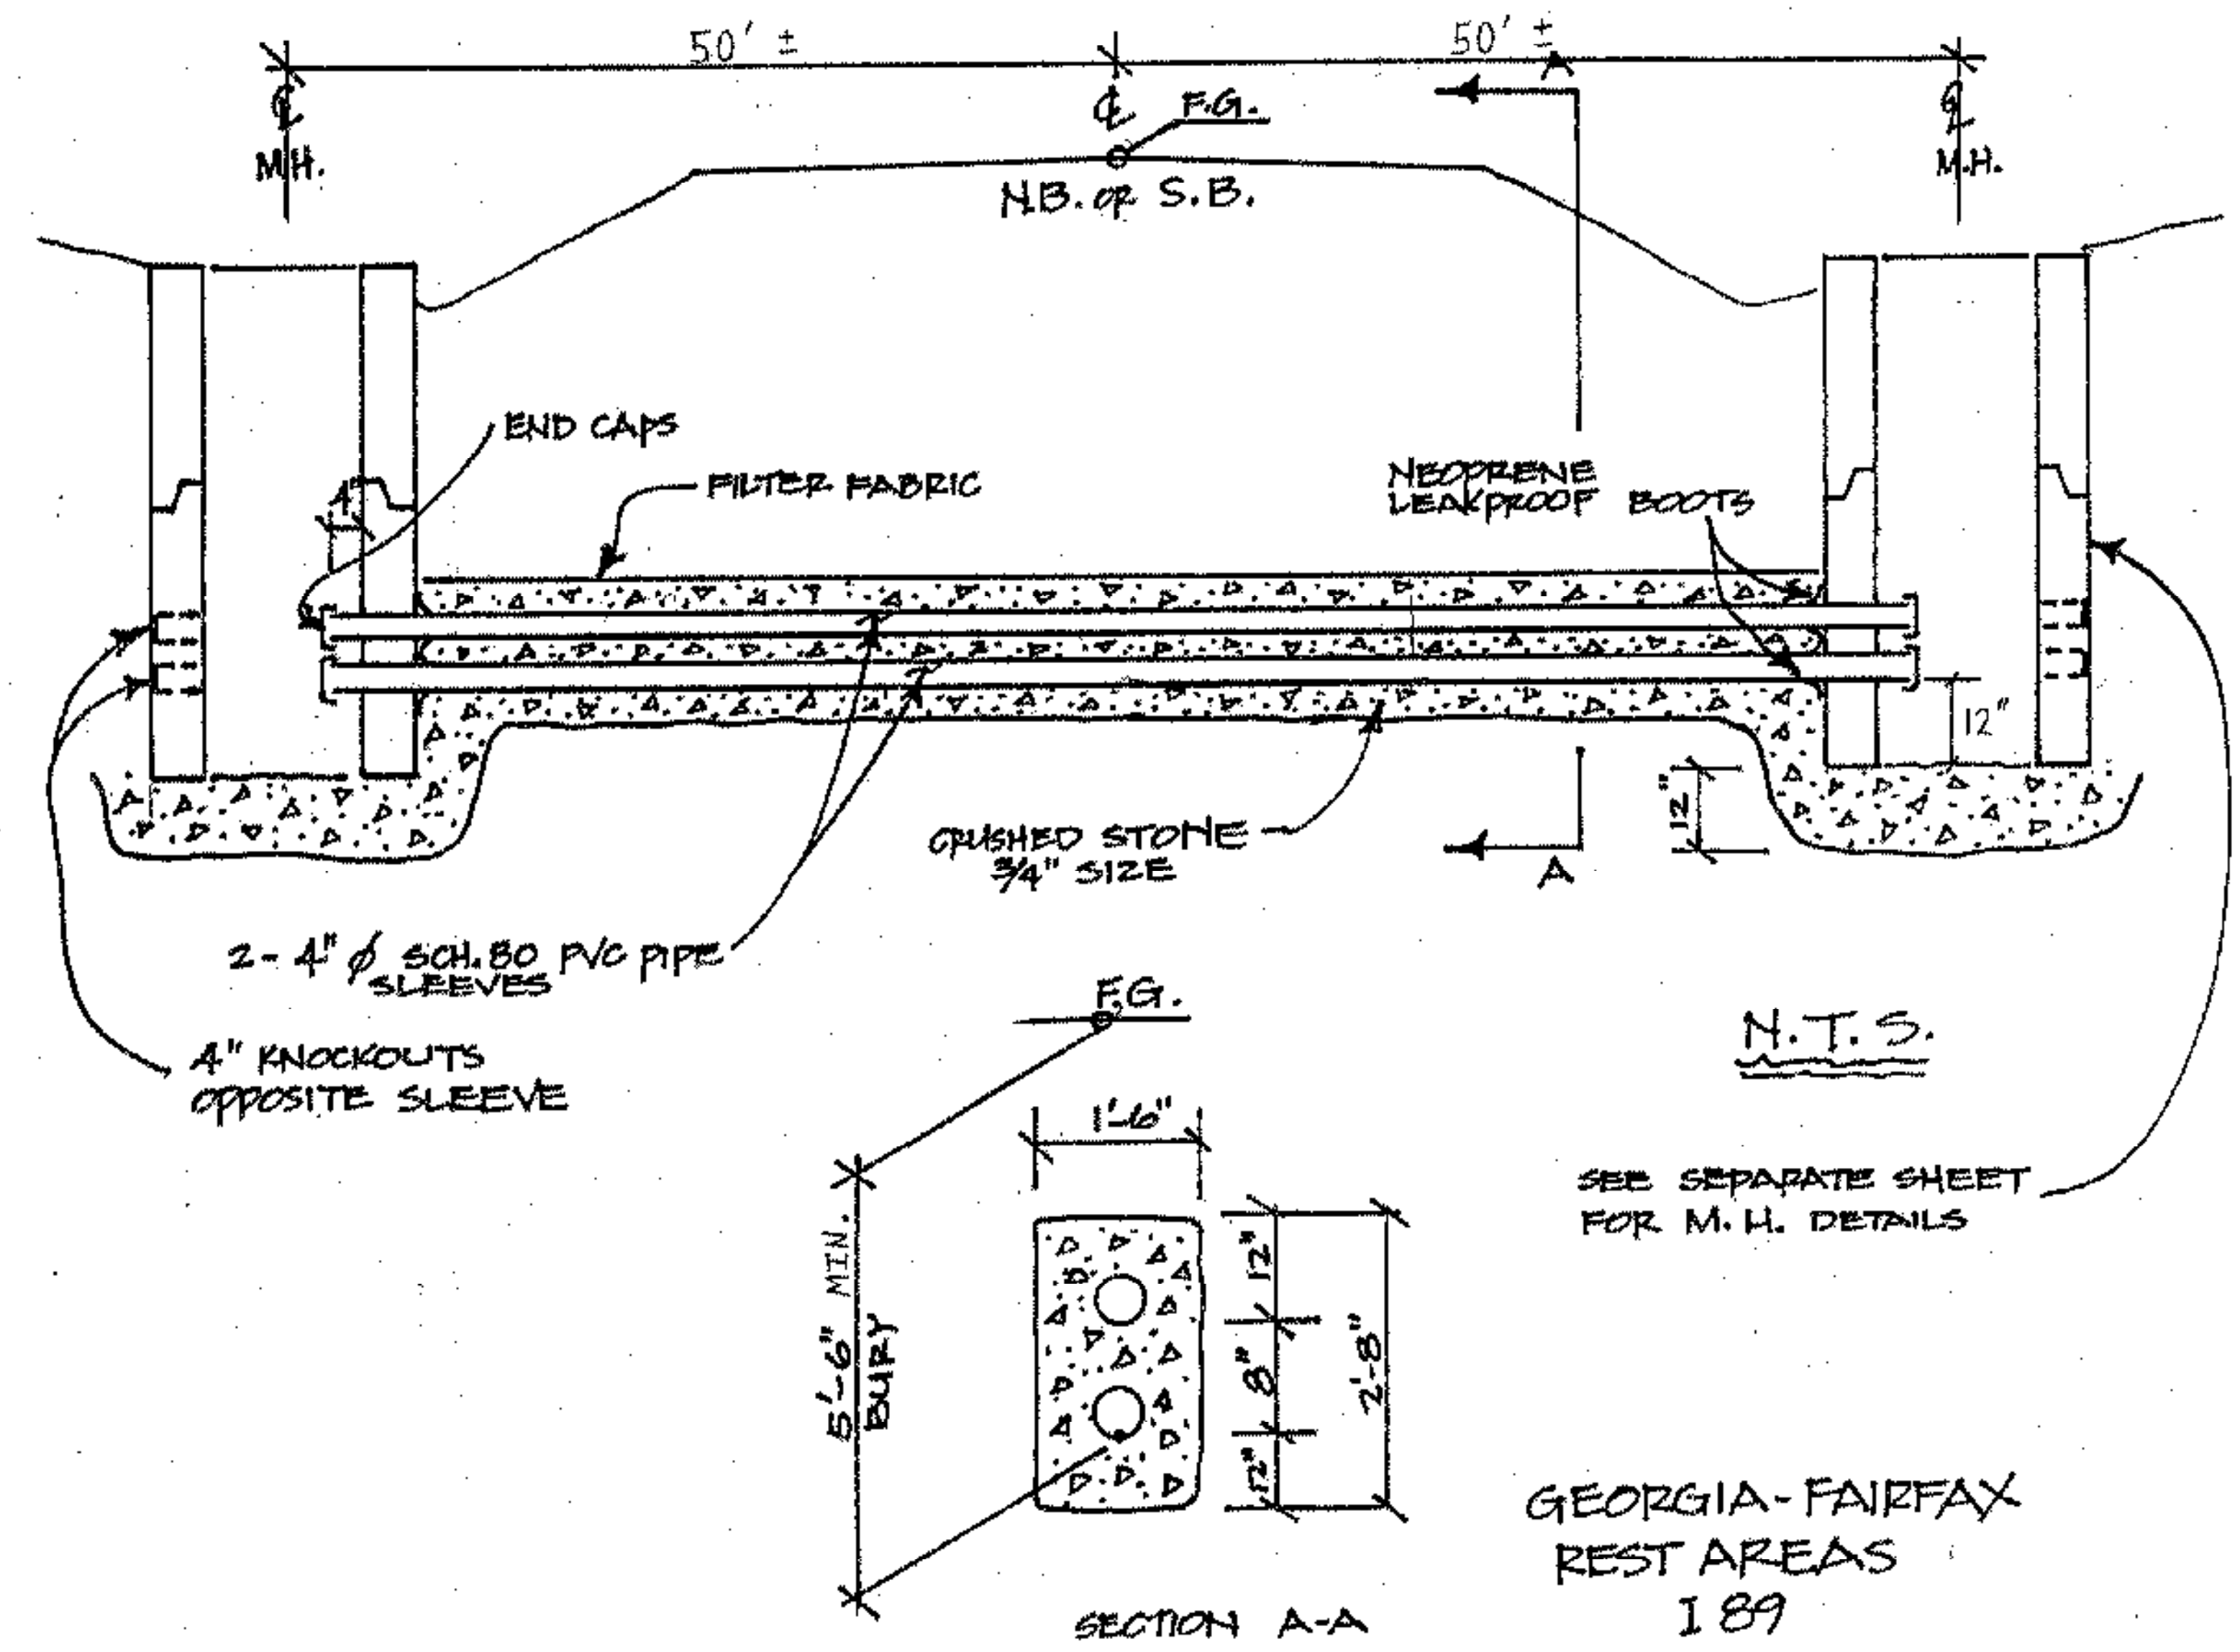

SEWAGE AIR RELEASE MANHOLE DETAIL  
NOT TO SCALE

NORTHBOUND AND SOUTHBOUND  
MM 110.32

NOT TO SCALE

APD  
"REVISED": JUNE 30, 1997

PROJECT: GEORGIA - FAIRFAX	PROJECT NO.: IM-089-3(26)
DESIGN FILE NAME: /S0DB/B7A007A/DA007ERM.DGN	PLOT DATE: 30-JUN-1997
IPARM FILE NAME: DA007SEW	SURVEY DATE:
SURVEYED BY:	DRAWN BY: SQUAD B
SQUAD LEADER: DELLA SANTA	SHEET: 29A OF 121