


NOTE: REMOVE ALL EXISTING DELINEATORS AND MILE POST PLAQUES

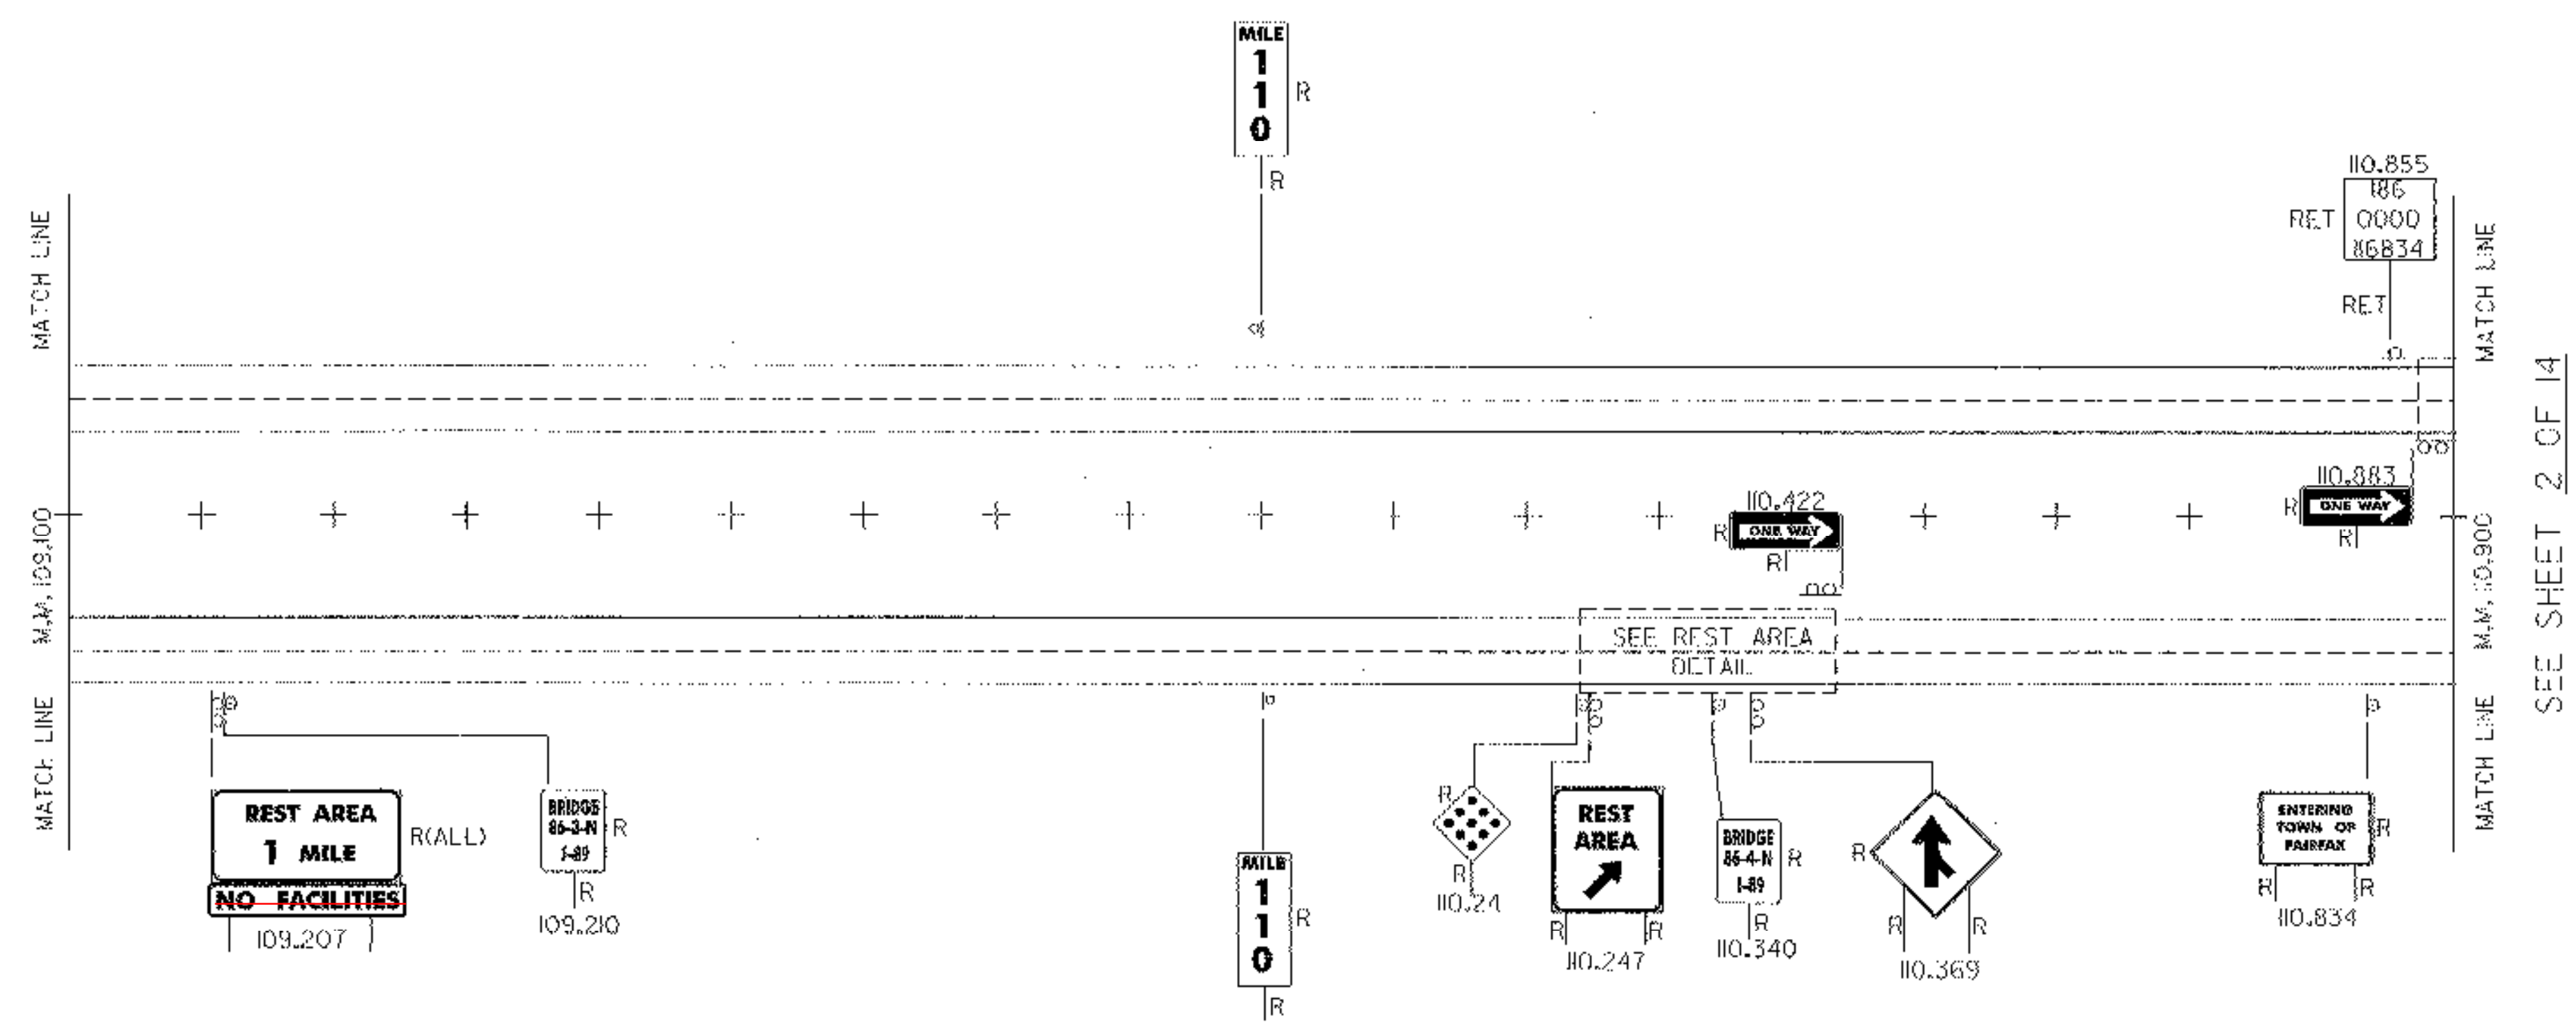

LEGEND:
 R = REMOVE
 RET = RETAIN
 S = SALVAGE

NOT TO SCALE

SIGN LAYOUT EXISTING SIGNS	PREPARED BY JHK DATE 8/96
	CHECKED BY RPD DATE 2/97
	DESIGN SUPERVISOR ABK DATE 8/96
	PROJ. GEORGIA-FAIRFAX IM-089-3(26)
TRAFFIC SHEET NO. 1 OF 14	
SHEET 31 OF 121 SHEETS	