


SEE SIGN SUMMARY SHEET

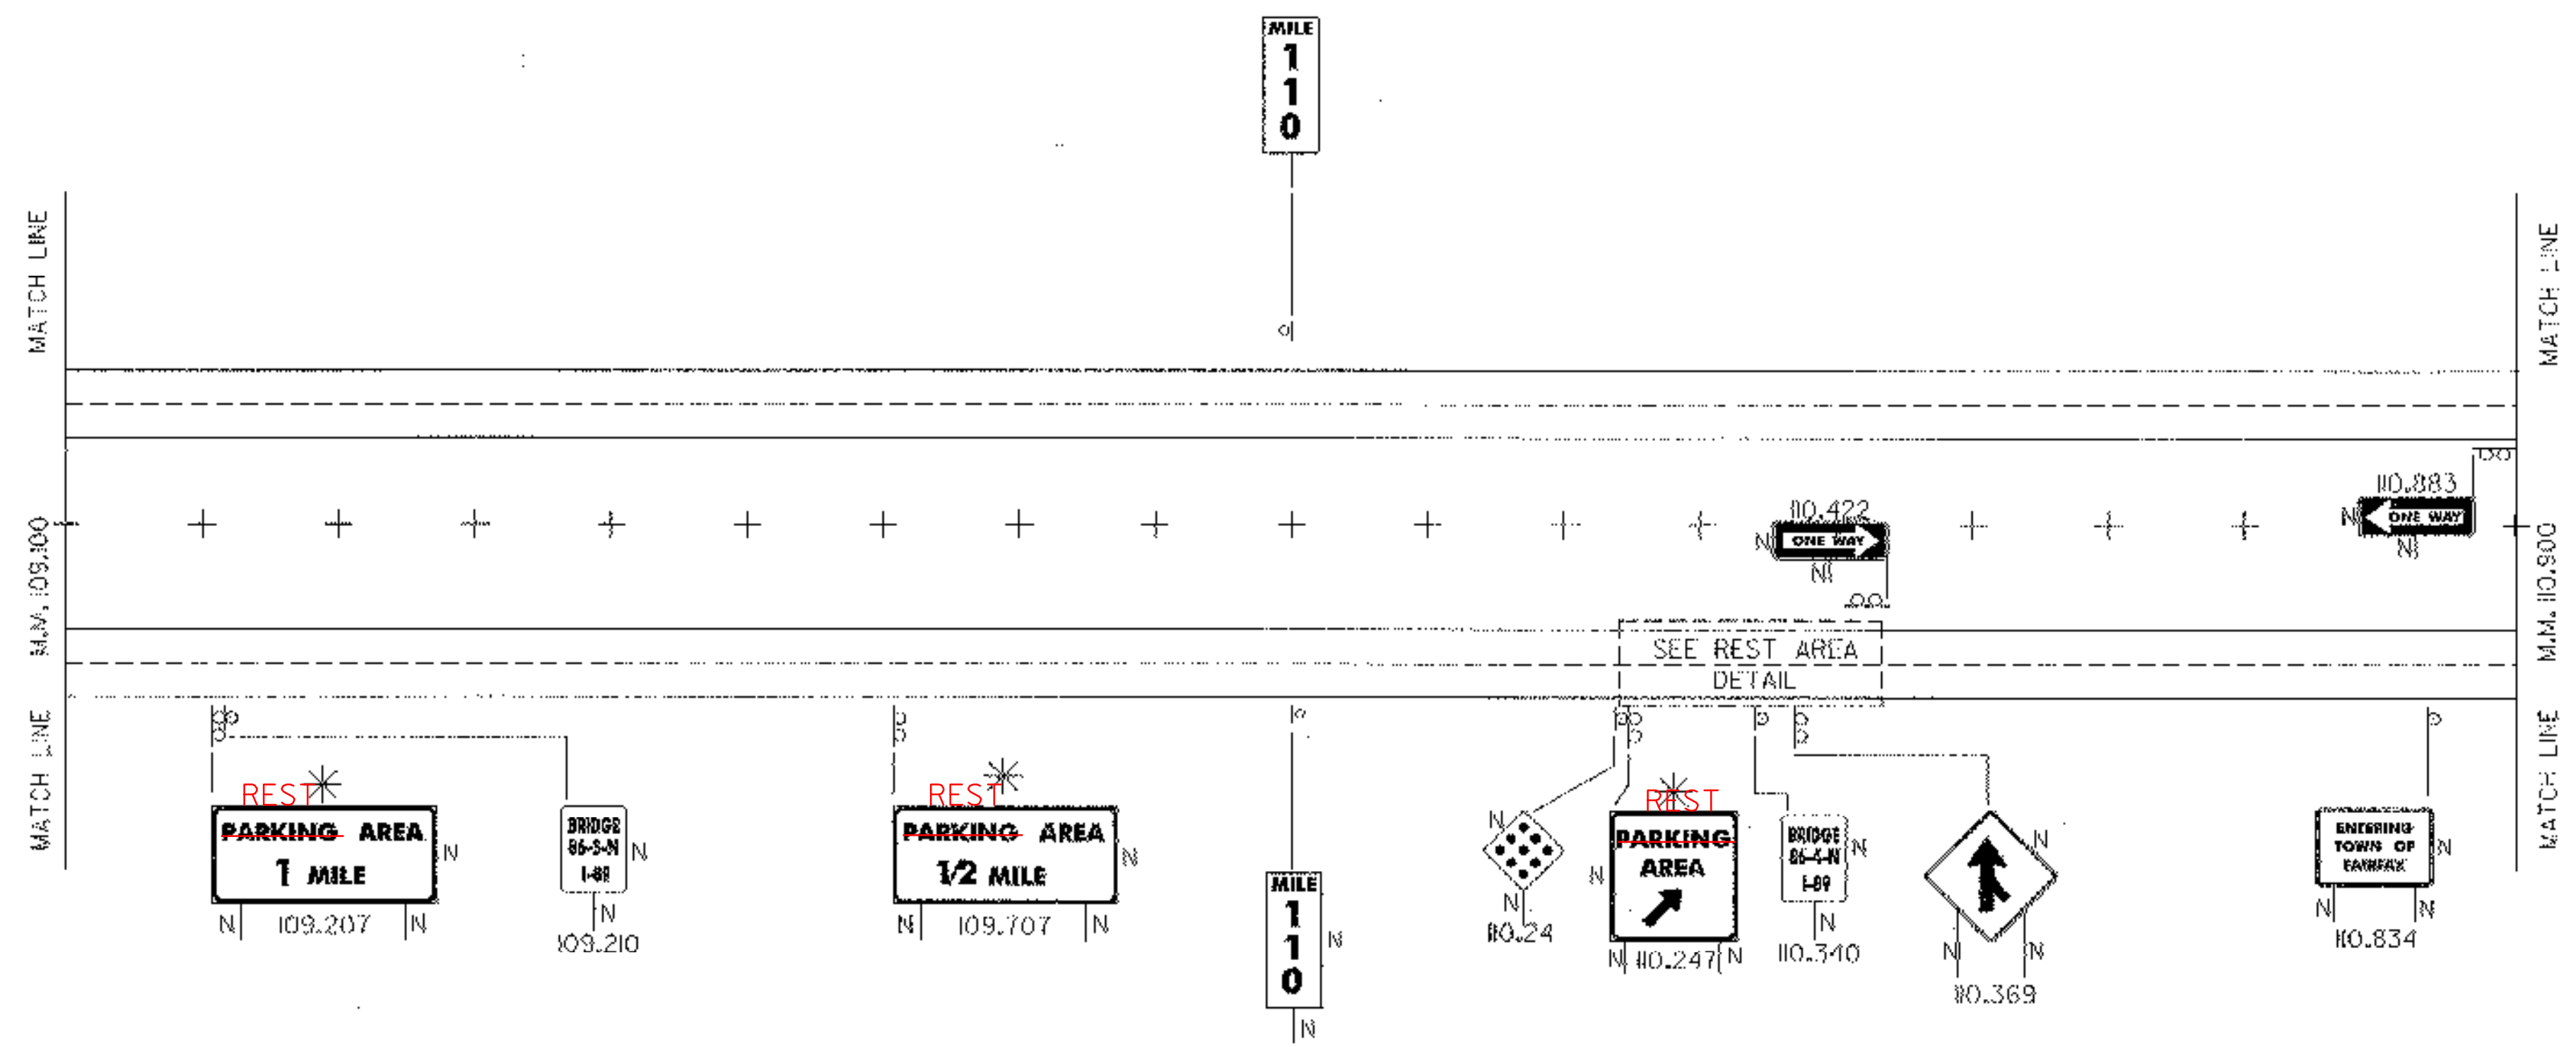

NOTE: REPLACE ALL DELINEATORS AND MILE POST PLAQUES WITH NEW, REFER TO STANDARDS E-197, E-198 AND E-199 FOR MATERIALS AND PLACEMENT

* NOTE:
IT WILL BE DETERMINED BY THE RESIDENT ENGINEER AT THE TIME OF CONSTRUCTION WHICH SIGN APPLICATION WILL BE USED FOR THE REST AREA'S. IF THE REST AREA FACILITIES ARE OPEN THEN IT IS SIGNED AS A REST AREA, IF NO FACILITIES IT WILL BE SIGNED AS A PARKING AREA.

SEE SHEET 4 OF 14

LEGEND:
N = NEW
R = REMOVE
RET = RETAIN
S = SALVAGE

NOT TO SCALE

SIGN LAYOUT
NEW SIGNS

PREPARED BY JWK DATE 8/26
 CHECKED BY RPD DATE 2/27
 DESIGN SUPERVISOR ARK DATE 8/26
 PROJ. GEORGIA FAIRFAX IM-089-3(26)
 TRAFFIC SHEET NO. 3 OF 14
 SHEET 33 OF 121 SHEETS