



REMOVAL AND DISPOSAL
OF GUARD RAIL
NB MM 107.30 RT. ~ MM 107.34 RT.

SNOW FENCE - GALVANIZED
(FOR BRIDGE # 86N)
NB MM 107.46 LT.
NB MM 107.46 RT.

STEEL BEAM GUARD RAIL
NB MM 107.32 RT. ~ MM 107.34 RT.

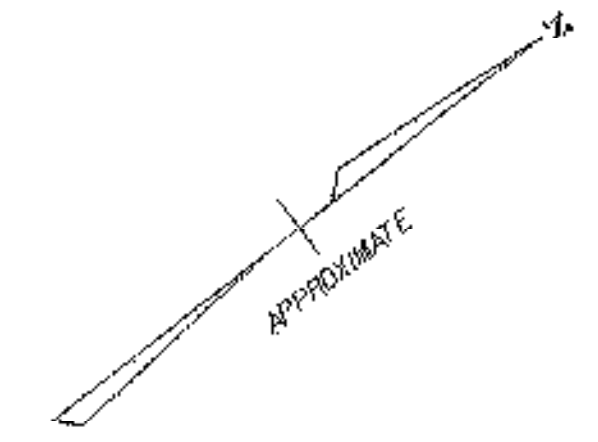

NB MM 106.90
BEGIN PROJECT IM-089-3(26)

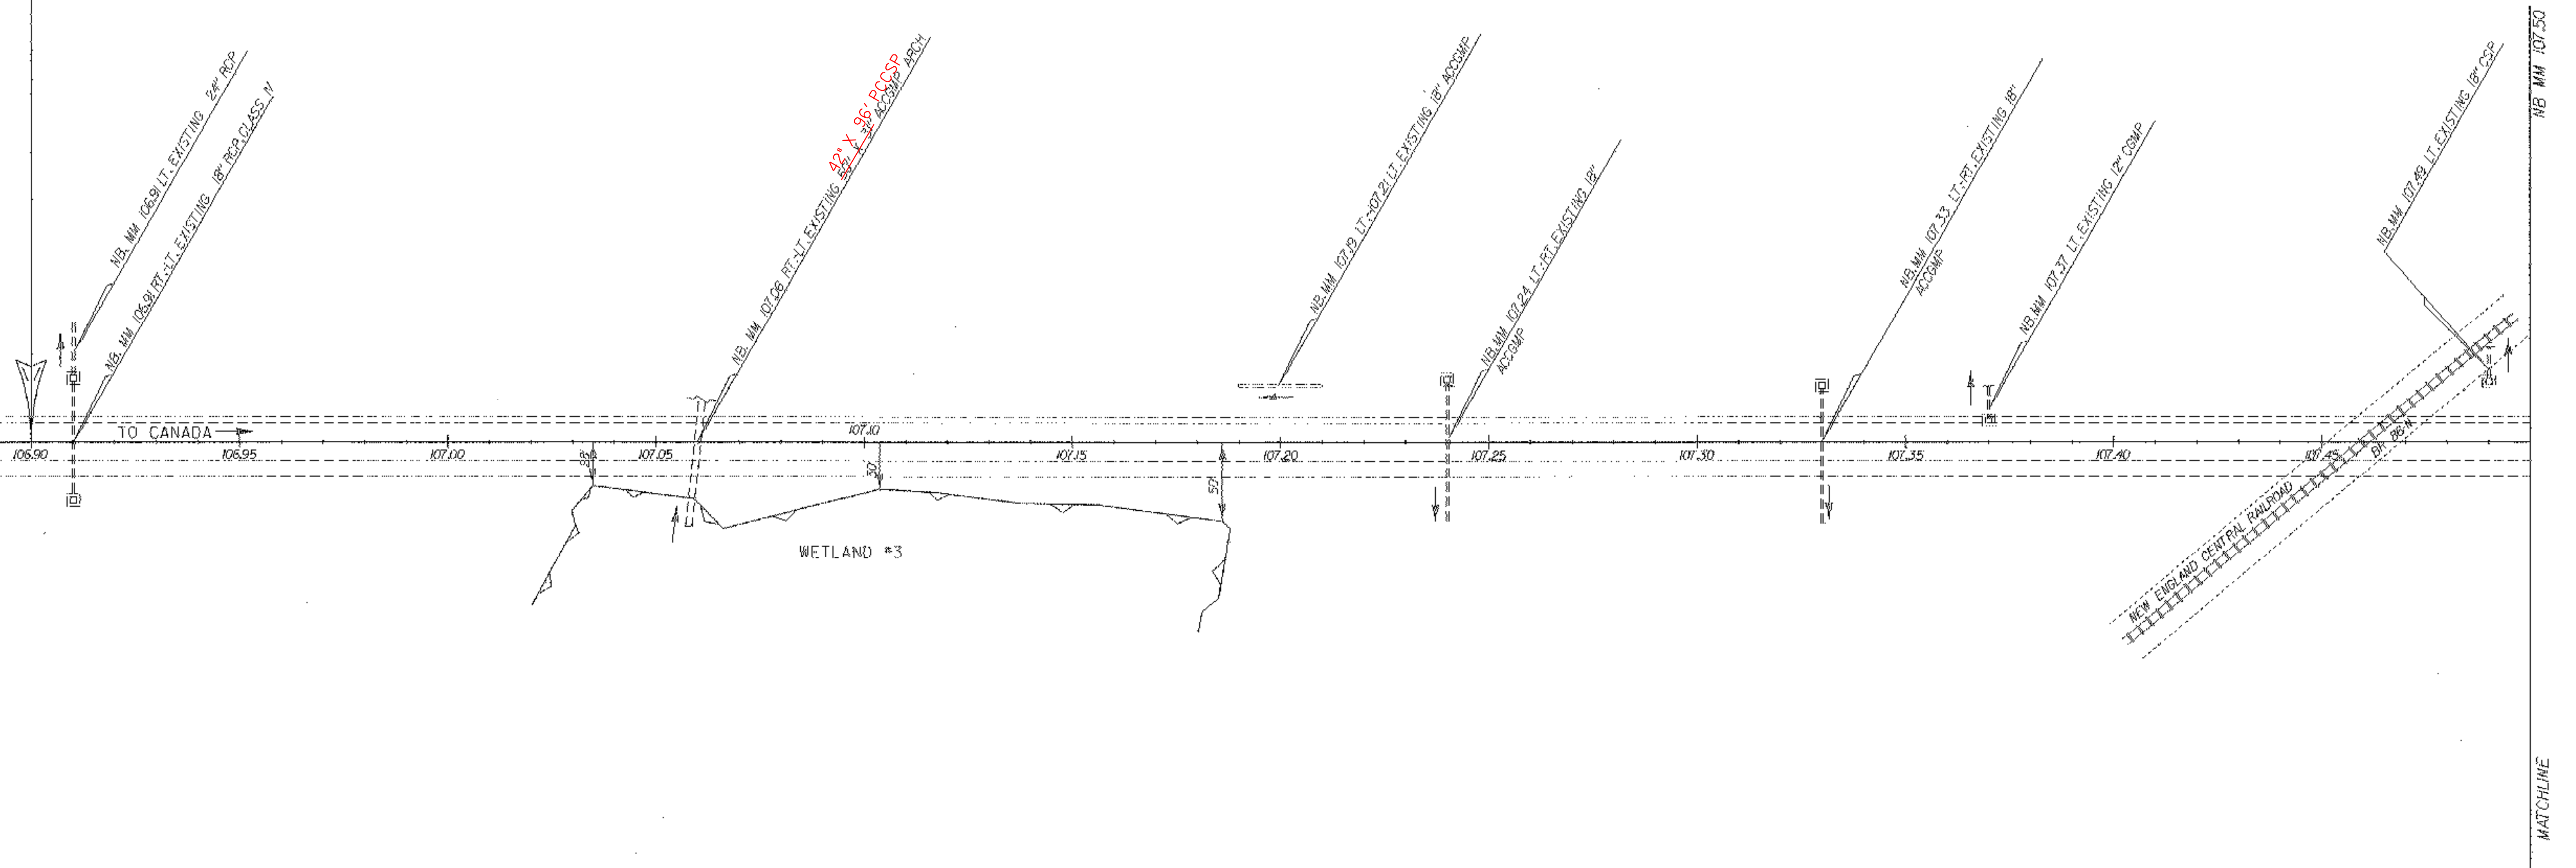

TO CANADA

WETLAND #3

NEW ENGLAND CENTRAL RAILROAD

MATCHLINE

DATUM	
VERTICAL	N/A
HORIZONTAL	N/A

NOT TO SCALE

NORTHBOUND MM 106.90 ~ 107.50	
SURVEYED BY	DATE
DRAWN BY	SQUAD B
SQUAD LEADER	DELLA SANTA
DESIGN FILE NO.	/SQDB/8TA007A/DA007A.DGN
IPARM FILE	DA007LO1
DATE PLOTTED	18-MAR-1997
PROJ. NAME	GEORGIA - FAIRFAX
PROJ. NO.	IM-089-3(26)
SHEET	47 OF 121 SHEETS