



- 8" UNDERDRAIN CARRIER PIPE (MODIFICATION #1)**
- 24 NB MM 108.99 RT.W/FB @ 108.99 RT.
 - 28 NB MM 109.25 RT.W/FB @ 109.25 RT.
 - 29 NB MM 109.25 RT.W/FB @ 109.25 RT.
 - 31 NB MM 108.99 LT.W/FB @ 108.99 LT.
 - 33 NB MM 109.06 LT.W/FB @ 109.06 LT.
 - 35 NB MM 109.20 LT.W/FB @ 109.20 LT.
 - 37 NB MM 109.25 LT.W/FB @ 109.25 LT.

- 8" UNDERDRAIN (MODIFICATION #1)**
- 19 NB MM 108.70 RT.~ MM 108.81 RT.W/FB @ 108.70 RT.
 - 20 NB MM 108.81 RT.~ MM 108.91 RT.W/FB @ 108.81 RT.
 - 21 NB MM 108.85 LT.~ MM 108.91 LT.W/FB @ 108.85 LT.
 - 22 NB MM 108.91 LT.~ MM 108.95 LT.W/FB @ 108.95 LT.
 - 23 NB MM 108.91 RT.~ MM 108.99 RT.W/FB @ 108.99 RT.
 - 25 NB MM 108.99 RT.~ MM 109.06 RT.W/FB @ 109.06 RT.
 - 26 NB MM 109.06 RT.~ MM 109.20 RT.W/FB @ 109.20 RT.
 - 27 NB MM 109.20 RT.~ MM 109.25 RT.W/FB @ 109.25 RT.
 - 30 NB MM 109.25 RT.~ MM 109.30 RT.W/FB @ 109.30 RT.
 - 32 NB MM 108.99 LT.~ MM 109.06 LT.W/FB @ 109.06 LT.
 - 34 NB MM 109.06 LT.~ MM 109.19 LT.W/FB @ 109.19 LT.
 - 36 NB MM 109.20 LT.~ MM 109.25 LT.W/FB @ 109.20 LT.
 - 38 NB MM 109.25 LT.~ MM 109.30 LT.W/FB @ 109.30 LT.

- STEEL BEAM GUARD RAIL**
- 108.81 RT BURIED
 - 108.96

- REMOVAL AND DISPOSAL OF GUARD RAIL**
- NB MM 108.70 LT.~ MM 108.72 LT.
 - NB MM 108.89 RT.~ MM 109.00 RT.
 - NB MM 108.93 LT.~ MM 109.00 LT.
 - NB MM 109.10 LT.~ MM 109.30 LT.
 - NB MM 109.13 RT.~ MM 109.20 RT.

ONE RUN
8" X 842' UND
MOD 1

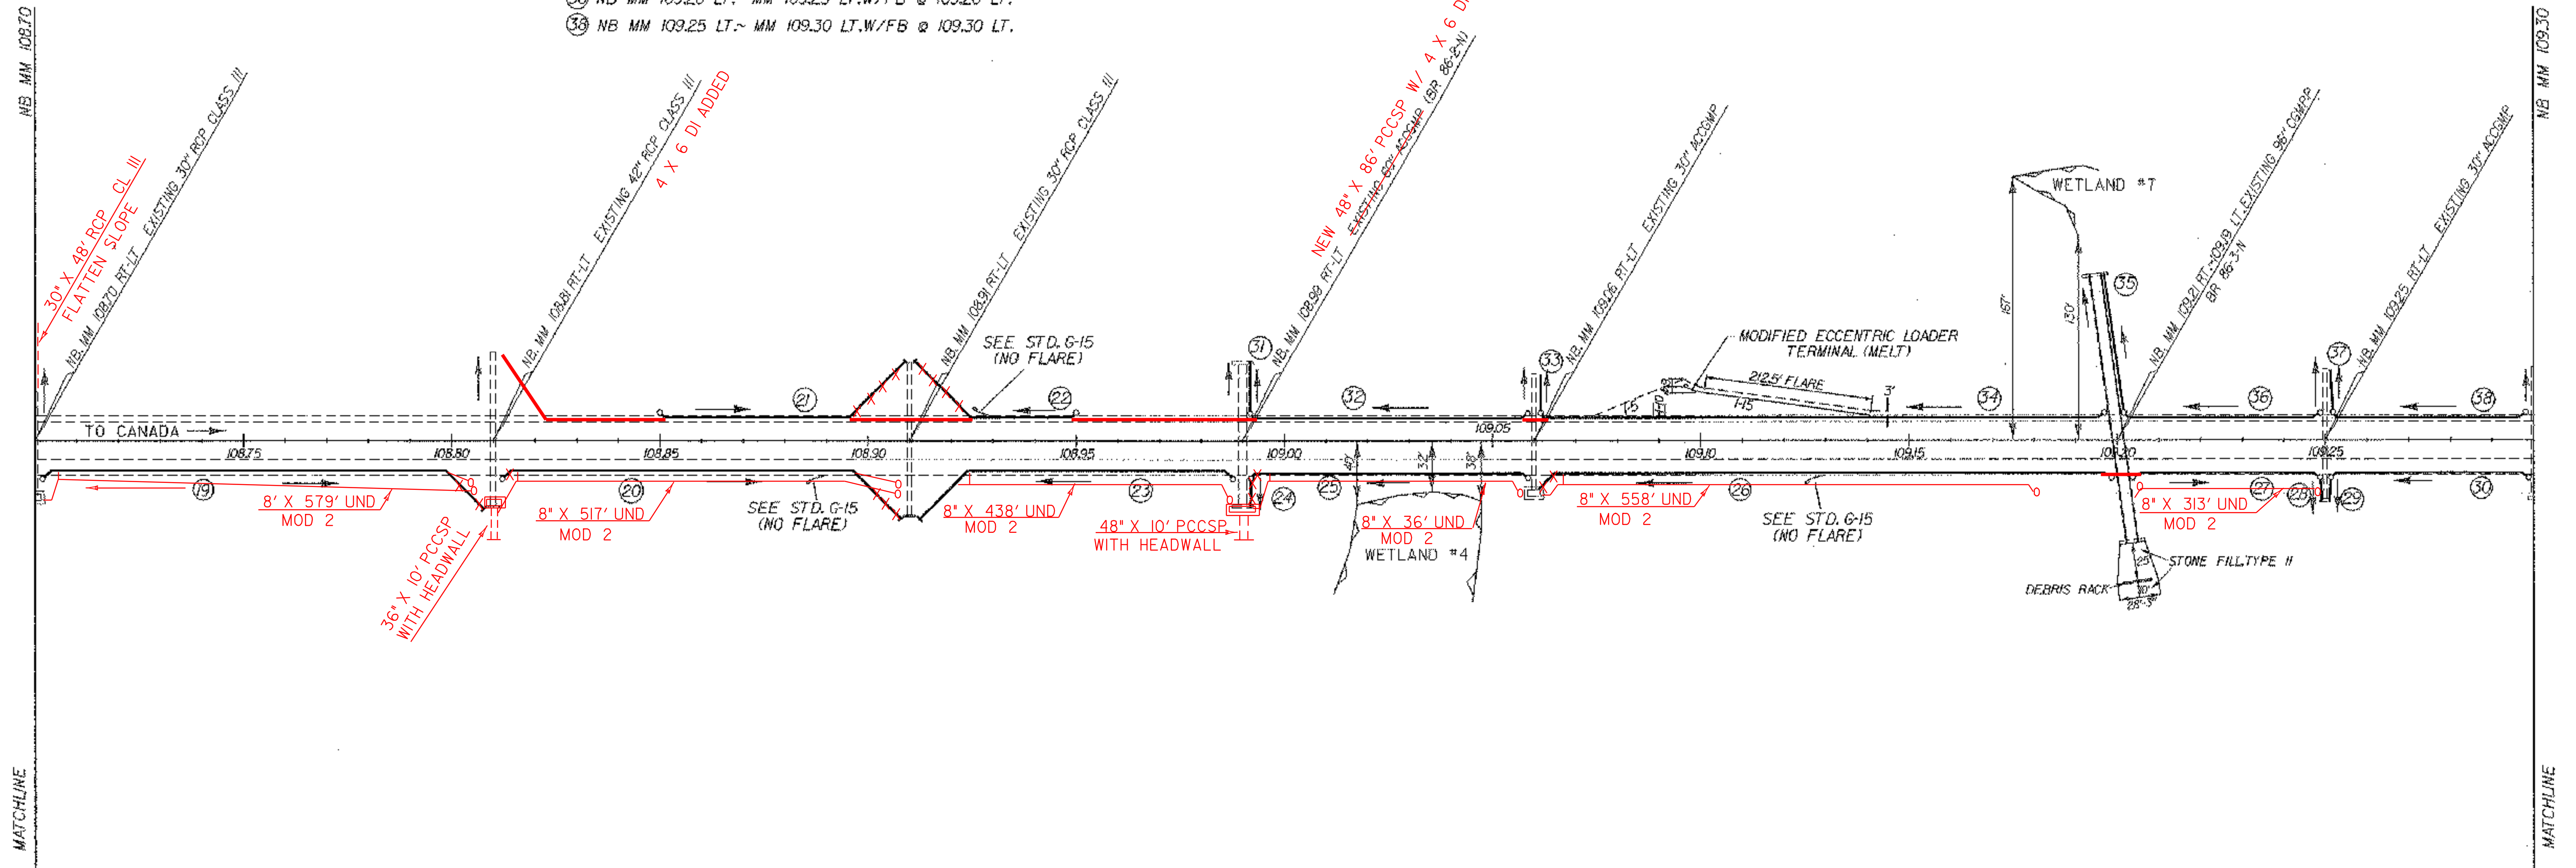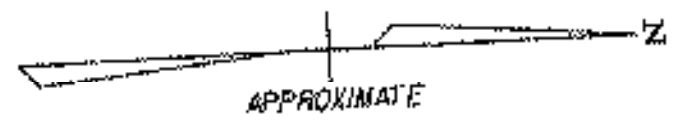

DATUM	
VERTICAL	N/A
HORIZONTAL	N/A

NOT TO SCALE

NORTHBOUND MM 108.70 ~ 109.30	
SURVEYED BY	DATE
DRAWN BY	DATE
SQUAD LEADER	BELLA SANTA
DESIGN FILE NO.	/S0DB/87A007A/DA007A.DGN
IFARM FILE	DA007L04
DATE PLOTTED	26-MAR-1997
PROJ. NAME	GEORGIA - FAIRFAX
PROJ. NO.	IM-089-3(26)
SHEET	50 OF 121 SHEETS