

8" UNDERDRAIN CARRIER PIPE (MODIFICATION #1)



- ③⑨ NB MM 109.30 RT.W/FB @ 109.30 RT.
- ④⑧ NB MM 109.30 LT.W/FB @ 109.30 LT.
- ⑤① NB MM 109.39 LT.W/FB @ 109.39 LT.
- ⑤② NB MM 109.47 LT.W/FB @ 109.47 LT.

8" UNDERDRAIN (MODIFICATION #1)

- ④⑩ NB MM 109.30 RT.~ MM 109.39 RT.W/FB @ 109.39 RT. BURIED
- ④① NB MM 109.39 RT.~ MM 109.47 RT.W/FB @ 109.47 RT. BURIED
- ④② NB MM 109.47 RT.~ MM 109.56 RT.W/FB @ 109.56 RT.
- ④③ NB MM 109.56 RT.~ MM 109.63 RT.W/FB @ 109.63 RT. BURIED
- ④④ NB MM 109.63 RT.~ MM 109.70 RT.W/FB @ 109.70 RT. BURIED
- ④⑤ NB MM 109.70 RT.~ MM 109.77 RT.W/FB @ 109.77 RT. BURIED
- ④⑥ NB MM 109.77 RT.~ MM 109.84 RT.W/FB @ 109.84 RT. BURIED
- ④⑦ NB MM 109.84 RT.~ MM 109.91 RT.W/FB @ 109.91 RT. BURIED
- ④⑨ NB MM 109.30 LT.~ MM 109.39 LT.W/FB @ 109.39 LT.
- ⑤③ NB MM 109.39 LT.~ MM 109.47 LT.W/FB @ 109.47 LT.
- ⑤④ NB MM 109.47 LT.~ MM 109.50 LT.W/FB @ 109.50 LT.

STEEL BEAM GUARD RAIL
NB MM 109.30 LT.~ MM 109.33 LT.
109.60

REMOVAL AND DISPOSAL
OF GUARD RAIL
NB MM 109.30 LT.~ MM 109.55 LT.
NB MM 109.74 LT.~ MM 109.90 LT.

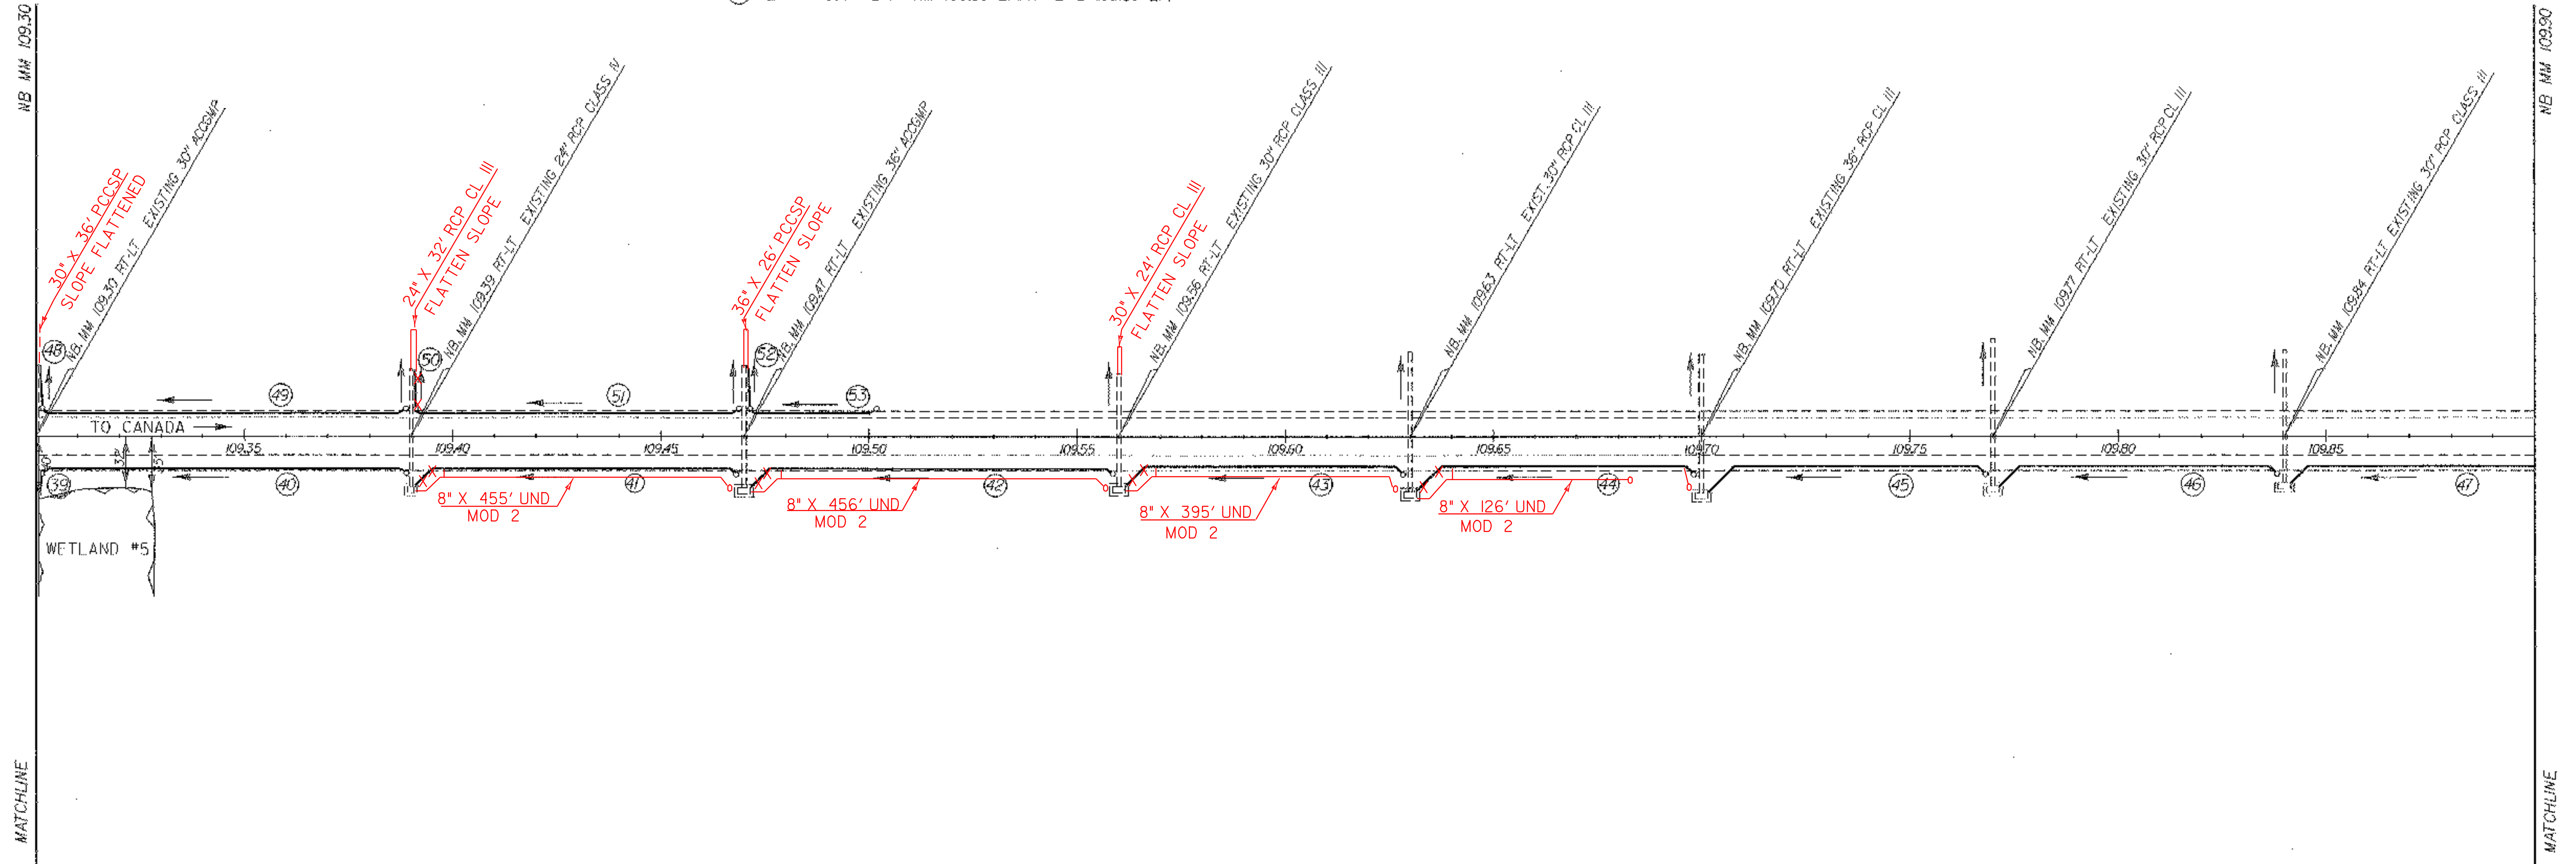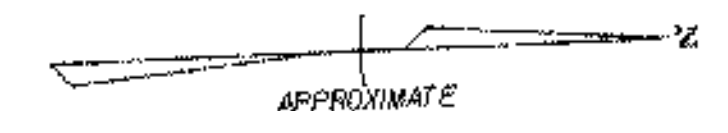

ONE RUN

DATUM	
VERTICAL	N/A
HORIZONTAL	N/A

NOT TO SCALE

NORTHBOUND	
MM 109.30 ~ 109.90	
SURVEYED BY	DATE
DRAWN BY	DATE
SQUAD LEADER	DATE
DESIGN FILE NO. /SODB/87A007A/DA007A.DGN	
IPARM FILE	DATE
DA007L05	26-MAR-1997
PROJ. NAME	GEORGIA - FAIRFAX
PROJ. NO.	IM-089-3(26)
SHEET	51 OF 121 SHEETS