


STEEL BEAM GUARD RAIL
 SB MM 107.54 LT. ~ MM 107.79 LT. 69
 SB MM 107.54 RT. ~ MM 107.57 RT.
 SB MM 108.09 LT. ~ MM 108.10 LT.

GUARD RAIL APPROACH SECTION, TYPE 1
 SB MM 107.53 LT. ~ MM 107.54 LT.
 SB MM 107.53 RT. ~ MM 107.54 RT.

REMOVAL AND DISPOSAL
 OF GUARD RAIL
 SB MM 107.53 LT. ~ MM 107.70 LT.
 SB MM 107.53 RT. ~ MM 107.57 RT.
 SB MM 108.09 LT. ~ MM 108.10 LT.

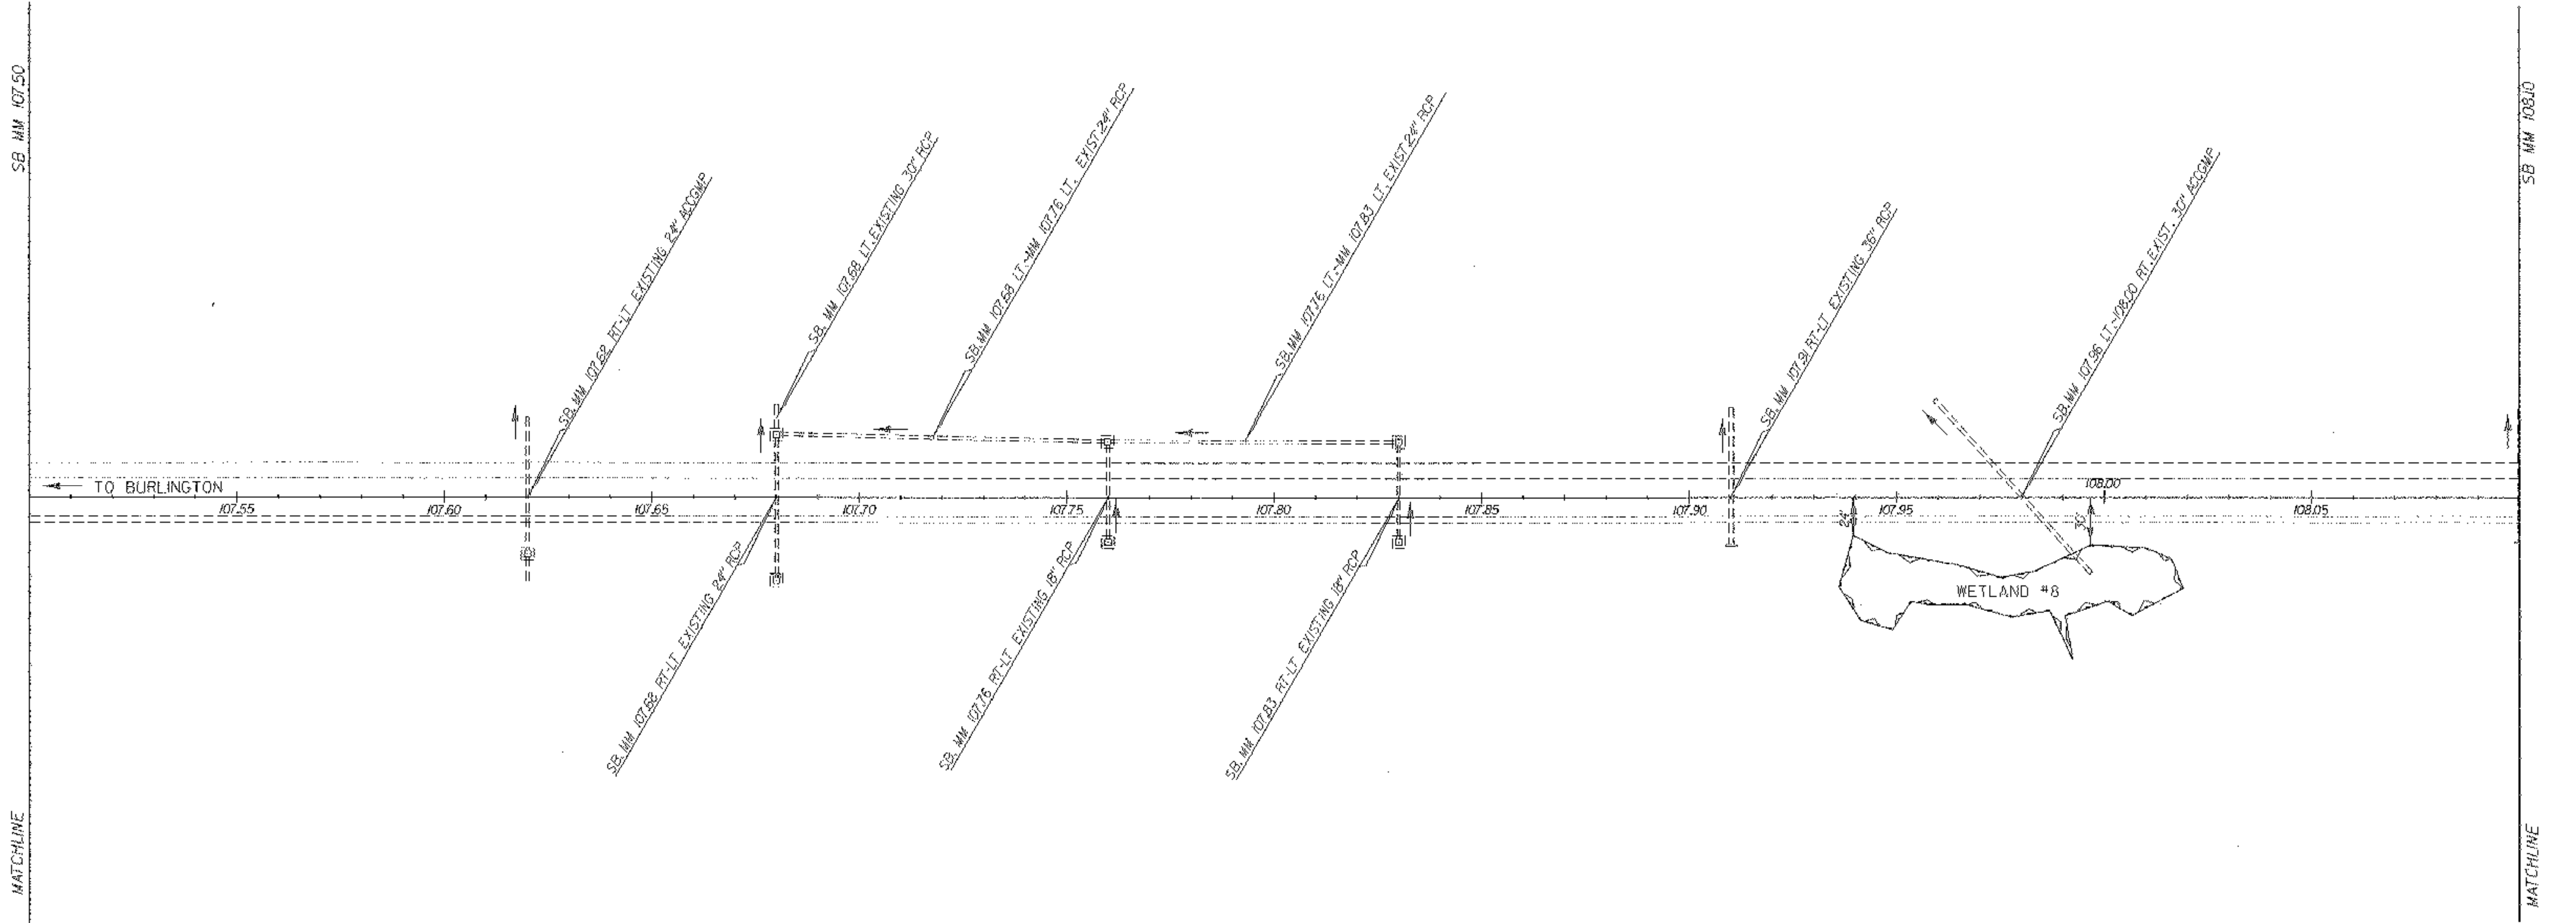

DATUM	
VERTICAL	N/A
HORIZONTAL	N/A

NOT TO SCALE

SOUTHBOUND	
MM 107.50 ~ 108.10	
SURVEYED BY:	DATE
DRAWN BY SQUAD B	DATE
SQUAD LEADER DELLA SANTA	
DESIGN FILE NO. /SODB/87A007A/DA007A.DGN	
IPARM FILE DA007L09	DATE PLOTTED 18-MAR-1997
PROJ. NAME	GEORGIA - FAIRFAX
PROJ. NO.	IM-089-3(26)
SHEET 71 OF 121	SHEETS