


STEEL BEAM GUARD RAIL
 SB MM 108.10 LT. ~ MM 108.61 LT. .57
 SB MM 108.47 RT. ~ MM 108.52 RT. .30

REMOVAL AND DISPOSAL
 OF GUARD RAIL
 SB MM 108.10 LT. ~ MM 108.61 LT.
 SB MM 108.47 RT. ~ MM 108.52 RT.

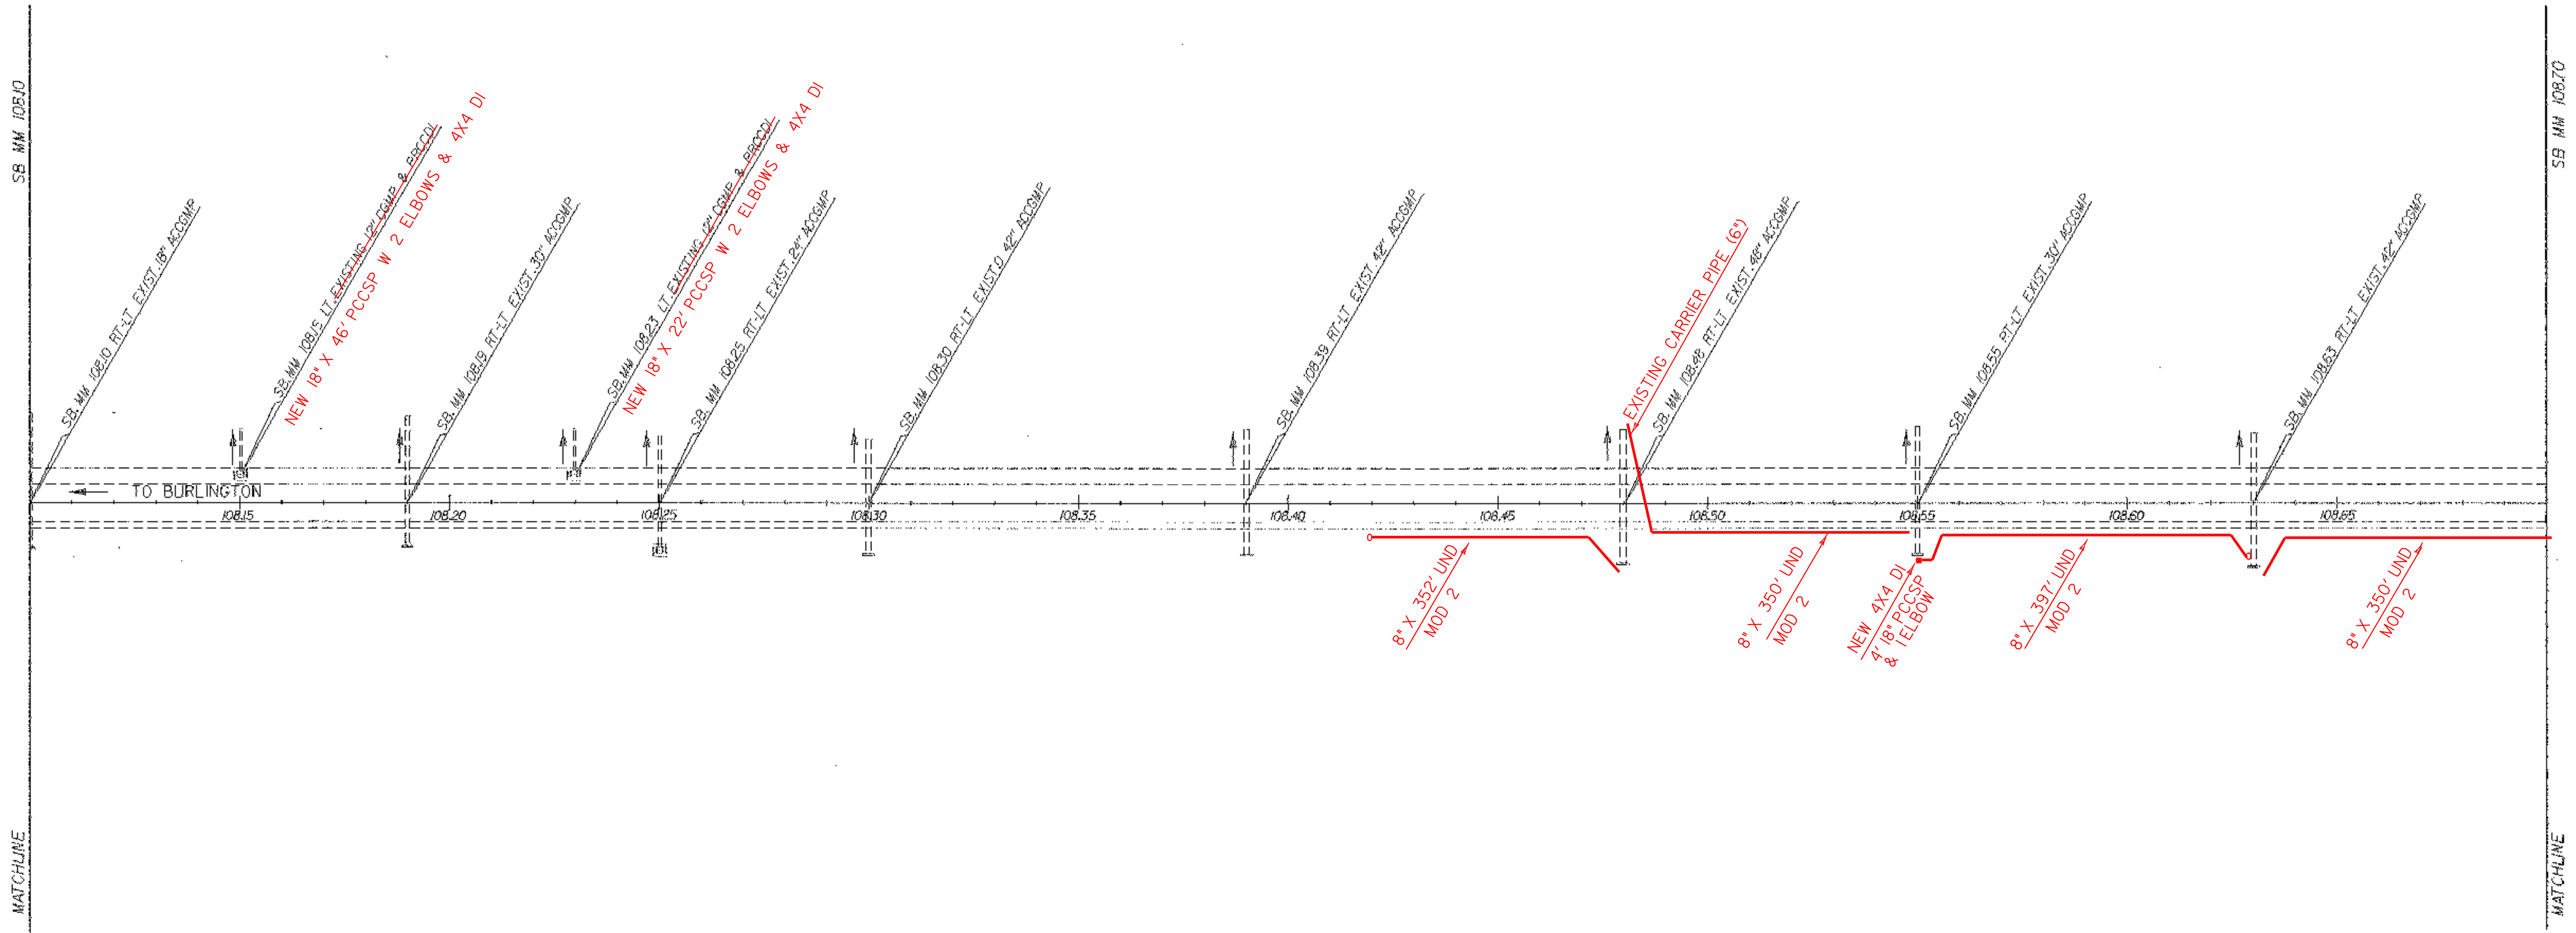

SB MM 108.10

SB MM 108.70

MATCHLINE

MATCHLINE

TO BURLINGTON

DATUM	
VERTICAL	N/A
HORIZONTAL	N/A

SOUTHBOUND	
MM 108.10 ~ 108.70	
SURVEYED BY	DATE
DRAWN BY SQUAD B	DATE
SQUAD LEADER DELLA SANTA	
DESIGN FILE NO. /SQDB/87A007A/DA007A.DGN	
IPARM FILE DA007L10	DATE PLOTTED 18-MAR-1997
PROJ. NAME	GEORGIA - FAIRFAX
PROJ. NO.	IM-089-3(26)
SHEET 72 OF 121	SHEETS

NOT TO SCALE