
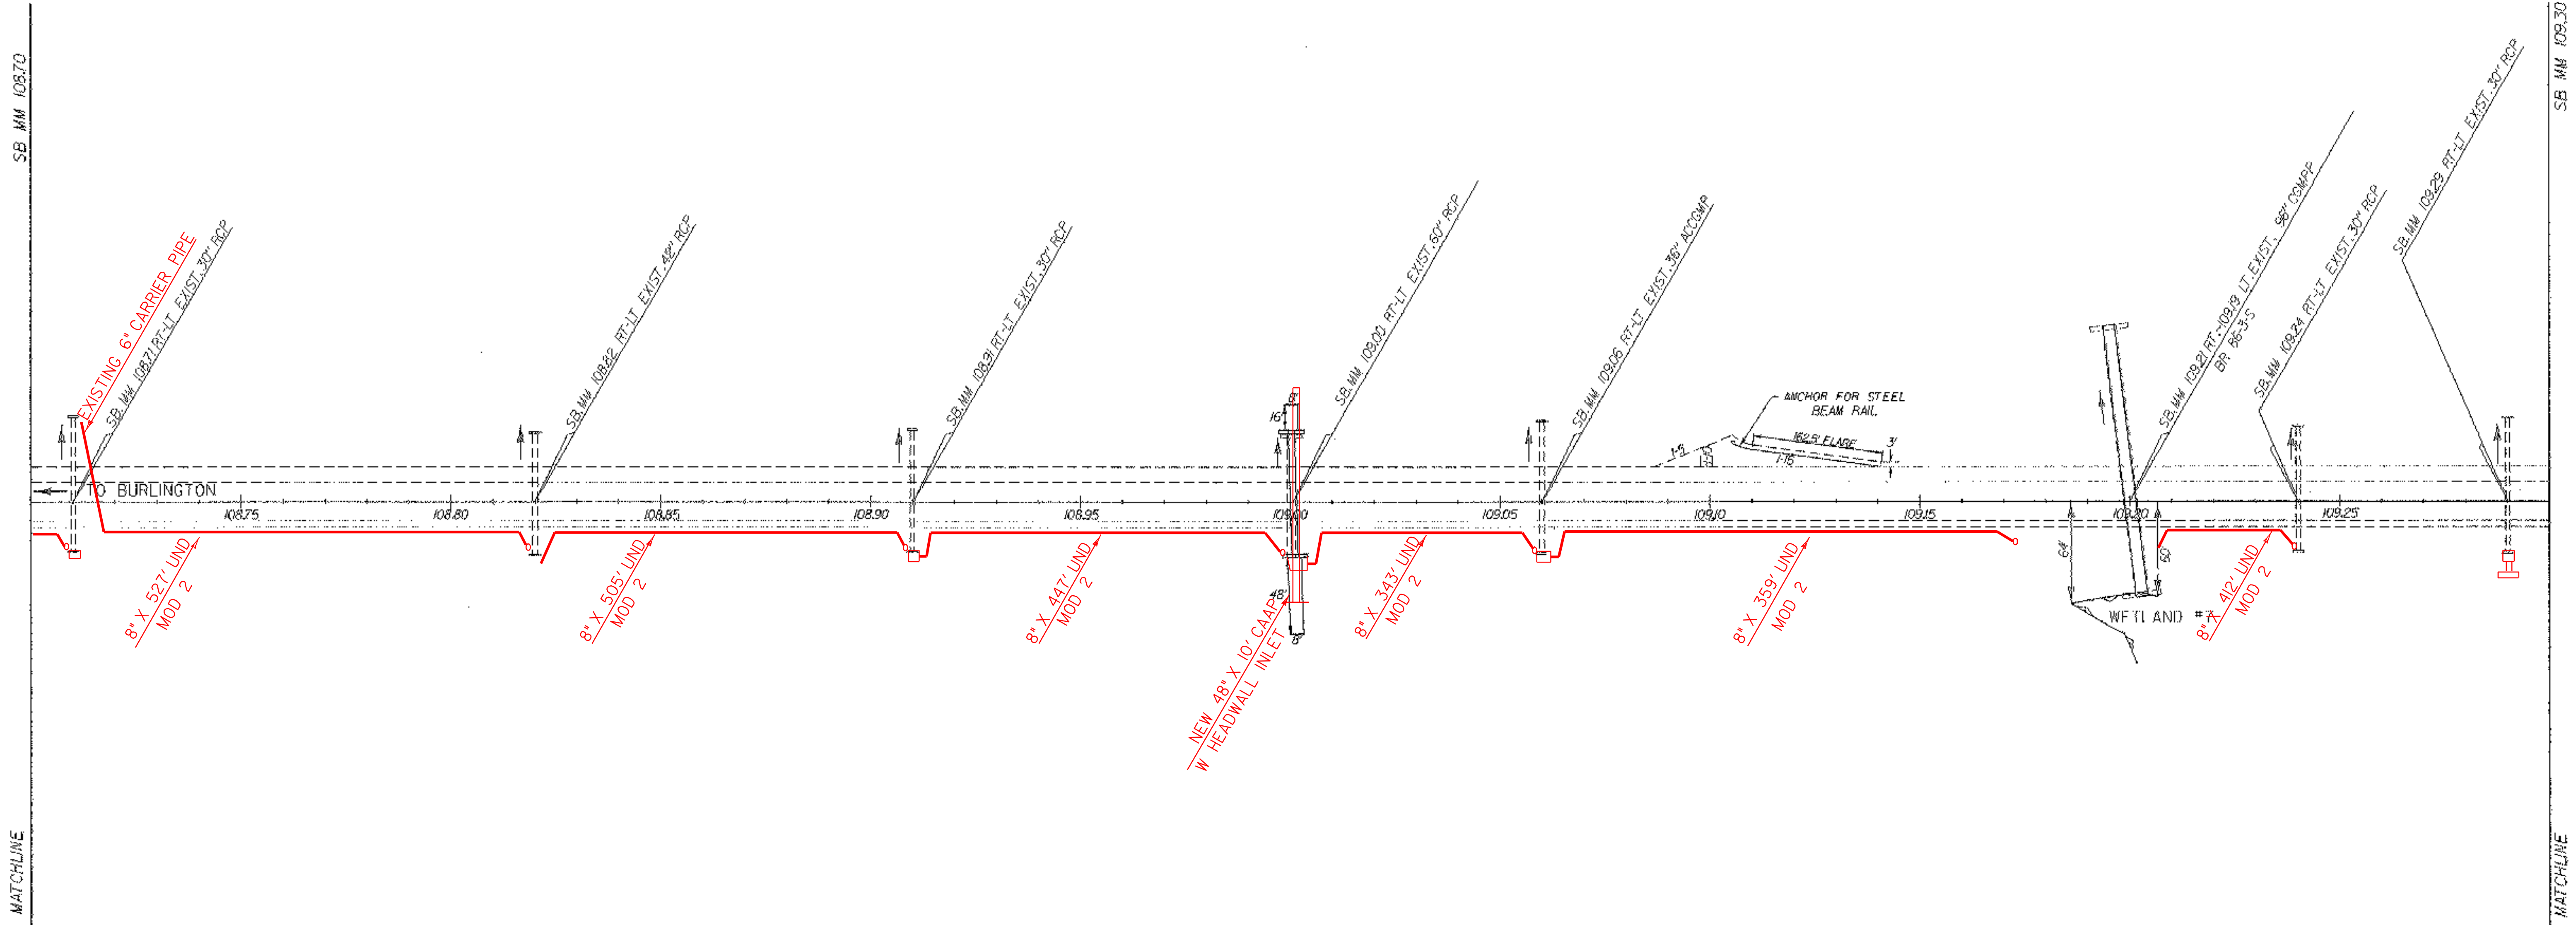


STEEL BEAM GUARD RAIL
 SB MM 108.99 LT. ~ MM 109.02 LT.
 SB MM 108.99 RT. ~ MM 109.03 RT.
 SB MM 109.11 LT. ~ MM 109.30 LT.
 SB MM 109.12 RT. ~ MM 109.20 RT.
 .15

REMOVAL AND DISPOSAL
 OF GUARD RAIL
 SB MM 108.99 LT. ~ MM 109.02 LT.
 SB MM 108.99 RT. ~ MM 109.03 RT.
 SB MM 109.11 LT. ~ MM 109.30 LT.
 SB MM 109.12 RT. ~ MM 109.20 RT.

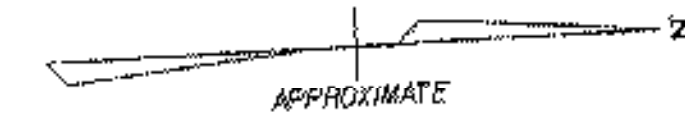

SB MM 108.70

SB MM 109.30

MATCHLINE

MATCHLINE

DATUM	
VERTICAL	N/A
HORIZONTAL	N/A

SOUTHBOUND	
MM 108.70 ~ 109.30	
SURVEYED BY	DATE
DRAWN BY	SQUAD B
SQUAD LEADER	DELLA SANTA
DESIGN FILE NO.	/SQDB/87A007A/DA007A.DGN
IPARM FILE	DA007LII
DATE PLOTTED	26-MAR-1997
PROJ. NAME	GEORGIA - FAIRFAX
PROJ. NO.	IM-089-3(26)
SHEET 73 OF 121	SHEETS

NOT TO SCALE