

8" UNDERDRAIN (MODIFICATION #1)


- ④ SB MM 109.89 RT. ~ MM 109.97 RT. W/FB @ 109.97 RT.
- ⑤ SB MM 109.97 RT. ~ MM 110.04 RT. W/FB @ 110.04 RT.
- ⑥ SB MM 110.04 RT. ~ MM 110.13 RT. W/FB @ 110.13 RT.
- ⑦ SB MM 110.13 RT. ~ MM 110.28 RT. W/FB @ 110.28 RT.
- ⑧ SB MM 110.28 RT. ~ MM 110.36 RT. W/FB @ 110.36 RT.
- ⑨ SB MM 110.36 RT. ~ MM 110.45 RT. W/FB @ 110.45 RT.
- ⑩ SB MM 110.45 RT. ~ MM 110.54 RT. W/FB @ 110.54 RT.

STEEL BEAM GUARD RAIL

- SB MM 109.90 LT. ~ MM 110.18 LT. .16
- SB MM 110.27 RT. ~ MM 110.32 RT. .31
- .12

REMOVAL AND DISPOSAL OF GUARD RAIL

- SB MM 109.90 LT. ~ MM 110.18 LT.
- SB MM 110.27 LT. ~ MM 110.32 LT.
- SB MM 110.27 RT. ~ MM 110.32 RT.

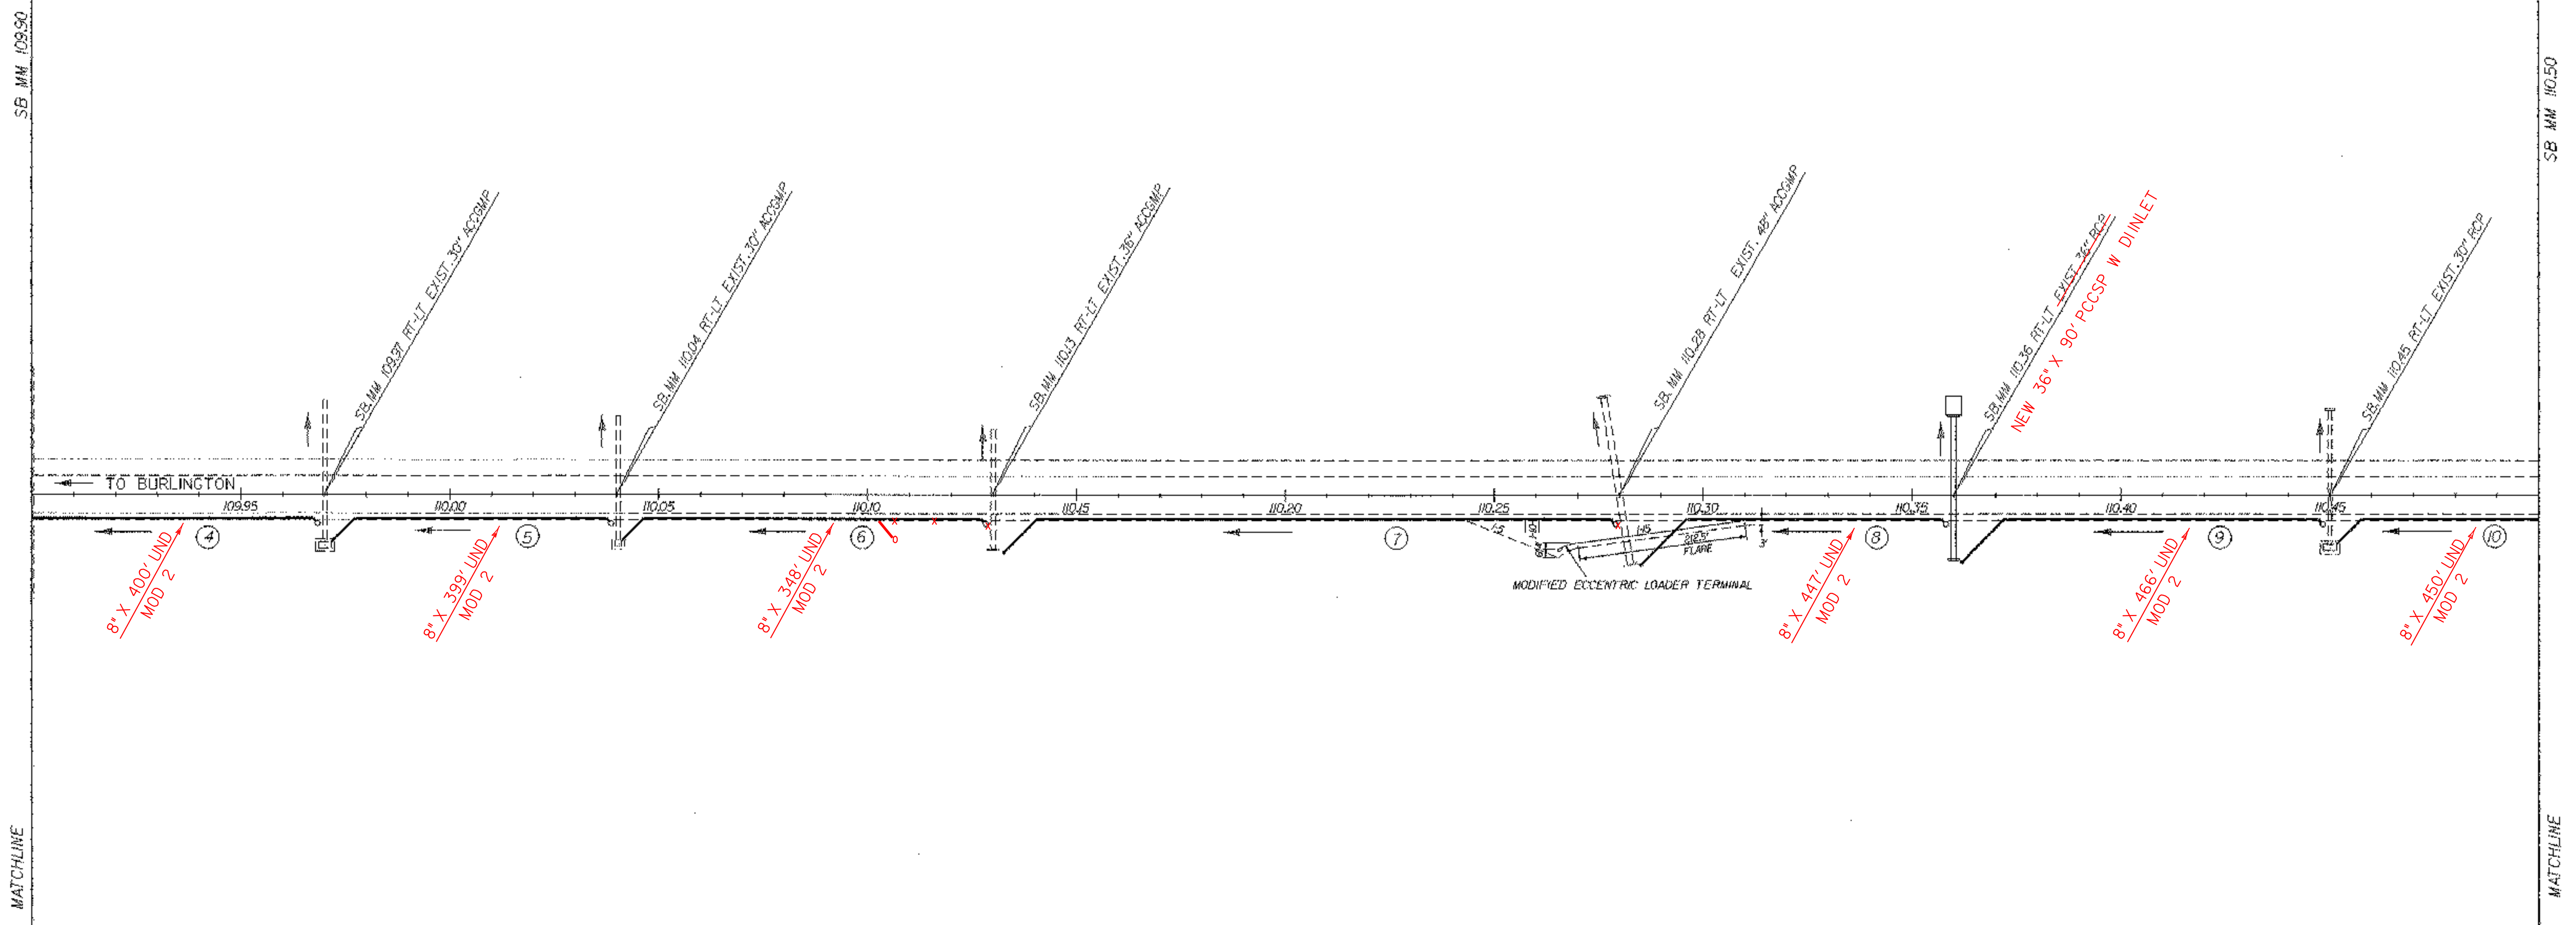

DATUM	
VERTICAL	N/A
HORIZONTAL	N/A

NOT TO SCALE

SOUTHBOUND	
MM 109.90 ~ 110.50	
SURVEYED BY	DATE
DRAWN BY	SQUAD B
SQUAD LEADER	DELLA SANTA
DESIGN FILE NO.	/SODB/87A007A/DA007A.DGN
IPARM FILE	DAQ07L13
DATE PLOTTED	26-MAR-1997
PROJ. NAME	GEORGIA - FAIRFAX
PROJ. NO.	IM-089-3(26)
SHEET 75	OF 121 SHEETS