
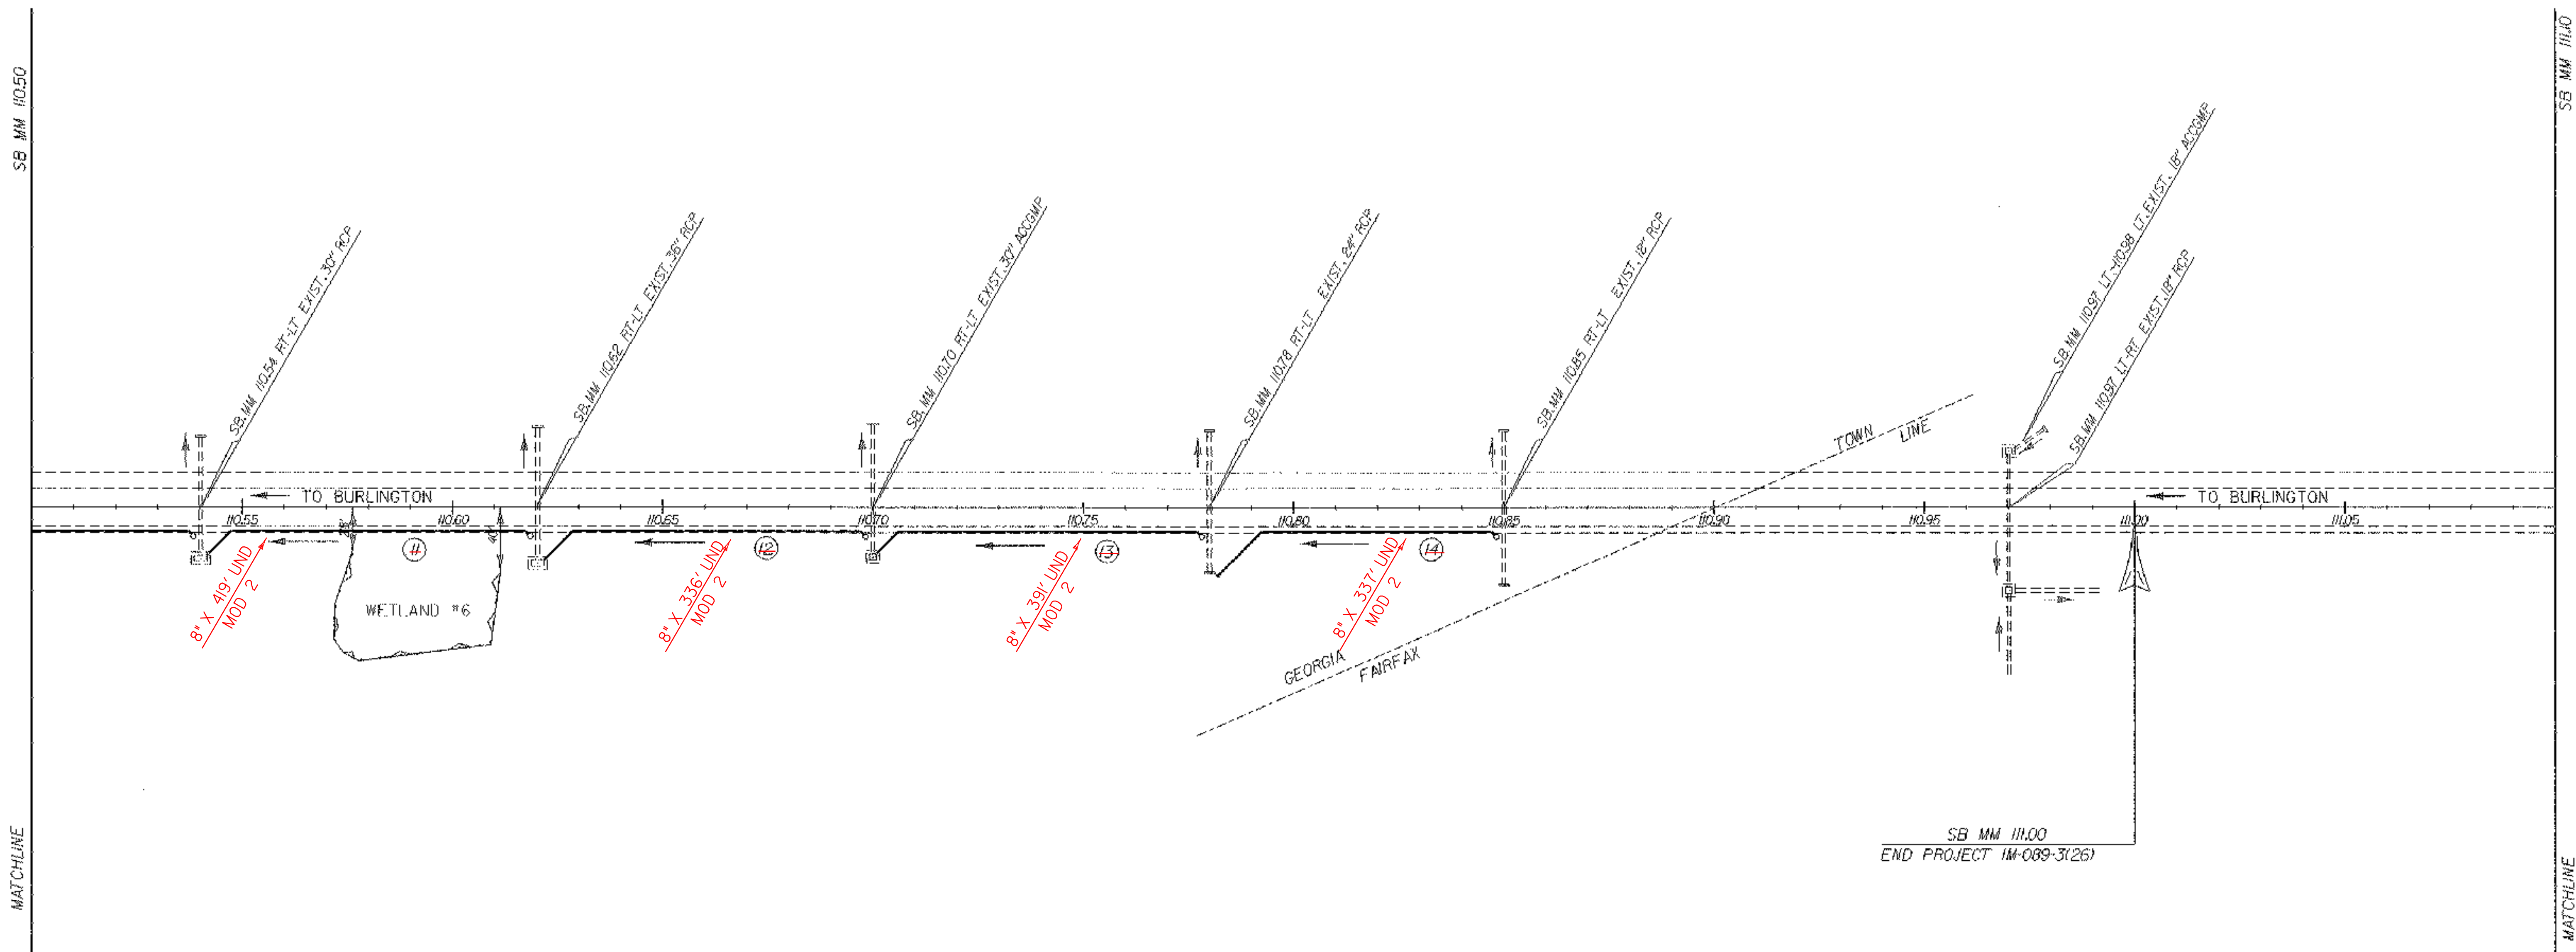


8" UNDERDRAIN (MODIFICATION #1)

- ① SB MM 110.54 RT. ~ MM 110.62 RT.W/FB @ 110.62 RT.
- ② SB MM 110.62 RT. ~ MM 110.70 RT.W/FB @ 110.70 RT.
- ③ SB MM 110.70 RT. ~ MM 110.78 RT.W/FB @ 110.78 RT.
- ④ SB MM 110.78 RT. ~ MM 110.85 RT.W/FB @ 110.85 RT.

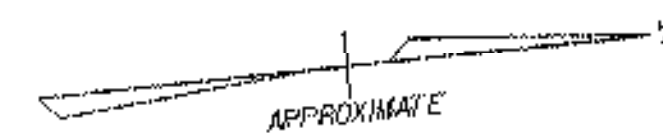

SB MM 111.00  
END PROJECT IM-089-3(26)

DATUM	
VERTICAL	N/A
HORIZONTAL	N/A

NOT TO SCALE

SOUTHBOUND MM 110.50 ~ 111.10	
SURVEYED BY	DATE
DRAWN BY SQUAD B	DATE
SQUAD LEADER DELLA SANTA	
DESIGN FILE NO. /S0DB/B7A007A/DA007A.DGN	
IPARM FILE DA007L14	DATE PLOTTED 26-MAR-1997
PROJ. NAME GEORGIA - FAIRFAX	
PROJ. NO. IM-089-3(26)	
SHEET 76 OF 121 SHEETS	