


**BRIDGE COLD PLANE DETAIL**

<u>BRIDGE #6-S LOCATION</u>	<u>BRIDGE #11-S LOCATION</u>
MM 1.05	MM 6.81


JOINT	LENGTH
1	51' - 0"
4	46' - 0"

BRIDGE #6-S  
TOTAL LENGTH OF JOINT

NOTE: JOINTS #2 AND #3 ARE FINGER PLATE JOINTS AND DO NOT REQUIRE ASPHALTIC PLUGS

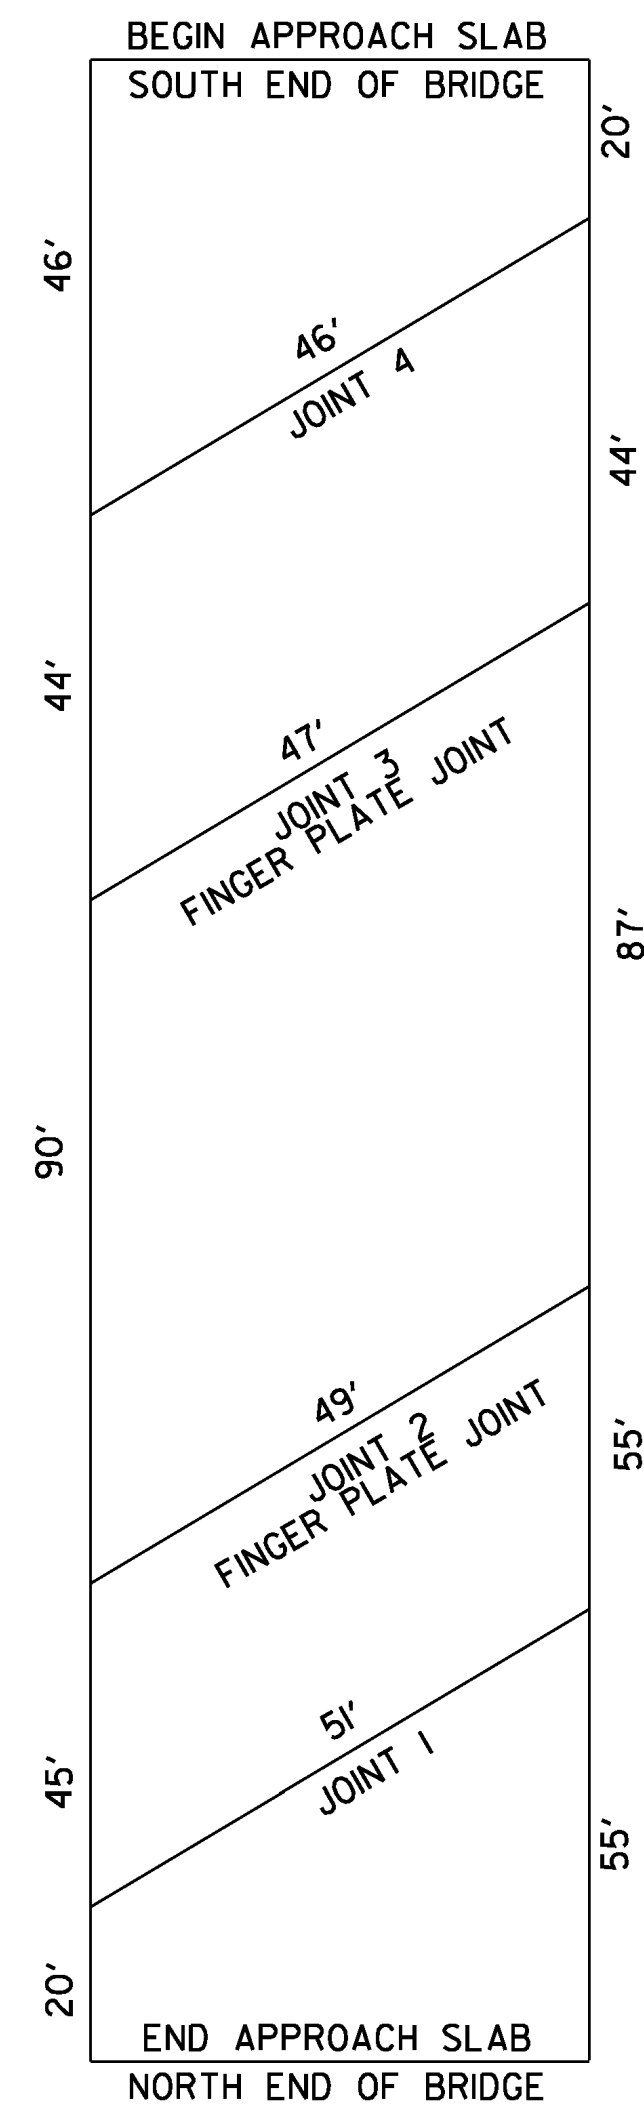

**BRIDGE #6-S**  
**MM 1.05**  
**COLD PLANE AND PAVE**

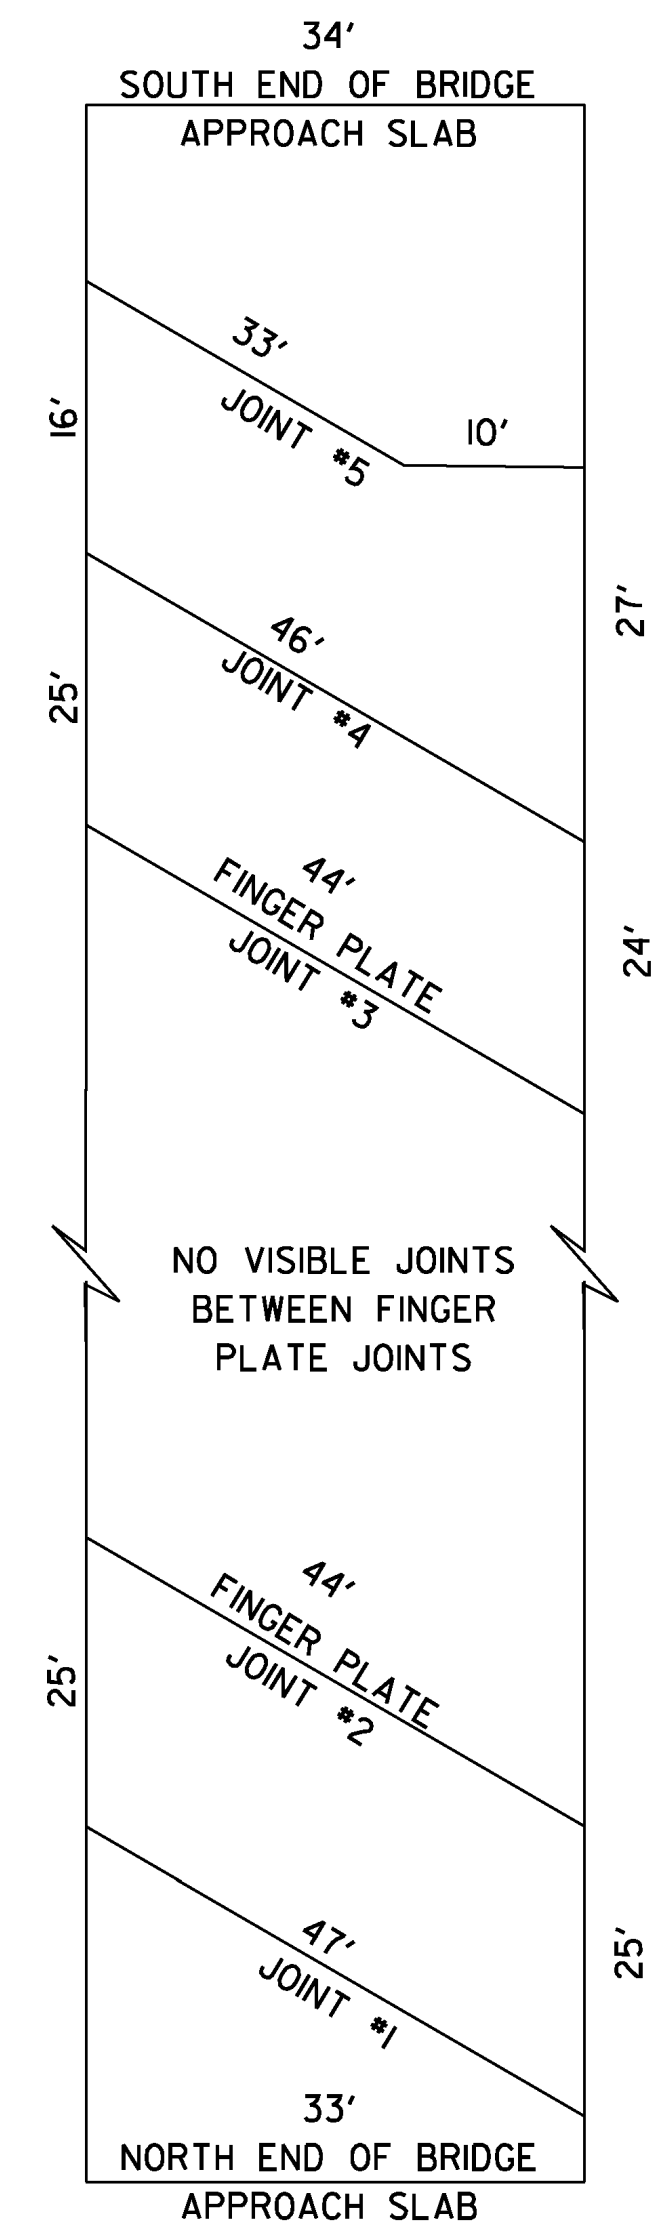

BRIDGE #11-S  
NOTE: NO JOINTS WORK REQUIRED.

**BRIDGE #11-S**  
**MM 6.81**  
**COLD PLANE AND PAVE**

SEE DETAIL TYPICAL SECTION FOR PAVEMENT THICKNESSES.

1 1/4" COLD PLANE DEPTH.  
PAVE WITH 1 1/4" SUPERPAVE BITUMINOUS CONCRETE PAVEMENT, TYPE IVS

SEE DETAIL TYPICAL SECTION FOR PAVEMENT THICKNESS

**NOTES:**

- REFER TO SHEET 6 FOR ASPHALTIC PLUG JOINT AND DETAILS. ALL NEW JOINTS TO BE PAID FOR UNDER ITEM 516.10, BRIDGE EXPANSION JOINT, ASPHALTIC PLUG.
- THE CONTRACTOR SHALL TAKE PRECAUTIONS TO AVOID THE ACCUMULATION OF DEBRIS IN THE DRAINAGE STRUCTURES LOCATED AT CURB LINE AND IN THE EXPANSION JOINTS. THE CONTRACTOR SHALL EXAMINE THESE BRIDGE FEATURES ON A REGULAR BASIS TO ENSURE THAT DEBRIS HAS NOT ACCUMULATED. ANY DEBRIS WHICH IS PRESENT SHALL BE REMOVED BY THE CONTRACTOR AT NO COST TO THE STATE.
- THE CONTRACTOR SHALL PERFORM COLD PLANING WITH CAUTION AT THESE LOCATIONS. ANY DAMAGE WHICH OCCURS TO BRIDGE DECK MEMBRANES AS A RESULT OF COLD PLANE OPERATIONS SHALL BE THE RESPONSIBILITY OF THE CONTRACTOR AND THE MEMBRANE WILL BE REPAIRED OR REPLACED AT NO COST TO THE STATE.

**DETAILS ARE NOT TO SCALE**

**BRIDGE LOCATION AND DETAIL SHEET**

PROJECT NAME: HARTFORD - SHARON  
PROJECT NUMBER: IM 089-1(57)

FILE NAME: 97A184.dgn	PLOT DATE: 8/6/2010
PROJECT LEADER: CDL	DRAWN BY: JDM
DESIGNED BY: JDM	CHECKED BY: EPD
PLOT FILE: 97A184.J2.1	SHEET 12 OF 62