

**646.426 DURABLE 6 INCH WHITE LINE, RECESSED POLYUREA**

MAINLINE DOTTED MM 0.886 - MM 0.792  
 MAINLINE SOLID MM 0.886 - MM 0.775  
 RAMP C STA. 305+90.00 - STA. 308+50.00  
 RAMP F STA. 514+85.00 - STA. 516+75.00  
 MAINLINE DOTTED MM 0.589 - MM 0.473  
 MAINLINE SOLID MM 0.589 - MM 0.473

**646.436 DURABLE 6 INCH YELLOW LINE, RECESSED POLYUREA**

RAMP C STA. 308+00.00 - STA. 308+50.00  
 RAMP F STA. 514+85.00 - STA. 515+35.00

**646.466 DURABLE 12 INCH WHITE LINE, RECESSED POLYUREA**

MAINLINE MM 0.792 - MM 0.730  
 MAINLINE GORE MARKINGS MM 0.760 - MM 0.730  
 RAMP C STA. 305+90.00 - STA 308+25.00  
 MAINLINE MM 0.617 - MM 0.589  
 RAMP F STA. 515+35.00 - 515+85.00

**646.622 TEMPORARY 6 INCH WHITE LINE, PAINT**


MAINLINE DOTTED MM 0.886 - MM 0.792  
 MAINLINE SOLID MM 0.886 - MM 0.775  
 RAMP C STA. 305+90.00 - STA. 308+50.00  
 RAMP F STA. 514+85.00 - STA. 516+75.00  
 MAINLINE DOTTED MM 0.589 - MM 0.473  
 MAINLINE SOLID MM 0.589 - MM 0.473

**646.632 TEMPORARY 6 INCH YELLOW LINE, PAINT**

RAMP C STA. 308+00.00 - STA. 308+50.00  
 RAMP F STA. 514+85.00 - STA. 515+35.00

**646.662 TEMPORARY 12 INCH WHITE LINE, PAINT**


MAINLINE MM 0.792 - MM 0.730  
 MAINLINE GORE MARKINGS MM 0.760 - MM 0.730  
 RAMP C STA. 305+90.00 - STA 308+25.00  
 MAINLINE MM 0.617 - MM 0.589  
 RAMP F STA. 515+35.00 - 515+85.00

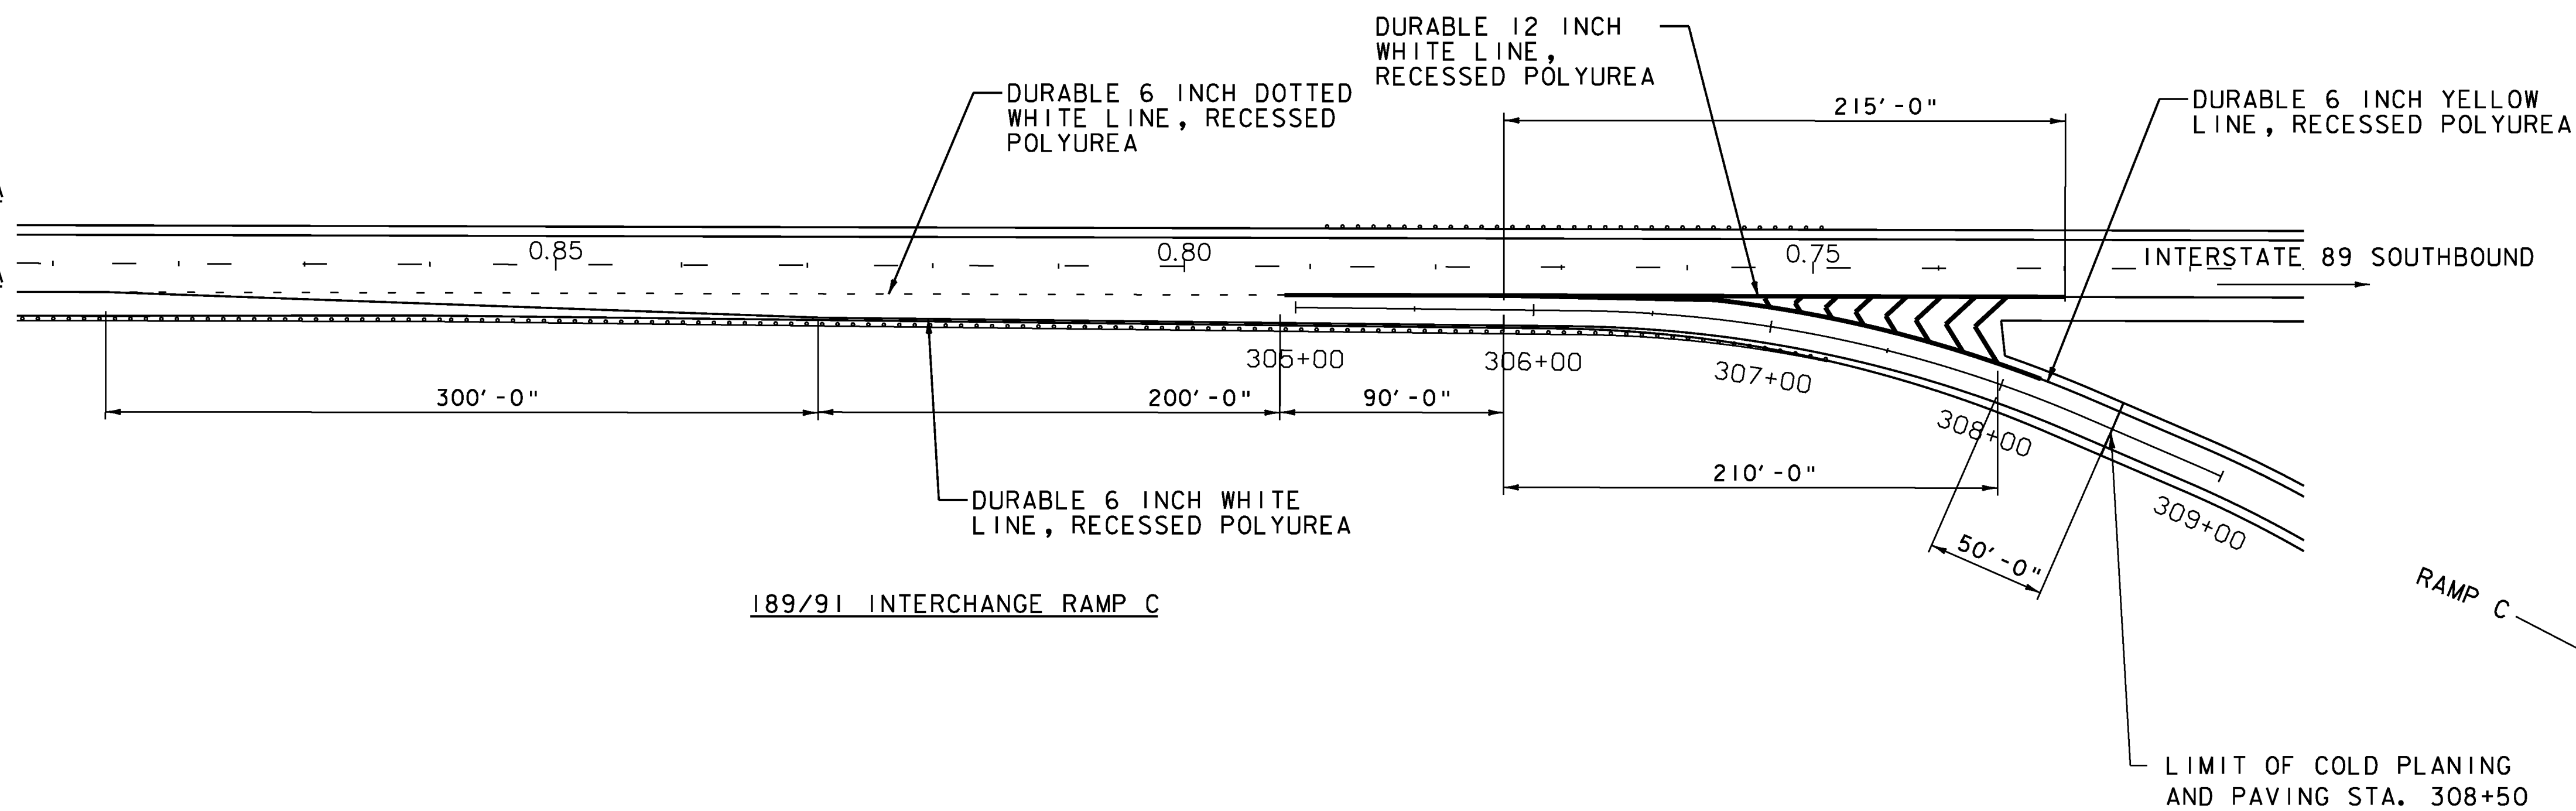

DURABLE 6 INCH YELLOW LINE, RECESSED POLYUREA

LIMIT OF COLD PLANING AND PAVING STA. 514+85

DURABLE 12 INCH WHITE LINE, RECESSED POLYUREA

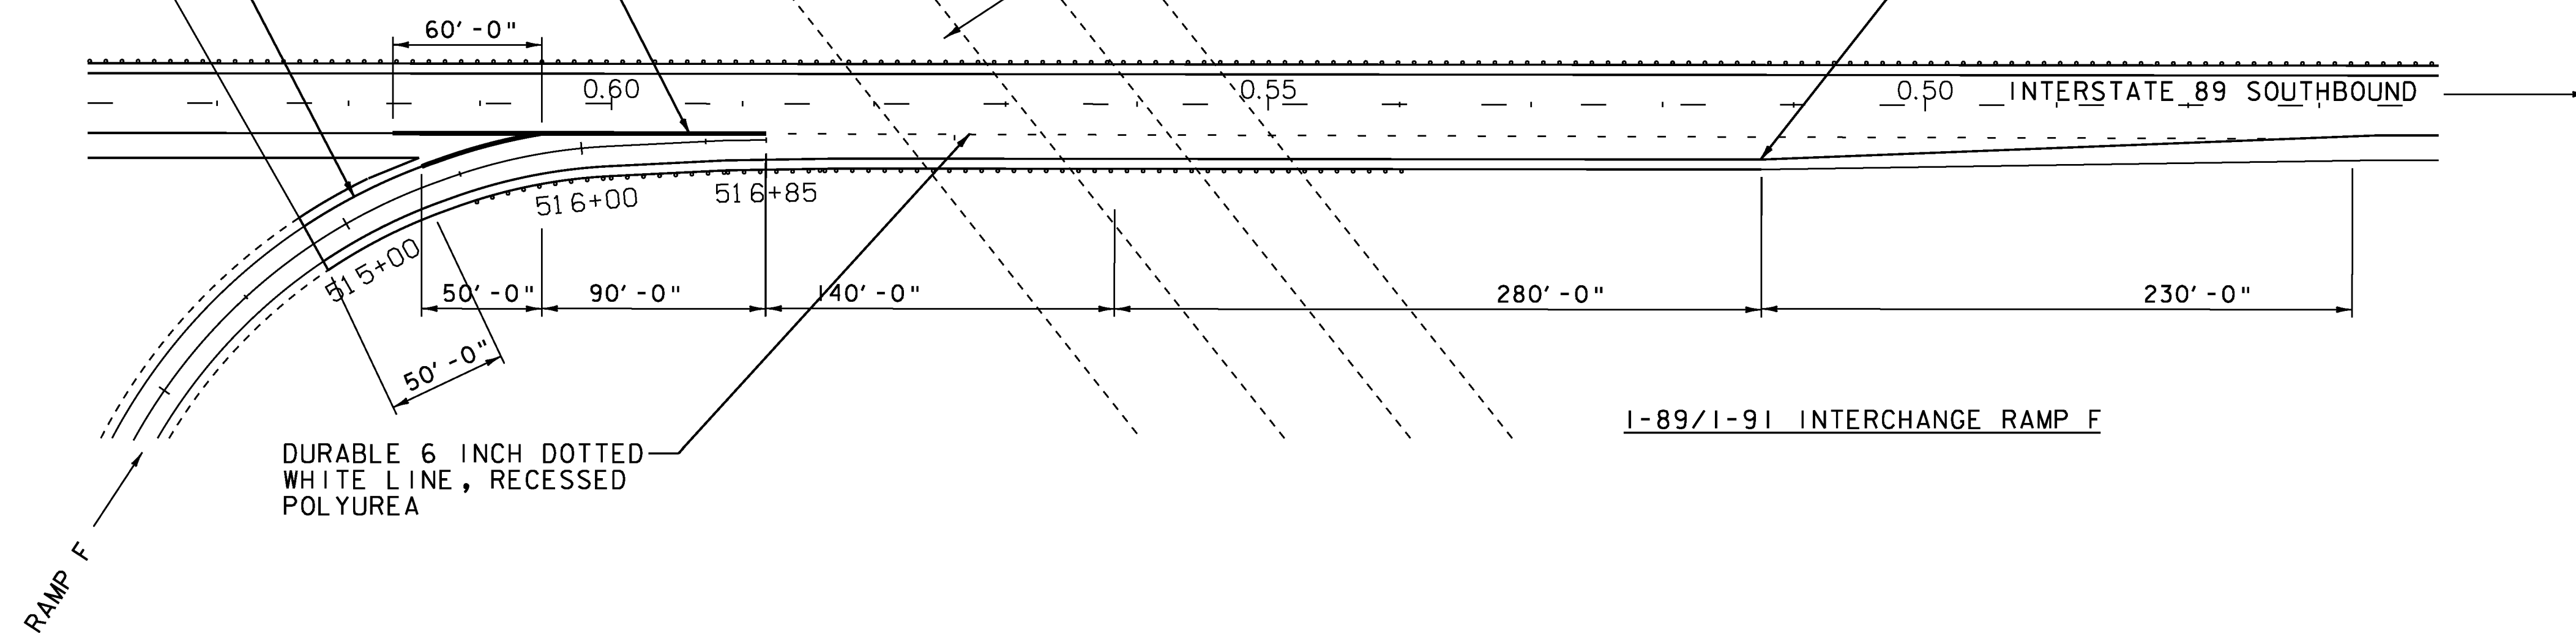

BRIDGES 4 AND 5 CROSS OVER 189

I-89/I-91 INTERCHANGE RAMP F

**NOTE:**

- ALL SIGNS ARE TO BE RETAINED UNLESS OTHERWISE INDICATED

NOT TO SCALE

**I-89/I-91 INTERCHANGE**  
**RAMP DETAIL SHEET 1**

PROJECT NAME: HARTFORD - SHARON  
 PROJECT NUMBER: IM 089-(157)

FILE NAME: 97A184.dgn  
 PROJECT LEADER: CDL  
 DESIGNED BY: JDM  
 PLOT FILE: 97A184.25.1

PLOT DATE: 8/6/2010  
 DRAWN BY: JDM  
 CHECKED BY: EPD  
 SHEET 25 OF 62