


NOTE
 1. ELEVATIONS SHOWN TO THE NEAREST TENTH ARE EXISTING GROUND
 ELEVATIONS SHOWN TO THE NEAREST HUNDRETH ARE PROPOSED GROUND

DATUM
 VERTICAL NAVD 88 (GPS DERIVED)
 HORIZONTAL NAD 83 (GPS DERIVED)

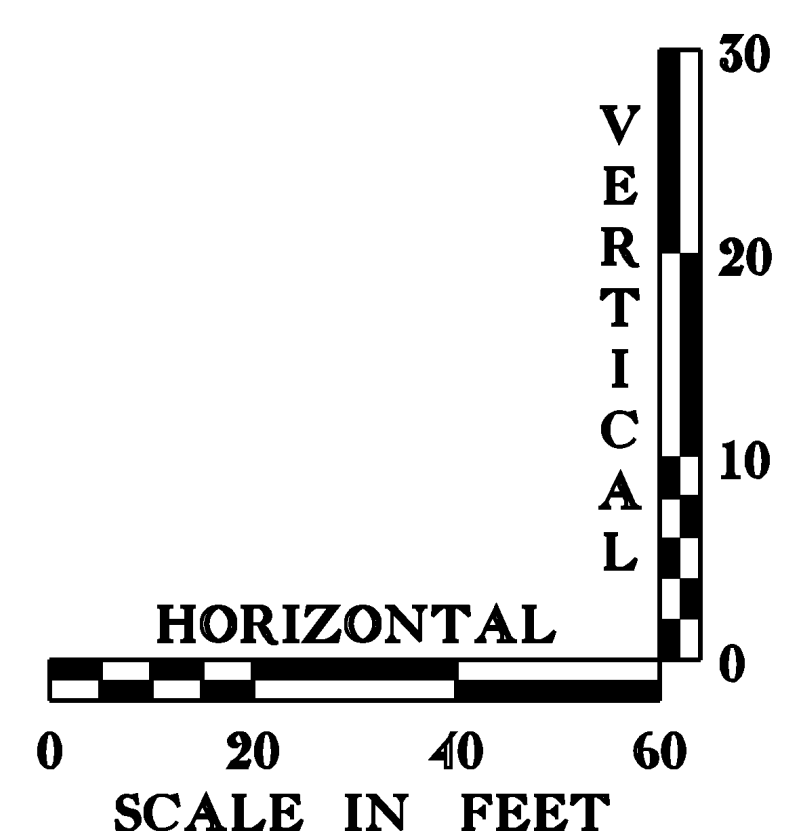

PLOTTED 8/6/2010

ROADWAY RECONSTRUCTION PROFILE	PROJECT NAME: HARTFORD - SHARON	PLOT DATE: 8/6/2010
	PROJECT NUMBER: IM 089-(157)	DRAWN BY: SJL
	FILE NAME: 97A184.dgn	CHECKED BY: EPD
	DESIGNED BY: SJL	SHEET 32 OF 62
	PLOT FILE: 97A184_32.1	