


MAINLINE TYPICAL SECTION

MM 12.245 - MM. 17.505

MIRROR IMAGE FOR SOUTHBOUND LANES

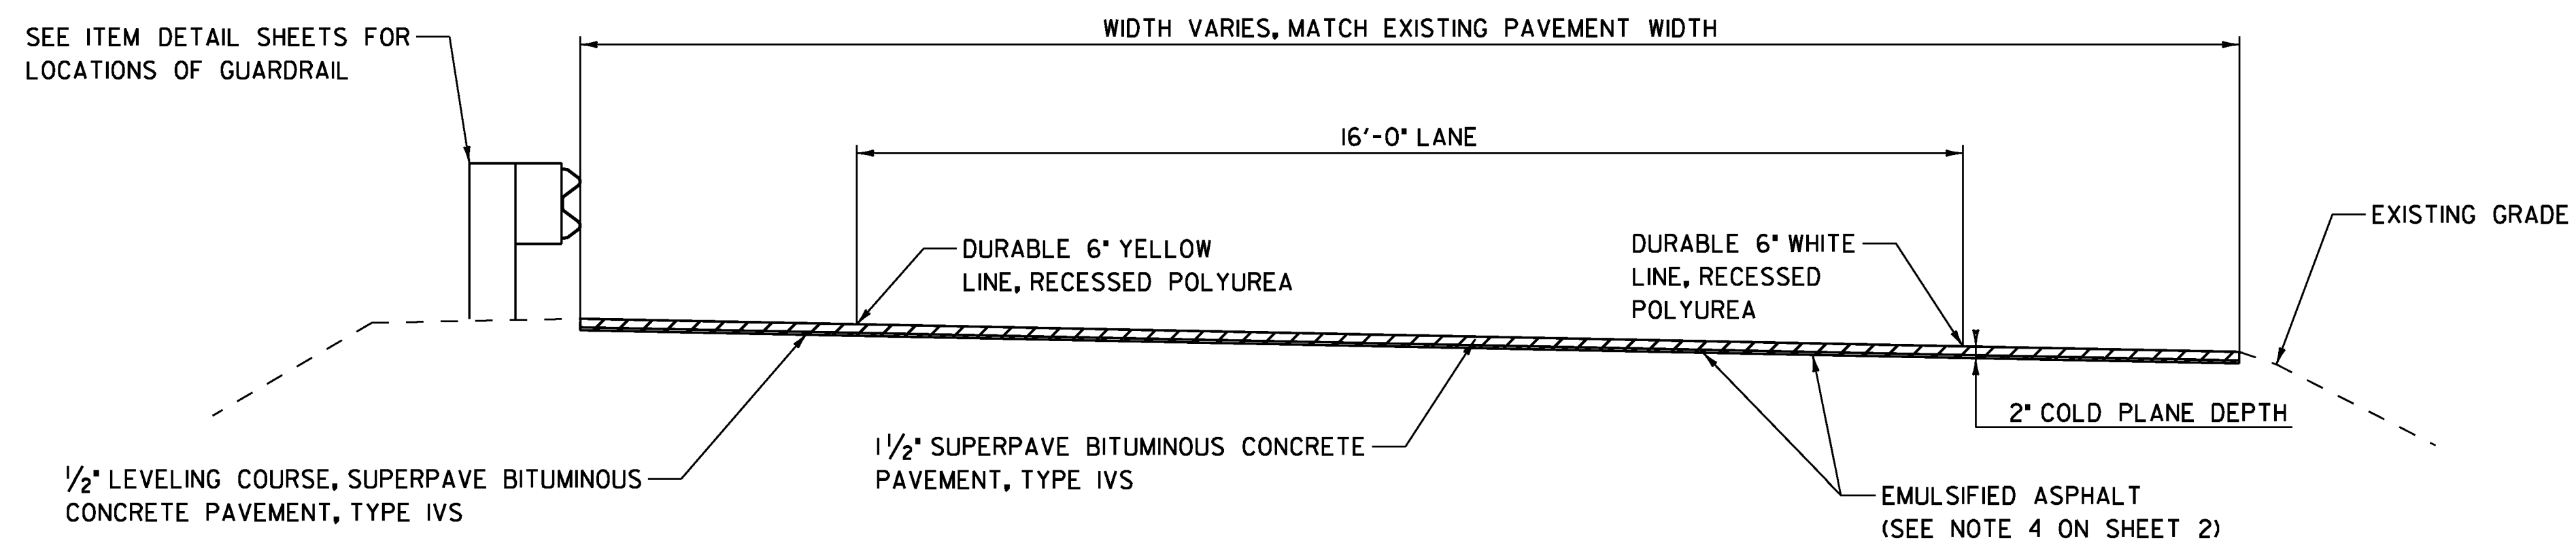

RAMP TYPICAL SECTION

NOT TO SCALE

PROJECT TYPICAL SHEET	PROJECT NAME: SHARON - ROYALTON
	PROJECT NUMBER: IM 089-1(58)
	FILE NAME: 97A184.dgn
	PLOT DATE: 8/6/2010
	PROJECT LEADER: CDL
	DESIGNED BY: SJL
	PLOT FILE: 97A184_43.1
	DRAWN BY: SJL
	CHECKED BY: EPD
	SHEET 43 OF 62