


**INTERSTATE ROUTE 89  
SOUTHBOUND  
MM 12.245  
BEGIN PROJECT IM 089-1(58)**

**INTERSTATE ROUTE 89  
SOUTHBOUND  
MM 17.505  
END PROJECT IM 089-1(58)**

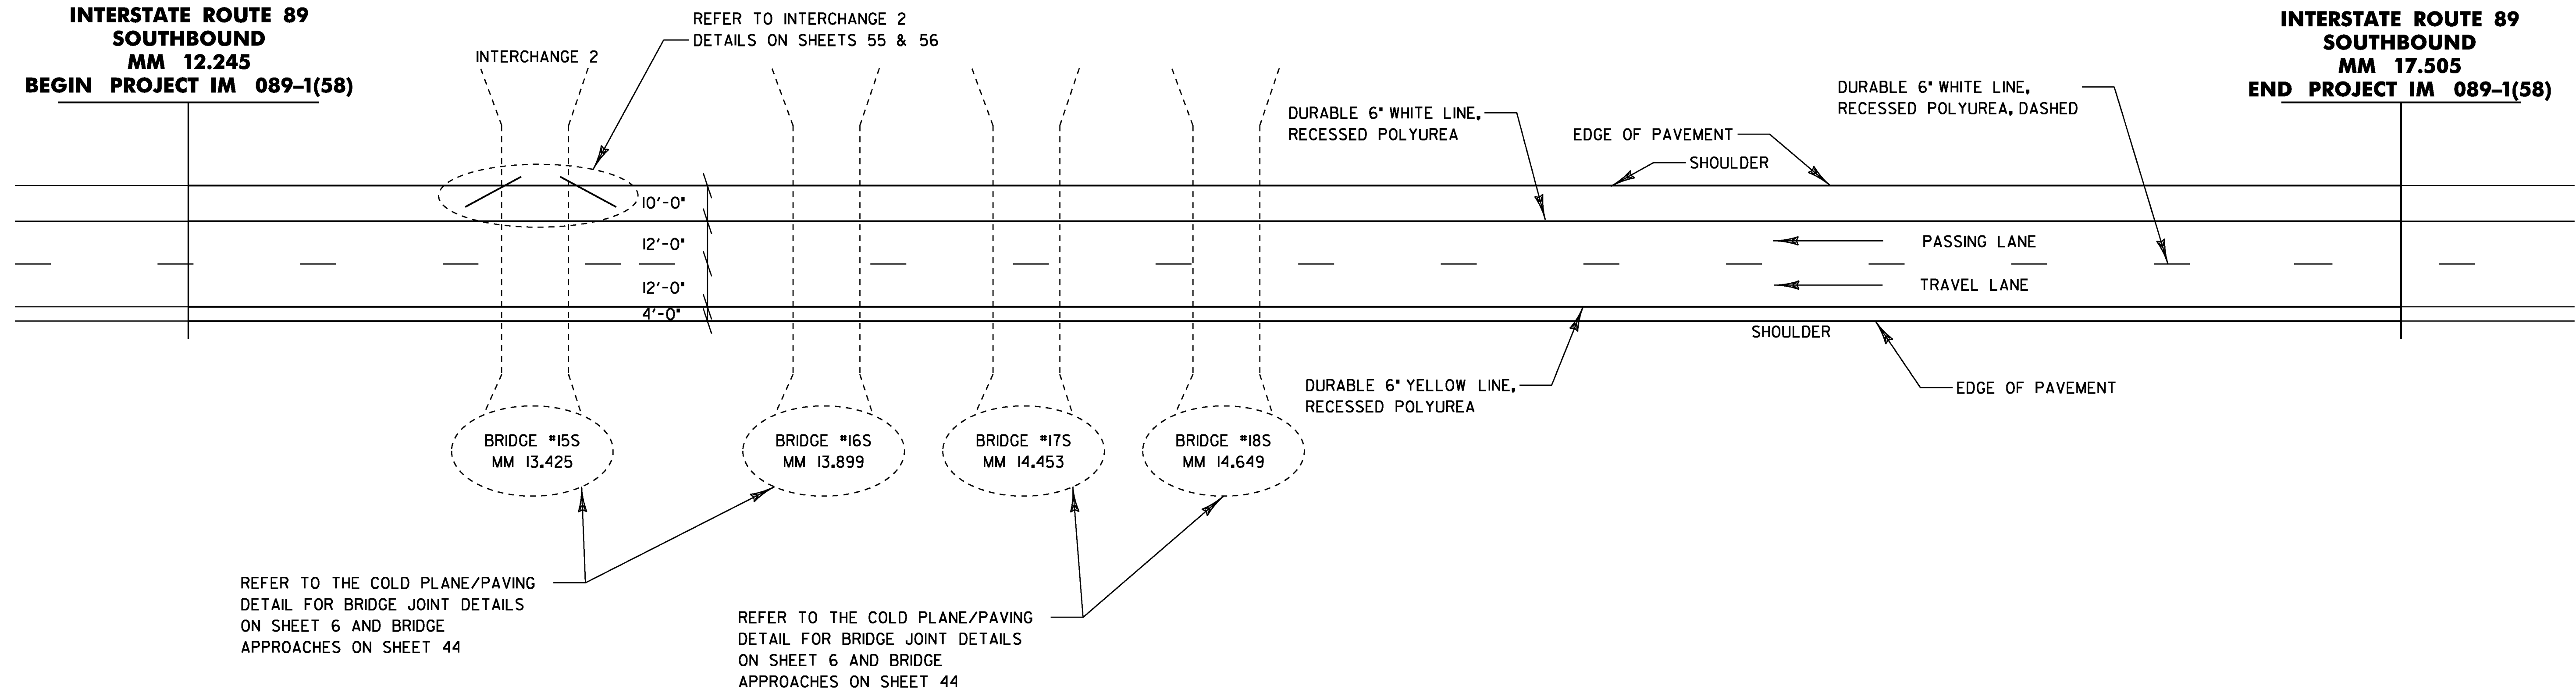

604.40 CHANGING ELEVATION OF DROP INLETS,  
CATCH BASINS, OR MANHOLES  
MM 15.188 IN PAVEMENT

604.412, 604.415, 604.418 REHABILITATION OF D.I.,  
CB OR MH, CLASS I, CLASS II, AND CLASS III

MM. 12.375	IN PAVEMENT	MM. 13.346	IN PAVEMENT
MM. 12.431	IN PAVEMENT	MM. 13.454	IN PAVEMENT
MM. 12.479	IN PAVEMENT	MM. 13.837	IN PAVEMENT
MM. 12.526	IN PAVEMENT	MM. 13.852	IN PAVEMENT
MM. 12.583	IN PAVEMENT	MM. 13.951	IN PAVEMENT
MM. 12.725	IN PAVEMENT	MM. 15.021	IN PAVEMENT
MM. 12.782	IN PAVEMENT	MM. 15.086	IN PAVEMENT
MM. 12.839	IN PAVEMENT	MM. 16.962	IN PAVEMENT
MM. 12.886	IN PAVEMENT	MM. 17.000	IN PAVEMENT
MM. 12.961	IN PAVEMENT	MM. 17.033	IN PAVEMENT
MM. 13.037	IN PAVEMENT	MM. 17.076	IN PAVEMENT
MM. 13.102	IN PAVEMENT	MM. 17.113	IN PAVEMENT
MM. 13.194	IN PAVEMENT	MM. 17.171	IN PAVEMENT
		MM. 17.199	IN PAVEMENT

646.426 DURABLE 6 INCH WHITE LINE, RECESSED POLYUREA  
MM 12.245 - MM 17.505 CENTERLINE (DASHED)  
MM 12.245 - MM 13.109 OUT (SOLID)  
MM 13.234 - MM 13.584 OUT (SOLID)  
MM 13.693 - MM 17.505 OUT (SOLID)

646.436 DURABLE 6 INCH YELLOW LINE, RECESSED POLYUREA  
MM 12.245 - MM 17.505 MED (SOLID)

646.622 TEMPORARY 6 INCH WHITE LINE, PAINT  
MM 12.245 - MM 17.505 CENTERLINE (DASHED)  
MM 12.245 - MM 13.109 OUT (SOLID)  
MM 13.234 - MM 13.584 OUT (SOLID)  
MM 13.693 - MM 17.505 OUT (SOLID)

646.632 TEMPORARY 6 INCH YELLOW LINE, PAINT  
MM 12.245 - MM 17.505 MED (SOLID)

**NOT TO SCALE**

<b>SOUTHBOUND PAVING PROJECT LAYOUT SHEET</b>	PROJECT NAME: SHARON - ROYALTON
	PROJECT NUMBER: IM 089-1(58)
	FILE NAME: 97A184.dgn
PROJECT LEADER: CDL	PLOT DATE: 8/6/2010
DESIGNED BY: SJL	DRAWN BY: SJL
PLOT FILE: 97A184_54.t	CHECKED BY: EPD
	SHEET 54 OF 62