



4594+50

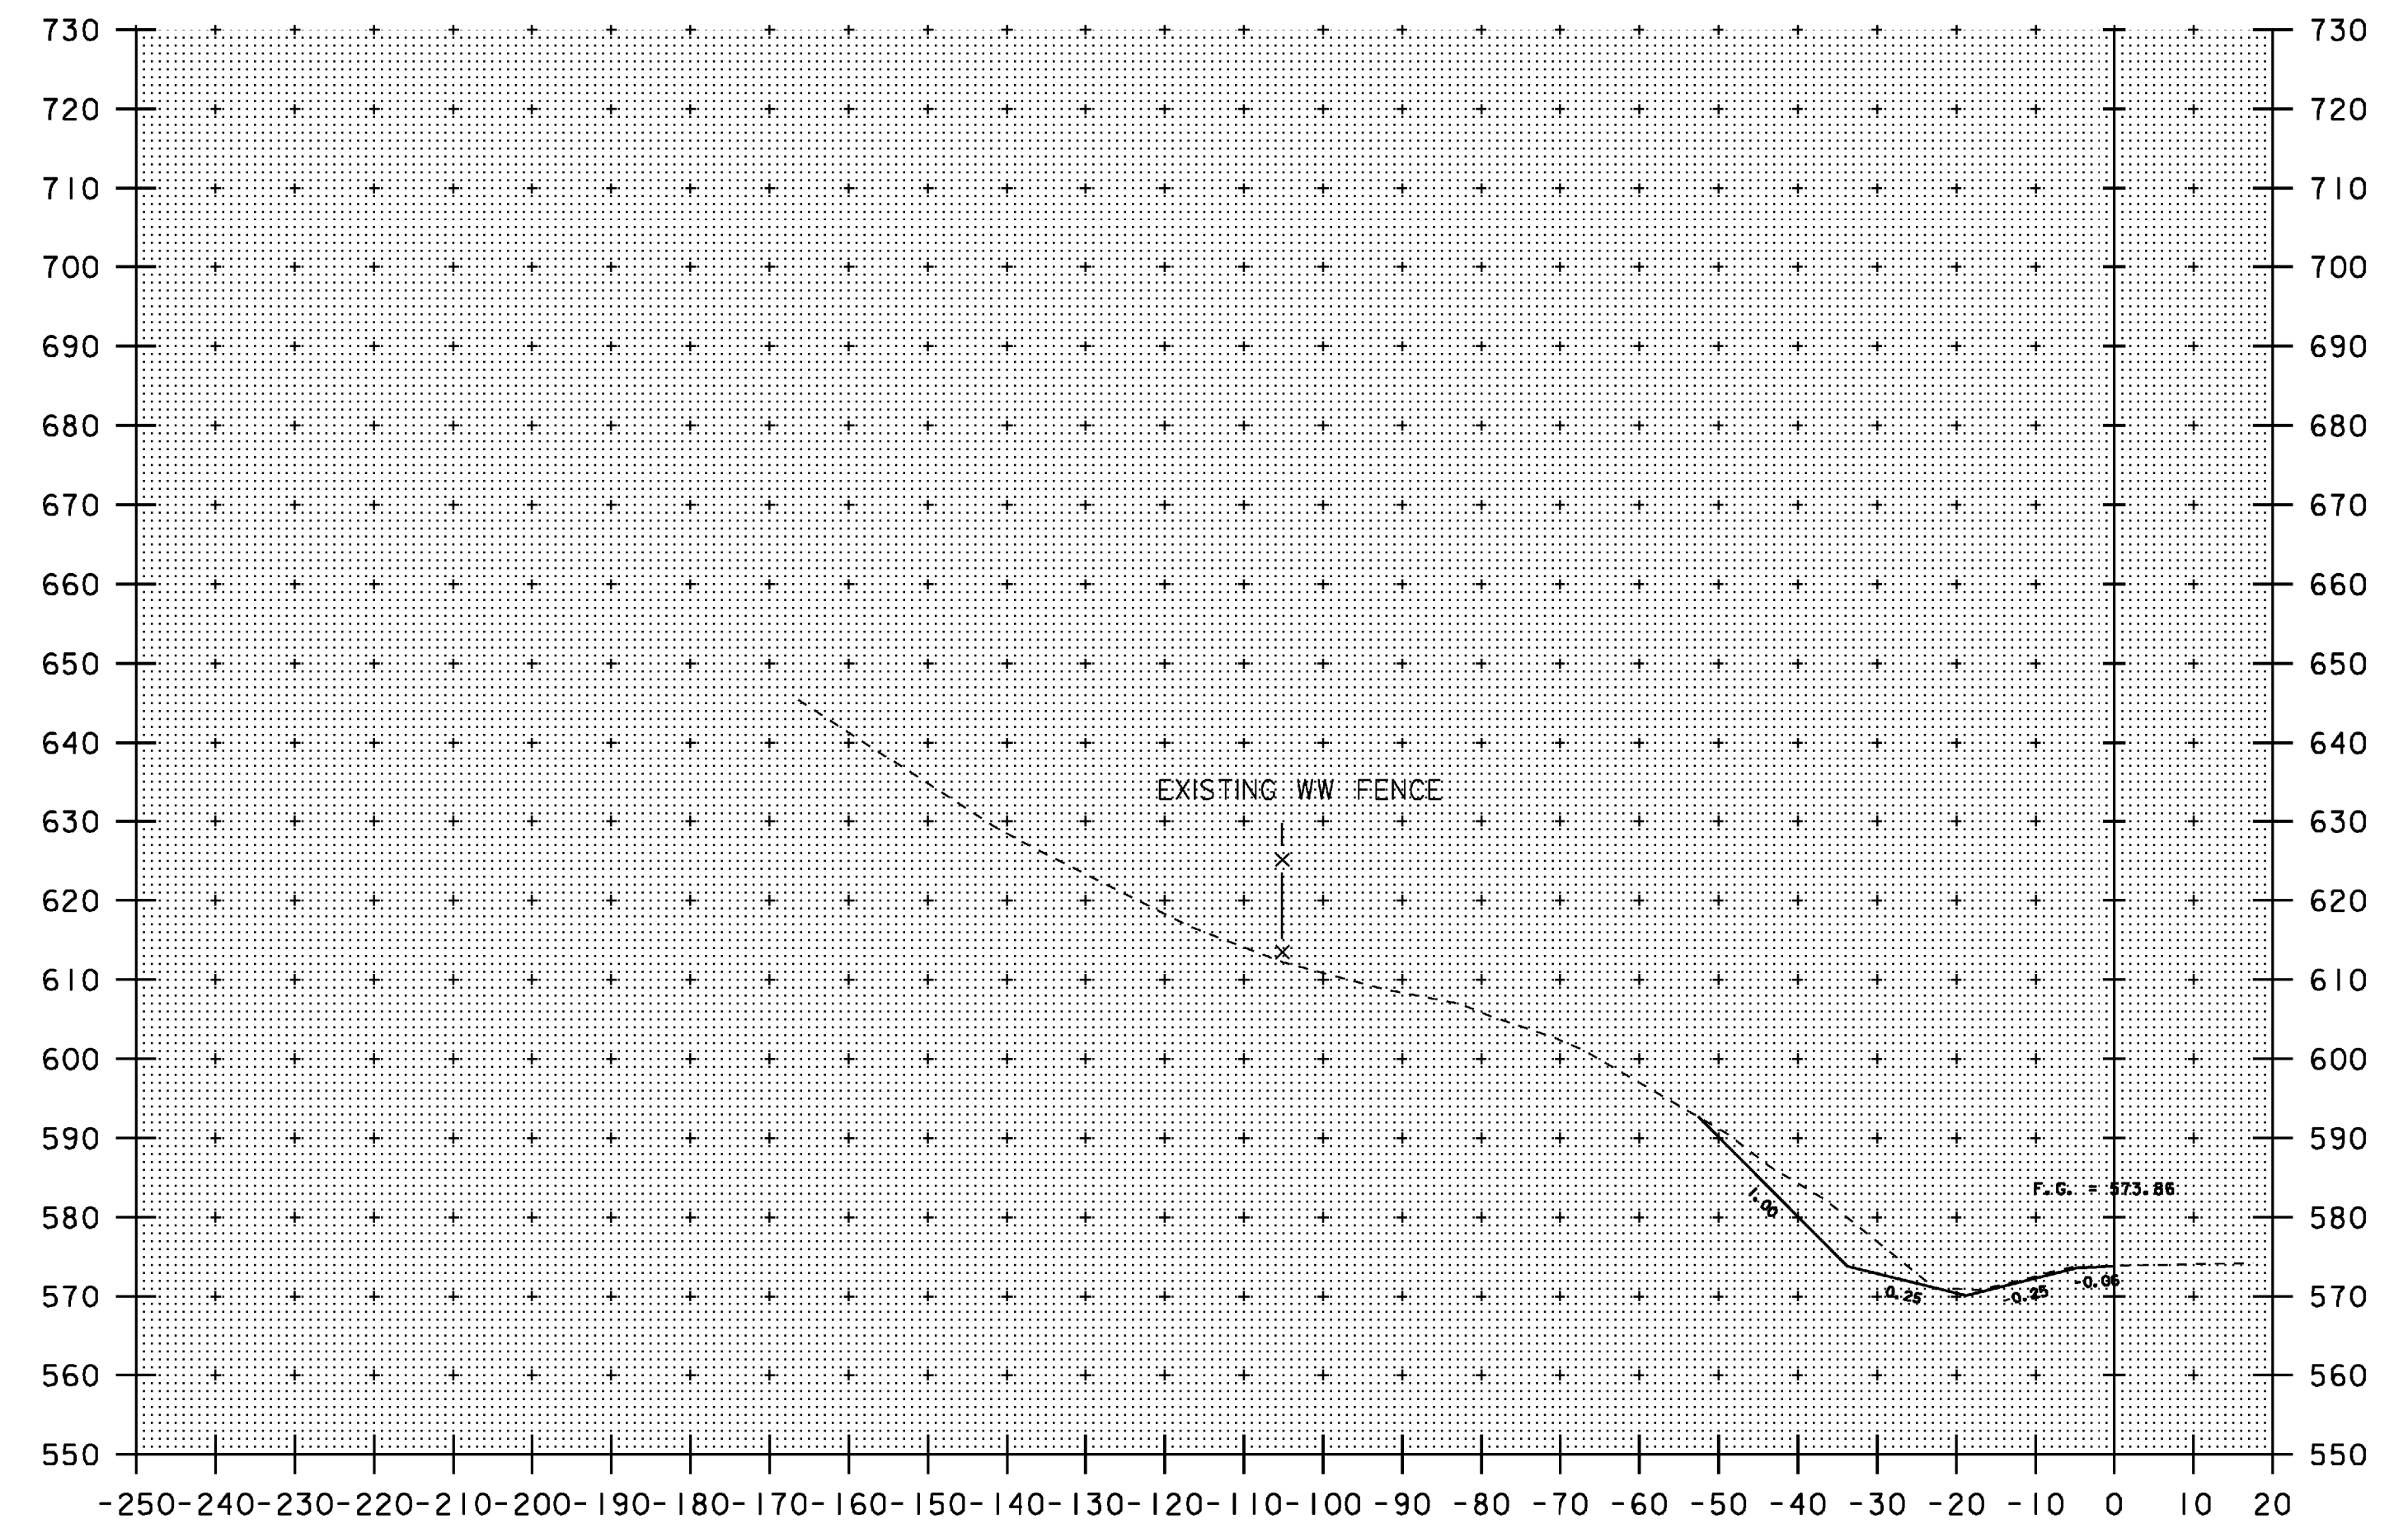

4595+00

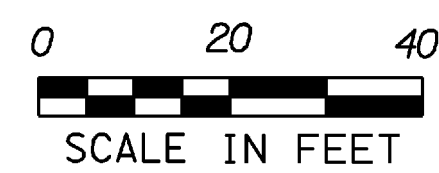

NOTE: ALIGNMENT IS THE CENTER OF THE SHOULDER LINE AND EDGE OF PAVEMENT.

MM 86.63 - MM 86.75

FOR FINAL SECTIONS
SEE FOLDER/ENVELOPE
LABELED "CROSS SECTIONS"

SOUTHBOUND CROSS SECTIONS #1

| | | | |
|------------------|----------------------|-------------|---------------|
| PROJECT NAME: | HARTFORD - NEWBURY | | |
| PROJECT NUMBER: | IM 09I-2(72) | | |
| FILE NAME: | d99a052_bdr_xs.dgn | PLOT DATE: | 2I-JUL-2009 |
| PROJECT LEADER: | K. UPMAL | DRAWN BY: | N. PAPPAS |
| DESIGNED BY: | N. PAPPAS | CHECKED BY: | ART BOMBARIER |
| IPARM FILE NAME: | d99a052_bdr_xs_sb_0I | SHEET | 30 OF 45 |