


4604+50

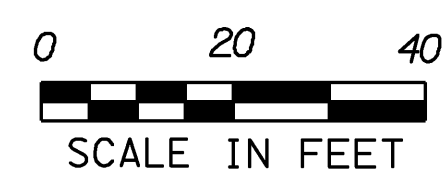

NOTE: ALIGNMENT IS THE CENTER OF THE SHOULDER LINE AND EDGE OF PAVEMENT.

MM 86.63 - MM 86.75

SOUTHBOUND CROSS SECTIONS #II

PROJECT NAME: HARTFORD - NEWBURY		PLOT DATE: 21-JUL-2009	
PROJECT NUMBER: IM 091-2(72)		DRAWN BY: N. PAPPAS	
FILE NAME: d99a052_bdr_xs.dgn	DESIGNED BY: N. PAPPAS	CHECKED BY: A. BOMBARDIER	SHEET 40 OF 45
IPARM FILE NAME: d99a052_bdr_xs_sb_II			