

TEMPORARY AND DURABLE 150mm WHITE LINE  
 EXIT 24  
 NORTHBOUND OFF RAMP "C" SOLID RT ✓  
 NORTHBOUND OFF RAMP "C" DOTTED RT ✓  
 NORTHBOUND ON RAMP "D" SOLID RT ✓  
 NORTHBOUND ON RAMP "D" DASHED LANE LINE ✓

REMOVING SIGNS  
 6 ✓



TEMPORARY AND DURABLE 150mm YELLOW LINE  
 EXIT 24  
 NORTHBOUND OFF RAMP "C" SOLID LT ✓  
 NORTHBOUND ON RAMP "D" SOLID LT ✓

TEMPORARY AND DURABLE 300mm WHITE LINE  
 EXIT 24  
 NORTHBOUND OFF RAMP "C" SOLID LT ✓  
 NORTHBOUND ON RAMP "D" SOLID LT ✓

DURABLE 300mm YELLOW LINE  
 EXIT 24  
 NORTHBOUND OFF RAMP "C" @ RT I22 SOLID LT ✓

TEMPORARY AND DURABLE LETTER OR SYMBOL  
 EXIT 24  
 NORTHBOUND OFF RAMP "C" "STOP AHEAD" ✓  
 NORTHBOUND OFF RAMP "C" @ RT I22 "STOP" ✓ (DURABLE ONLY)

TEMPORARY AND DURABLE 600mm STOP BAR  
 EXIT 24  
 NORTHBOUND OFF RAMP "C" @ RT I22 ✓

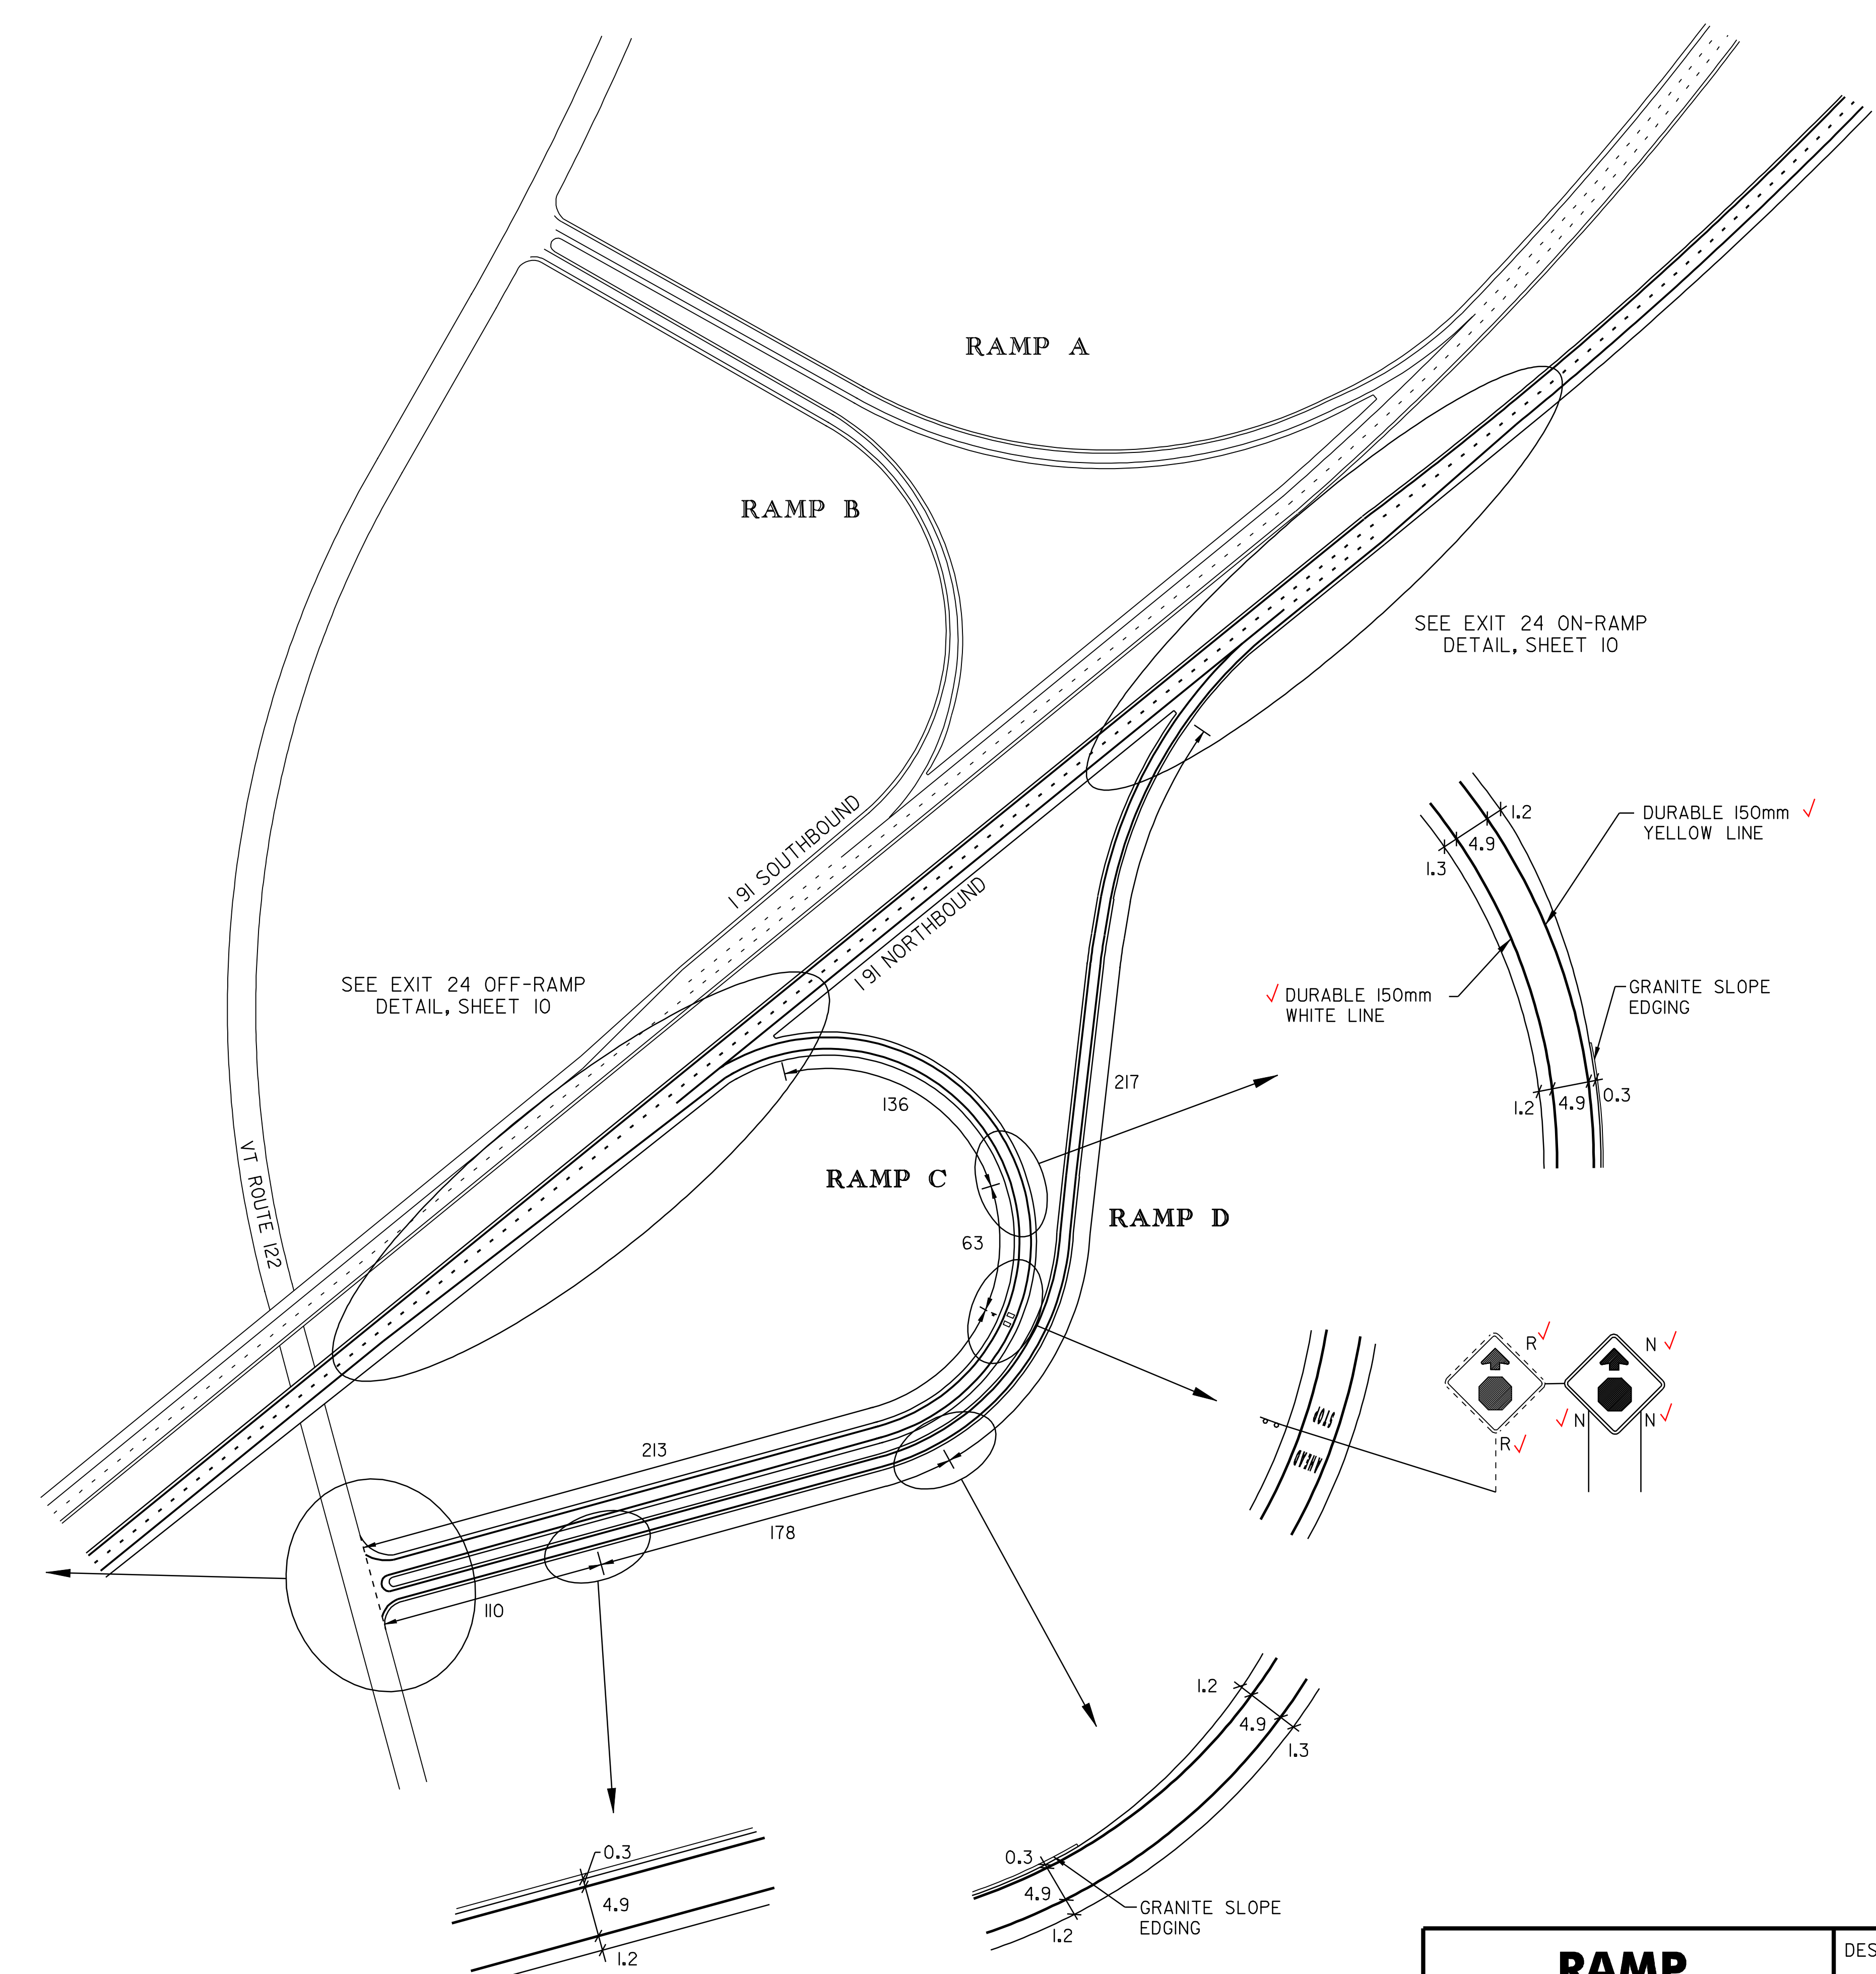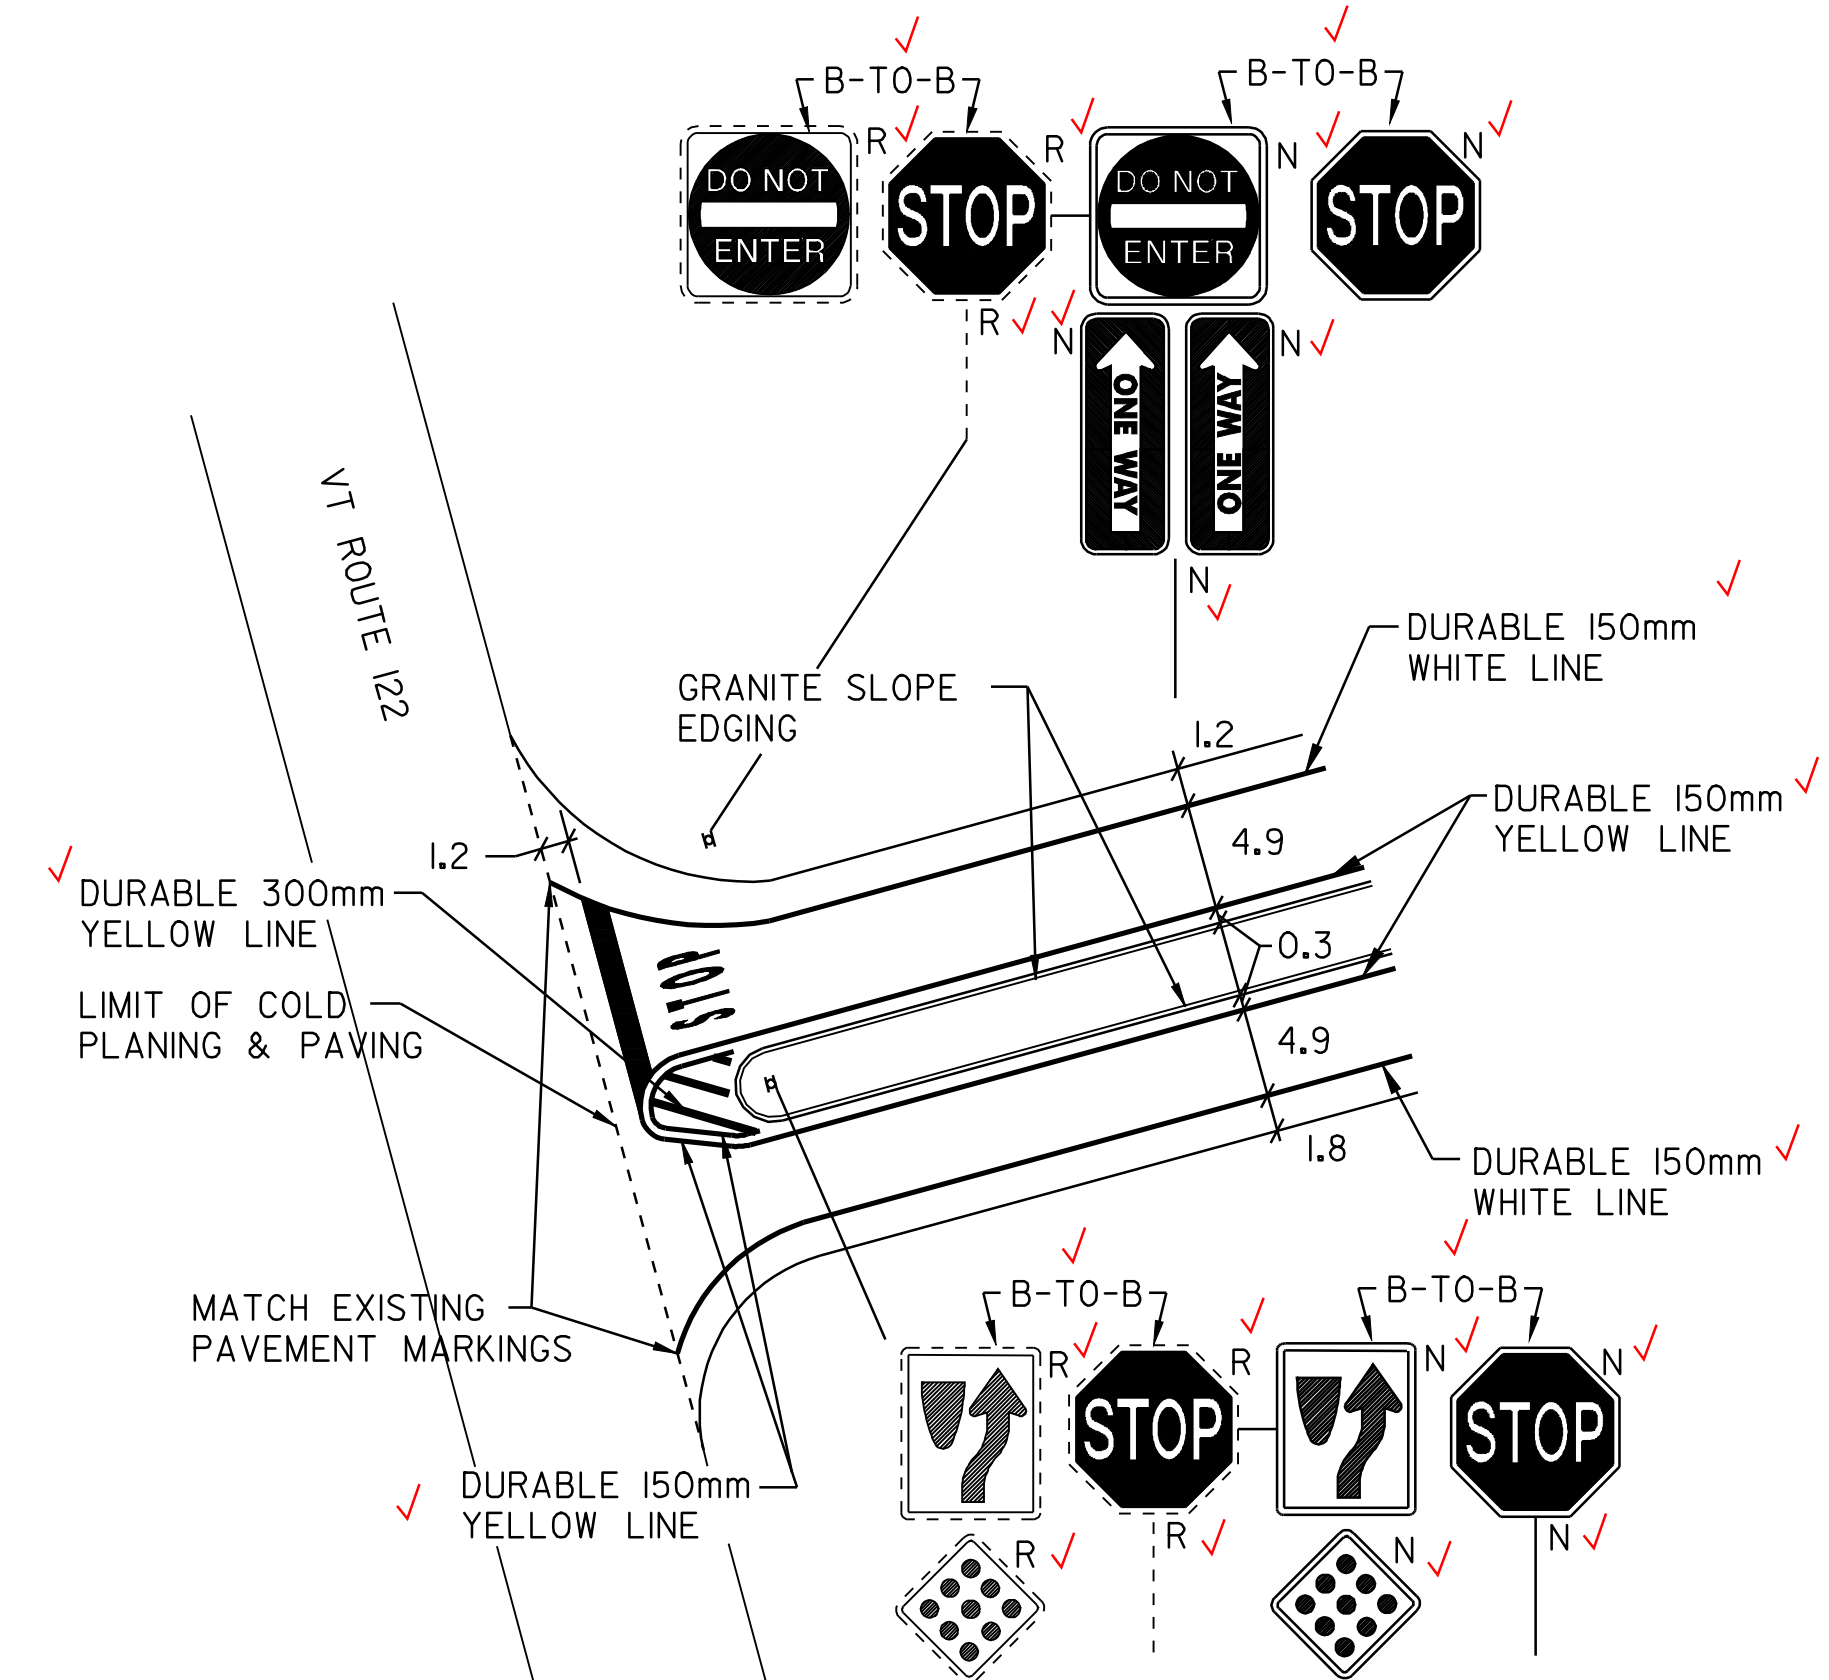

**ARCHIVED  
 IN DPR**

**RAMP  
 DETAIL  
 SHEET  
 INTERCHANGE  
 #24**



DESIGNED BY	BCE/PJM	DATE	9-00
DRAWN BY	C.E.A., INC.	DATE	9-00
DESIGN FILE NO.	/pave/99a204/pa204.dgn		
PRF FILE	pa204i03.1	DATE PLOTTED	09-APR-2008 15:43
PROJ. NAME	LYNDON - BARTON		
PROJ. NO.	IM 091 - 3(10)		
SHEET	9	OF	17 SHEETS

NOTE: ALL DIMENSIONS IN METERS UNLESS OTHERWISE NOTED.  
 REFER TO STANDARDS E-191M & E-192M FOR ADDITIONAL DETAILS.