



EXIT 24 OFF-RAMP DETAIL

TYPICAL GORE MARKINGS DIMENSIONS

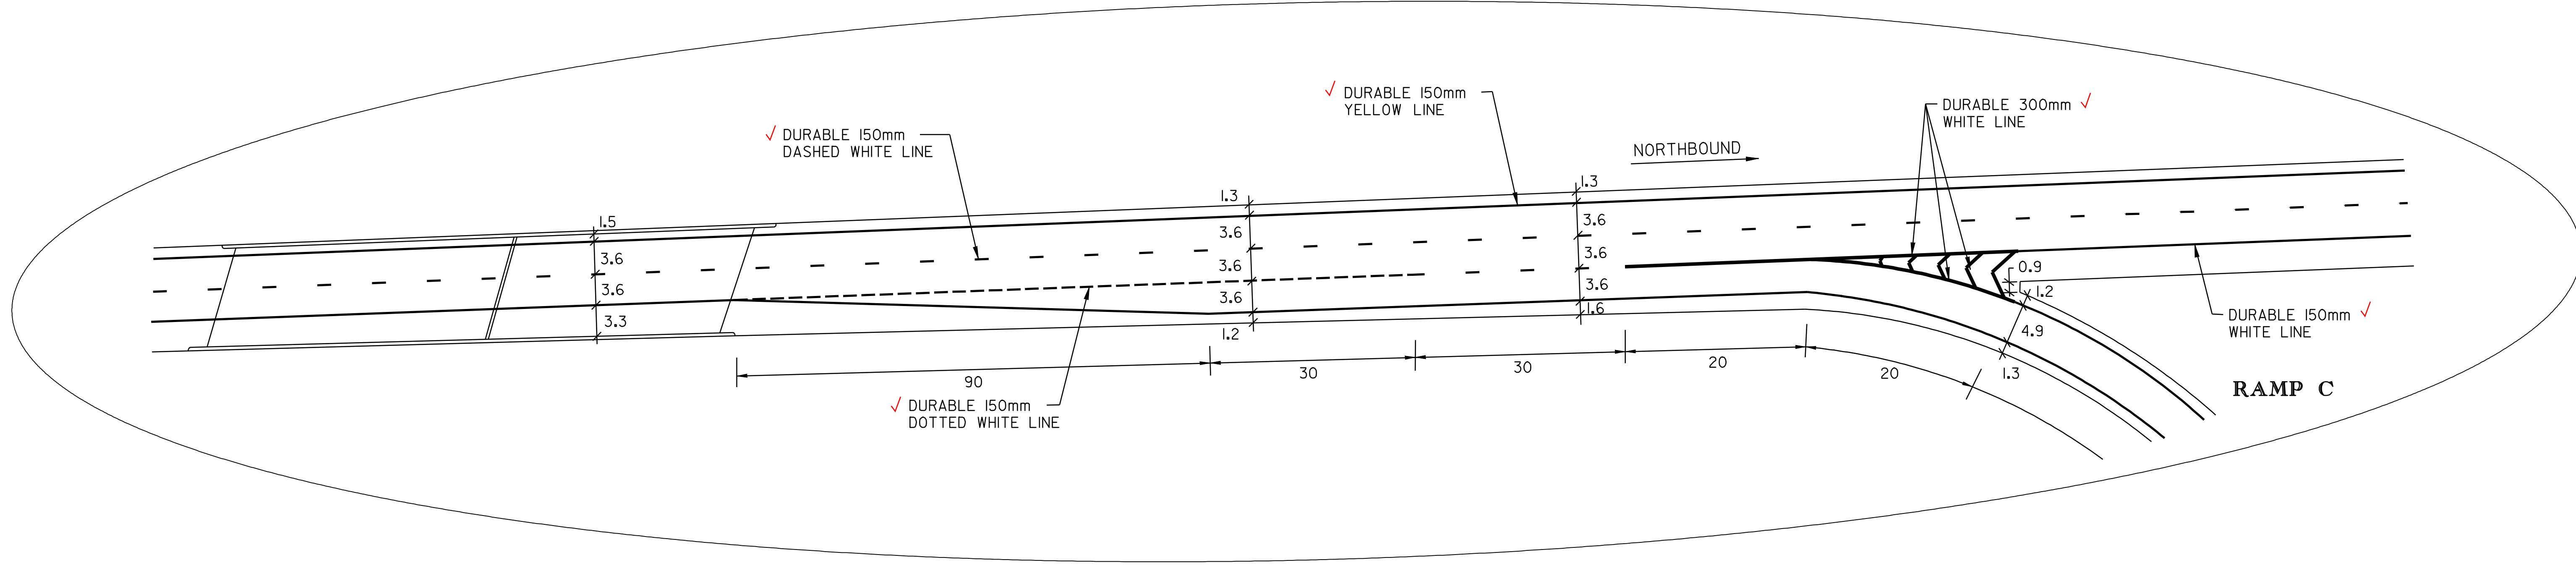

EXIT 24 ON-RAMP DETAIL

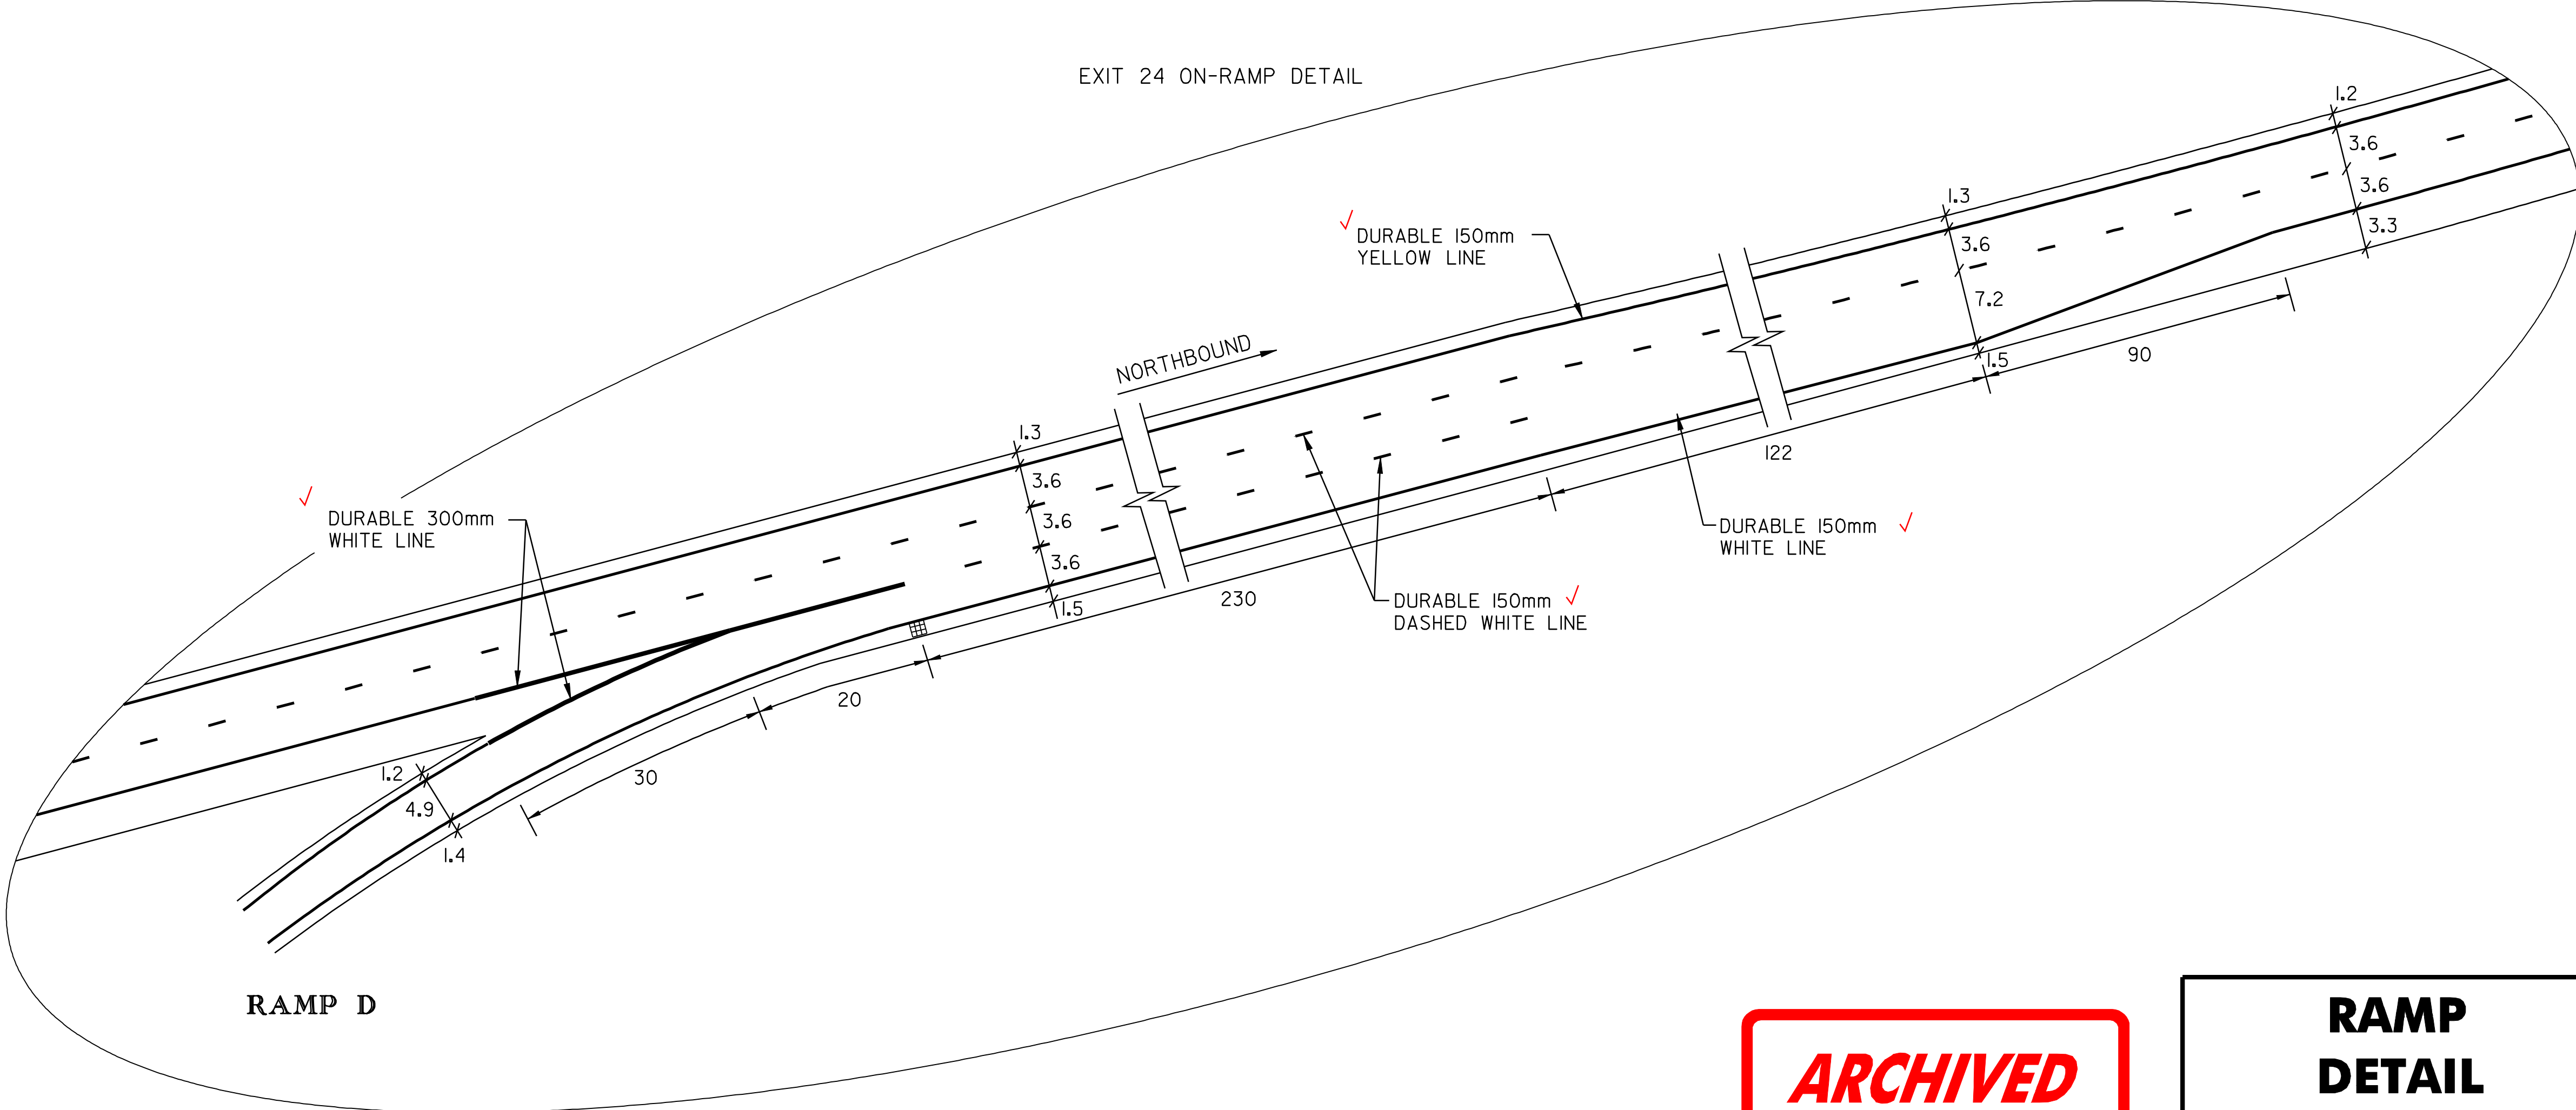

NOTE: ALL DIMENSIONS IN METERS UNLESS OTHERWISE NOTED.  
REFER TO STANDARDS E-191M & E-192M FOR ADDITIONAL DETAILS.

**ARCHIVED  
IN DPR**

**RAMP  
DETAIL  
SHEET  
INTERCHANGE  
#24**



DESIGNED BY	BCE/PJM	DATE	9-00
DRAWN BY	C.E.A., INC.	DATE	9-00
DESIGN FILE NO.	/pave/99a204/pa204.dgn		
PRF FILE	pa204i04.i	DATE PLOTTED	05-APR-2008 15:44
PROJ. NAME	LYNDON - BARTON		
PROJ. NO.	IM 091 - 3(10)		
SHEET	10	OF	17 SHEETS